


Survey made for Lena Lee Unkle 11/11/40 to obtain a correct description of lands.

H. H. Uhl  
Reg. Surveyor.

R - T - QR. - LOT  
7 - 9 - 1<sup>ST</sup> - 48

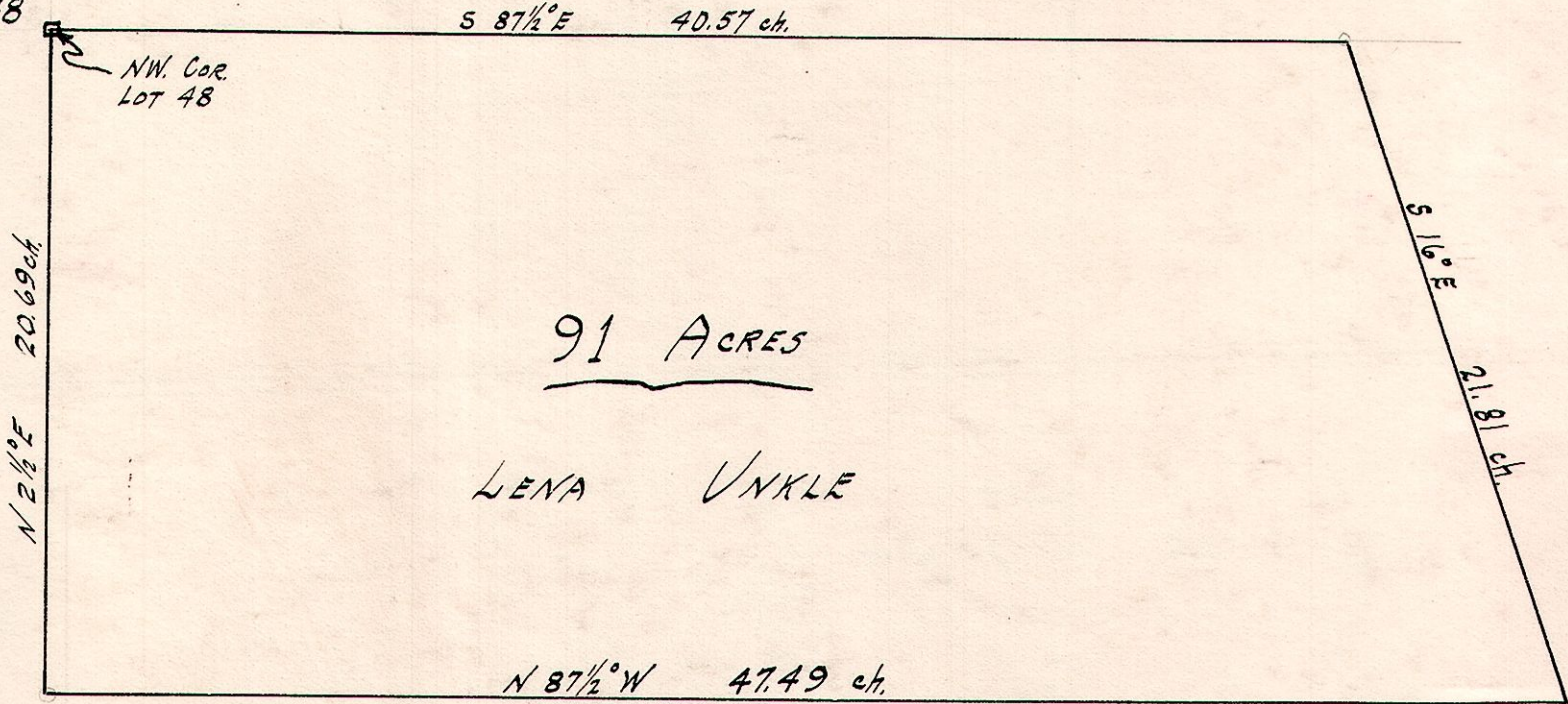

R - T - SEC. - QR.  
7 - 9 - 12 - SW.

