16

Sections 3 & 4 Tp. 10 Range 6

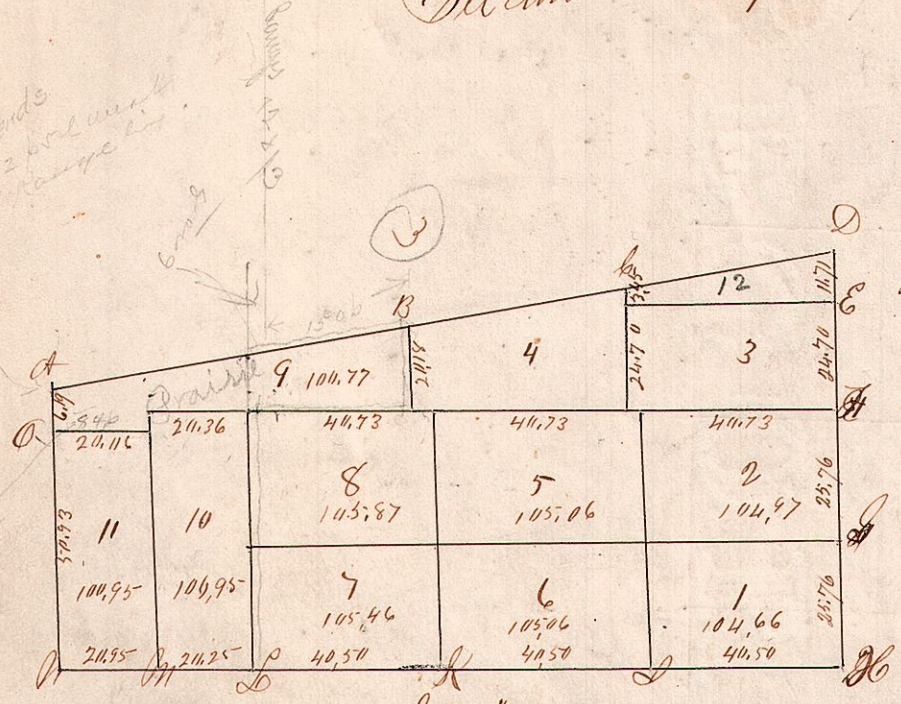

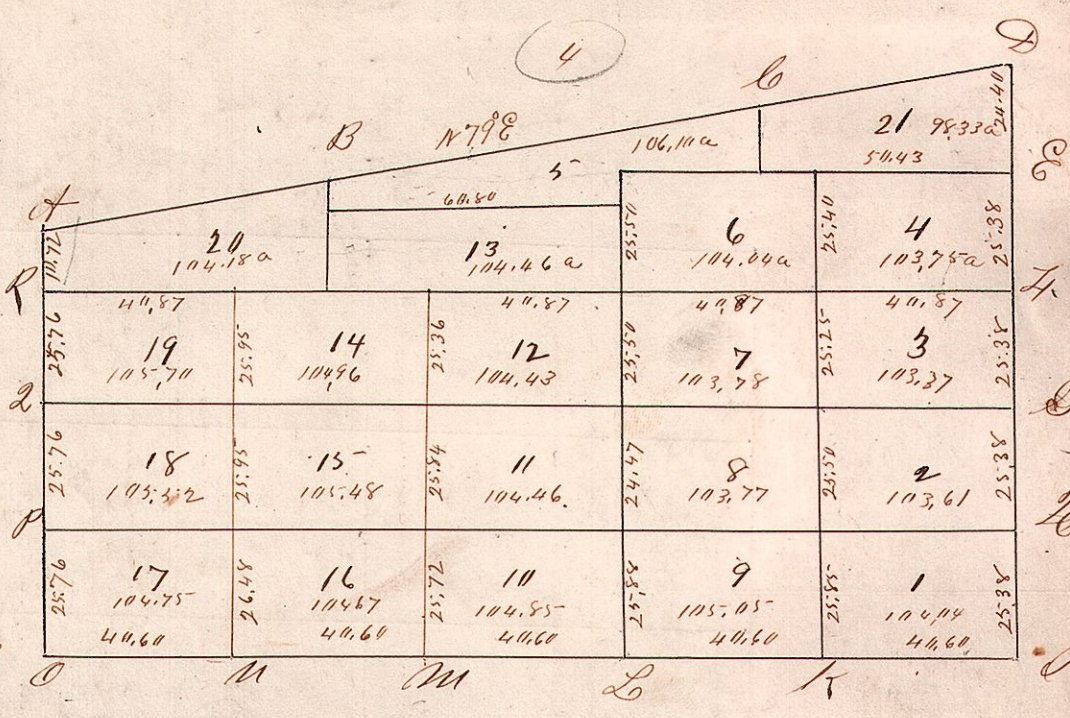

Sec 3

Point	Bearings	Trees	Chains	Courses	Links
A					
B	W Oak	18	N 78 E	34	
"	do	13	N 37 W	33	
C	do	7	S 22 W	11	
"	Cherry	11	N 84 E	12	
D	B Oak	24	S 12 E	20	
"	W Oak	26	N 12 W	35	
E	W Oak	14	S 79 W	23	
"	Cherry	12	N 81 E	36	
F	Hickory	9	N 15 W	12	
"	do	6	S 38 E	3	
G	Sugar	11	S 18 W	20	
"	Hickory	12	N 71 W	10	
H					
I	Hickory	8	S 89 E	18	
"	Dogwood	6	S 20 E	7	
K	Hickory	10	S 73 W	13	
"	do	12	S 17 E	7	
L	Chest	24	S 83 E	5	
"	W Oak	13	S 38 W	23	
M	Ash	7	N 20 E	10	
"	Elm	8	S 87 E	31	
N					
O	Hickory	14	N 18 E	8	
"	Gum	5	S 75 E	8	
1	Linn	10	N 55 E	47	
"	W Oak	8	S 3 W	57	
2	W Beech	5	N 68 E	5	
"	Ironwood	7	N 27 W	23	
3	W Oak	11	S 75 W	13	
"	Ironwood	9	S 49 E	8	
4	W Oak	13	N 66 E	15	
"	B Oak	16	N 82 W	24	
5	Hickory	13	South	8	
"	W Oak	14	S 79 W	29	
6	Hickory	10	S 76 E	32	
"	Dogwood	6	N 82 W	32	
7	W Oak	15	N 28 W	17	
"	do	30	S 40 W	15	
8	Ash	8	S 48 W	18	
"	Elm	10	S 6 E		
9	Dogwood	7	N 64 W	24	
"	B Walnut	5	N 63 E	33	
1.2.5.6	Maple	8	South	36	
"	W Oak	27	S 76 W	37	
5.6.7.8	B Walnut	15	S 18 E	22	
"	W Oak	24	N 8 W	41	

Sec 4"

Point	Bearings	Trees	Chains	Courses	Links
P	Sugar	15	S 39 W	11	
"	Hickory	14	N 34½ W	15	
Q	Cratagus	5	N 71 E	7	
"	do	5	S 86 W	27	
R	W Oak	12	S 35 W	20	
"	do	15	N 87 W	20	
3.4.6.7	W Oak	14	S 74½ E	13	
"	Maple	9	N 80½ W	33	
6.7.12.13	W Oak	18	S 7 W	20	
"	Hickory	12	N 16 E	23	
12.14	W Oak	10	N 79½ E	9	
"	Crab Apple	5	N 17 W	16	
13.20	Ironwood	5	S 20 E	14	
"	Elm	6	N 5 E	43	
14.19	Ironwood	6	N 7½ E	6	
"	B Jack	7	N 56 W	36	
15.16.17.18	Cherry	8	N 57 E	10	
"	do	12	S 59½ W	34	
14.15.18.19	Hickory	15	S 46 E	15	
"	Sugar	27	N 37 W	14	
10.11.15.16	B Oak	14	N 44 W	26	
"	do	5	S 26½ W	13	
11.12.14.15	W Oak	16	N 11½ E	28	
"	Maple	10	S 3½ W	12	
8.9.10.11	Elm	8	S 67 E	10	
"	B Ash	10	N 41 W	40	
7.8.11.12	W Oak	10	N 11½ E	25	
"	Maple	8	S 8 W	23	
1.2.8.9.	Ash	9	S 30 W	4	
"	B Oak	8	N 27 E	13	
2.3.7.8	Hickory	8	S 85 E	13	
"	W Oak	48	N 24 W	32	
13.5.6	do	8	N 60 W	33	
"	Cherry	12	S 52 E	19	
6 W Cor	W Oak	36	N 33½ W	13	
"	do	24	S 81 E	43	
4.6	do	14	S 49 E	28	
"	do	36	S 87 W	36	
5 Three	do	26	N 62 E	11	
"	W Burr	6	S 22 W	29	
5.13.N	W Oak	12	S 9 W	18	
"	Hickory	7	N 22½ E	26	

Notes to Section No 4

Point	Bearings	Trees	Chains	Courses	Links
A	B Oak	24	S 12 E	20	
"	W Oak	26	N 12 W	35	
B	Maple	15	N 16½ W	19	
"	Ironwood	5	S 9½ E	20	
C	Hickory	8	S 27 W	19	
"	do	10	N 86 E	20	
D					
E	W Oak	18	N 2½ E	10	
"	do	24	S 4 E	42	
H	do	14	N 83½ W	22	
"	B Oak	18	S 79 E	12	
I	W Oak	36	N 5 W	87	
"	do	36	S 27½ E	34	
K	Sugar	24	East	13	
"					
L					
"					
K	Aspen	12	S 49½ W	58	
"	do	9	S 65½ E	80	
L	W Oak	30	S 5 E	8	
"	Hickory	6	N 1½ E	7	
M	W Oak	12	N 47 E	29	
"	Hickory	12	S 42½ W	38	
A	Maple	7	S 13 W	11	
"	Dogwood	8	N 21½ W	18	
O					
"					