


Section 2^d Township 9 Range 8

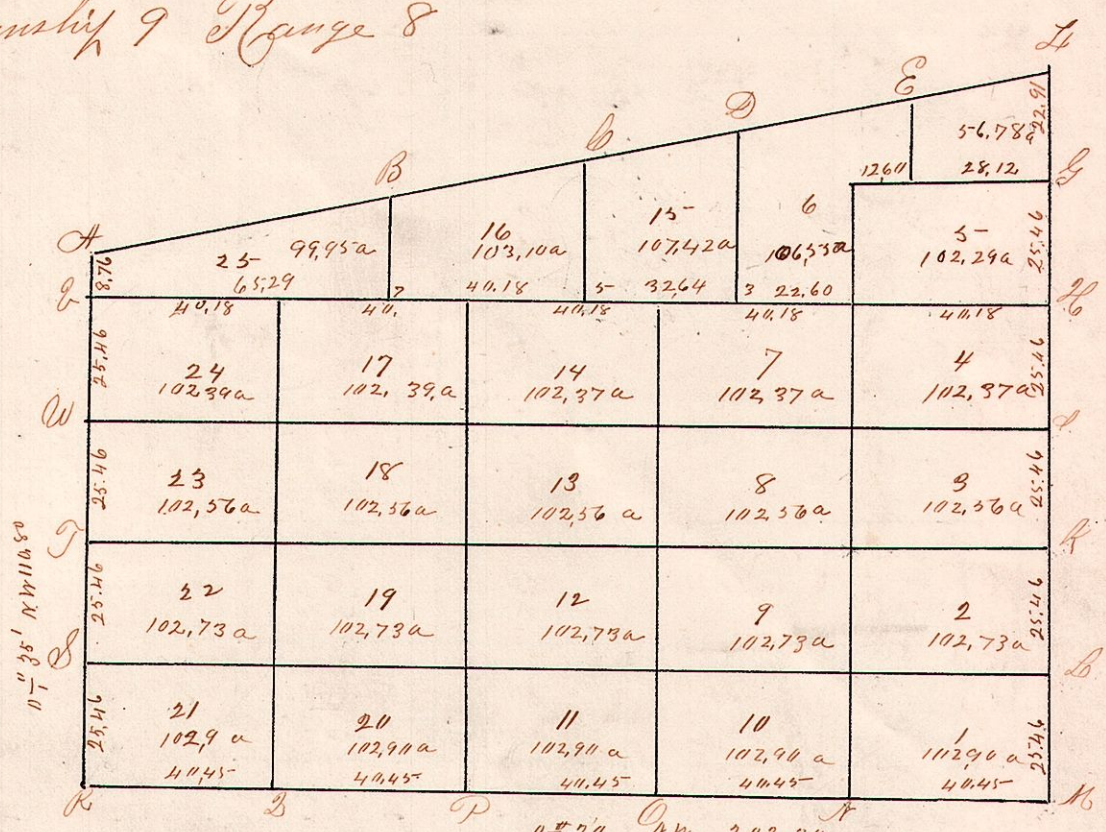

Post	Tree	diam	Corner	Like	Post	Tree	diam	Corner	Like
A	Sugar	12	S22E	13	12/13/18/17	Hickory	9	N66E	31
	Elm	15	S50W	18		Chesnut	17	S34W	28
B	W Oak	12	N34E	10	19/14/17/18	Beech	12	S45E	12
	do	12	West	22		W Oak	27	N77W	22
C	Beech	10	South	6	17/18/23/24	do	30	N85E	30
	do	10	N18W	19		Sum	13	S67W	30
D	W Oak	15	S82E	4	18/19/22/23	Chesnut	13	S11W	9
	do	14	N17W	27		W Oak	18	N18E	41
E	do	14	S63W	21	19/20/24/22	Poplar	24	N57W	29
	Hickory	9	N12E	19		Sum	14	S69E	39
F	Maple	12	corner						
G	Hickory	8	S89W	11					
	Sum	9	N26E	31					
H	Bronwood	8	N62W	9					
	Elm	6	S85E	7					
I	W Oak	10	S57E	19					
	Sum	16	N17W	33					
K	B Oak	18	S53W	37					
L	W Oak	18	N21E	9					
	Sum	8	S9E	12					
M	W Oak	12	S11E	26					
	Sum	6	N13E	36					
N	Bronwood	8	N65E	8					
	Sum	10	S38W	20					
O	Hickory	8	corner						
P	R Oak	9	S30W	31					
	Hickory	8	N13W	60					
Q	do	12	S32E	6					
	W Oak	20	S42W	41					
R									
S	B Oak	30	S71E	89					
	W Oak	15	N74W	146					
T	Chesnut	15	N26E	53					
	B Oak	20	S56E	57					
U	W Oak	18	N62E	43					
	Sum	11	S58E	39					
V	Sugar	12	S8W	19					
1	Sum	7	S27W	10					
	W Oak	24	N47W	76					
2	Ash	9	N60W	9					
	Hickory	7	N83E	17					
3	R Oak	14	N14E	17					
	do	14	S64E	35					
4	D Wood	6	S22W	4					
	W Oak	14	N52W	49					
5	Beech	12	N64W	31					
	Elm	8	N47E	3					
6	W Oak	10	S9E	24					
	W Oak	36	N33W	34					
7	Chesnut	9	N21W	18					
	W Oak	24	S83E	8					
8	Sum	15	S62W	7					
	W Oak	18	S59E	13					
1,2,9,10	Sum	8	North	18					
	Sum	16	Corner						
2,3,8,9	Beech	8	N80E	22					
34,7,8	Beech	12	N67W	11					
	Hickory	9	N86W	7					
4,5,6,7	do	9	S48E	12					
	Sum	7	S41W	12					
7,8,13,14	Hickory	5	N35E	17					
	do	5	N35E	17					
8,9,12,13	Sum	8	S21E	20					
	W Oak	16	S78E	14					
9,10,11,12	Elm	8	West	7					
	Beech	16	S46E	50					
11,12,19,20	B Oak	14	N39W	107					
	Poplar	10	S48	141					

28 1/2
11.100
40 1/2

11 20
On W. 202, 20
Scale 40 chs to in ch