


Tr 17 R 14 (Congress)

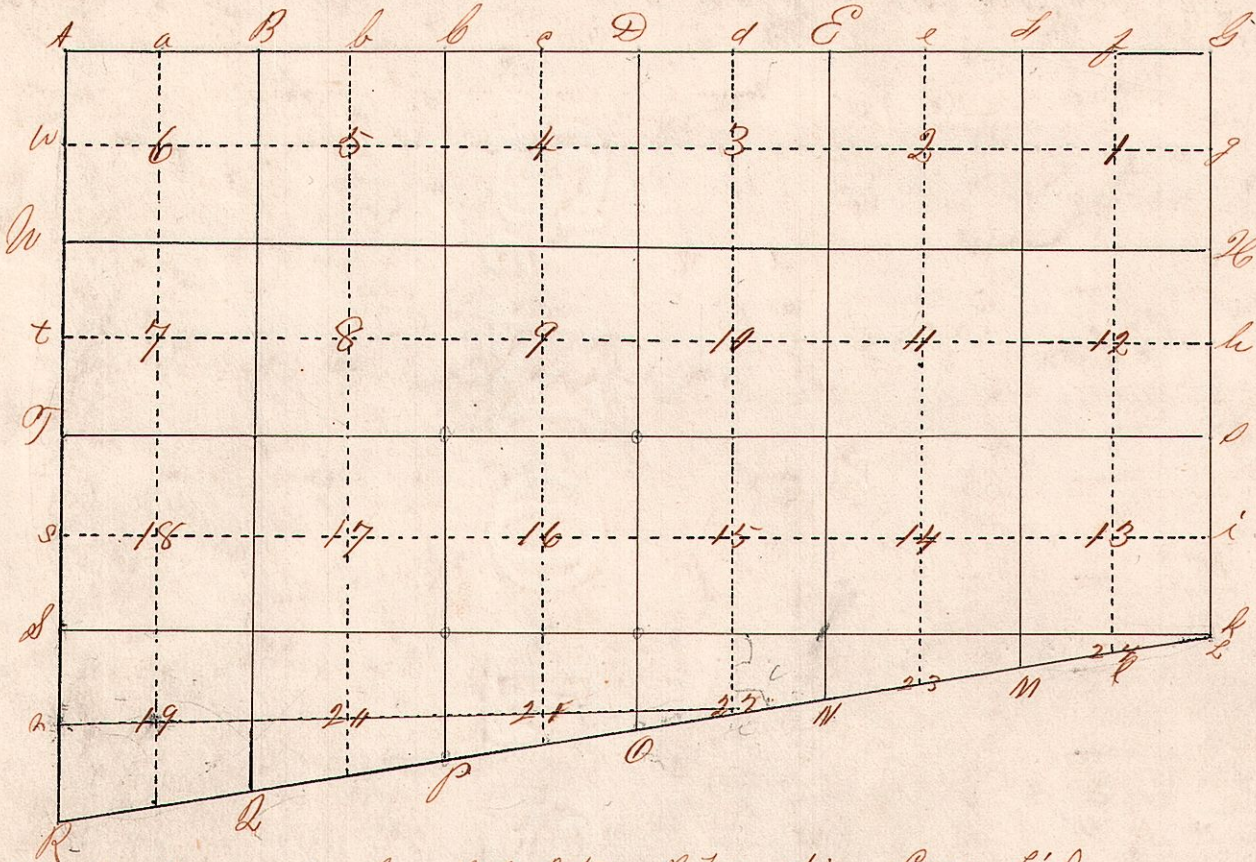

Post	Springer	diam	base	Links	Post	Springer	diam	base	Links	Post	Springer	diam	base	Links
A	BOak	8	N20 <sup>1</sup> W	133	13.14	WOak	28	S85 <sup>1</sup> E	10	16.21	WOak	41	N54 <sup>1</sup> W	6
	Sum	14	S32 <sup>1</sup> W	216	23.24	do	36	N85 <sup>1</sup> W	20		do	41	S30 <sup>1</sup> E	62
a	WOak	15	S26 <sup>1</sup> E	40	14.15	WOak	14	S19 <sup>1</sup> W	33	17.20	do	18	N3 <sup>1</sup> E	59
	BOak	5	N15 <sup>1</sup> W	50	22.23	B Apph	12	N18 <sup>1</sup> E	53		do	24	N57 <sup>1</sup> E	72
B	BOak	7	N52 <sup>1</sup> E	27	15.16					18.19	no bearing trees			
	do	6	N32 <sup>1</sup> E	65	21.22	WOak	10	corner						
b	Elm	4	N65 <sup>1</sup> W	7	16.17	WOak	8	S47 <sup>1</sup> E	11					
	WOak	24	S65 <sup>1</sup> E	25	20.21	Sugar	9	N45 <sup>1</sup> W	22					
c	BOak	15	N22 <sup>1</sup> W	21	17.18	BOak	7	S76 <sup>1</sup> E	48					
	Maple	12	S32 <sup>1</sup> E	34	19.20	do	6	S13 <sup>1</sup> W	19					
C	BOak	4	S7 <sup>1</sup> E	17	Quarter section corners									
	Chest	4	N1W	9	1-2	WOak	24	N81 <sup>1</sup> E	45					
D	BOak	6	S73 <sup>1</sup> E	17		Sum	14	N75 <sup>1</sup> W	9					
	do	6	N21 <sup>1</sup> W	16	2.3	do	6	N23 <sup>1</sup> E	11					
d	Sum	9	S53 <sup>1</sup> E	27		Hickory	9	S93 <sup>1</sup> W	34					
	do	7	S27 <sup>1</sup> E	35	3.4	do	10	S78 <sup>1</sup> W	34					
E	Maple	12	corner			BOak	15	N78 <sup>1</sup> E	49					
	WOak	34	N26 <sup>1</sup> E	40	4.5	BOak	3	S60 <sup>1</sup> W	5					
	do	12	S39 <sup>1</sup> W	24		Hickory	20	S99 <sup>1</sup> E	25					
H	BOak	30	N80 <sup>1</sup> W	13	5.6	WOak	8	N54 <sup>1</sup> W	18					
	Elm	12	S34 <sup>1</sup> W	22		BOak	20	N57 <sup>1</sup> E	9					
i	WOak	30	N11 <sup>1</sup> E	22	7-8	WOak	28	N30 <sup>1</sup> E	31					
	BOak	30	S71 <sup>1</sup> E	23		do	28	S42 <sup>1</sup> W	48					
J	WOak	10	S21 <sup>1</sup> W	9	8.9	WOak	26	S64 <sup>1</sup> W	89					
	do	12	N57 <sup>1</sup> W	19		do	24	S35 <sup>1</sup> E	79					
g	WOak	30	S50 <sup>1</sup> E	27	9.10	ROak	14	N89 <sup>1</sup> E	30					
	Cash	6	S71 <sup>1</sup> W	11		Hickory	14	S86 <sup>1</sup> W	35					
H	WOak	50	Corner		10.11	WOak	21	N2 <sup>1</sup> E	146					
	Sum	10	S78 <sup>1</sup> E	33		do	15	N60 <sup>1</sup> E	115					
	Hickory	12	S41 <sup>1</sup> W	14	11.12	ROak	16	S77 <sup>1</sup> W	11					
J	WOak	14	S75 <sup>1</sup> W	41		B Walnut	8	S58 <sup>1</sup> E	17					
	do	12	N40 <sup>1</sup> E	33	13.14	Sum	6	S82 <sup>1</sup> W	23					
k	WOak	30	N77 <sup>1</sup> E	12		WOak	18	N72 <sup>1</sup> E	25					
	Dogwood	4	N32 <sup>1</sup> W	5	14.15	WOak	16	N21 <sup>1</sup> E	20					
L	Sumwood	10	N83 <sup>1</sup> W	12		Hickory	10	N81 <sup>1</sup> W	47					
	Cash	8	N86 <sup>1</sup> E	27	15.16	do	9	corner						
M	WOak	10	S52 <sup>1</sup> E	38	16.17	WOak	12	S78 <sup>1</sup> E	16					
	ROak	10	N15 <sup>1</sup> W	15		Hickory	4	N84 <sup>1</sup> W	12					
N	Sum	12	N7 <sup>1</sup> E	37	17.18	ROak	16	N53 <sup>1</sup> W	36					
	WOak	20	S79 <sup>1</sup> W	22		Chest	7	S40 <sup>1</sup> E	36					
O	Sugar	11	S30 <sup>1</sup> W	15	19.20	BOak	18	S32 <sup>1</sup> E	2					
	Maple	9	N53 <sup>1</sup> E			do	26	N58 <sup>1</sup> W	16					
				20.21		Hickory	14	S40 <sup>1</sup> W	25					
2	Hickory	12	N38 <sup>1</sup> E	19		WOak	36	N20 <sup>1</sup> E	41					
	Elm	11	S35 <sup>1</sup> W	55	1.12	Pine Oak	14	N14 <sup>1</sup> E	18					
3	Sum	11	N50 <sup>1</sup> E	27		ROak	10	S14 <sup>1</sup> W	25					
	BOak	11	S67 <sup>1</sup> W	31	2.11	Hickory	11	N50 <sup>1</sup> E	5					
4	WOak	26	N81 <sup>1</sup> E	48		WOak	40	S80 <sup>1</sup> W	37					
	Cash	10	S78 <sup>1</sup> W	36	3.10	do	16	N49 <sup>1</sup> W	25					
5	WOak	36	N73 <sup>1</sup> E	10		do	40	S52 <sup>1</sup> E	48					
	ROak	36	S13 <sup>1</sup> W	21	4.9	Hickory	10	N19 <sup>1</sup> W	4					
R	WOak	26	East	4		BOak	19	S17 <sup>1</sup> W	46					
				5.8		WOak	10	S40 <sup>1</sup> E	17					
						Hickory	18	N80 <sup>1</sup> W	71					
						do	24	N12 <sup>1</sup> E	11					
						WOak	14	S15 <sup>1</sup> E	36					
Section corners														
F-2	WOak	10	N48 <sup>1</sup> E	16	6.7	do	24	N12 <sup>1</sup> E	11					
1-12	do	20	S85 <sup>1</sup> W	37		WOak	14	S15 <sup>1</sup> E	36					
2-3	BOak	14	S16 <sup>1</sup> E	20	7.18	Hickory	11	S69 <sup>1</sup> W	5					
10.11	Elm	12	N31 <sup>1</sup> W	18		Dogwood	5	N82 <sup>1</sup> E	28					
3.4	BOak	10	S15 <sup>1</sup> E	23	8.17	Elm	9	Smith	18					
7.10	do	14	S63 <sup>1</sup> E	31		Hickory	10	N13 <sup>1</sup> E	13					
4-5	do	18	N46 <sup>1</sup> W	17	9.16	BOak	26	N51 <sup>1</sup> W	11					
8.9	WOak	14	S39 <sup>1</sup> E	39		WOak	24	S78 <sup>1</sup> E	39					
5-6	Hickory	11	N41 <sup>1</sup> W	12	11.15	Hickory	10	S57 <sup>1</sup> W	18					
7-8	BOak	16	S71 <sup>1</sup> E	19		Maple	16	N45 <sup>1</sup> E	50					
7-8	BOak	18	N9 <sup>1</sup> E	81	11.14	Hickory	26	N33 <sup>1</sup> W	2					
17.18	do	20	N42 <sup>1</sup> W	16		do	9	S35 <sup>1</sup> W	26					
8.9	WOak	20	Smith	10	12.13	WOak	10	N9 <sup>1</sup> E	9					
16.17	BOak	5	S28 <sup>1</sup> W	57		Hickory	18	S19 <sup>1</sup> E	3					
9.10	Hickory	10	N48 <sup>1</sup> W	10	13.14	do	18	S20 <sup>1</sup> E	4					
15.16						do	40	S20 <sup>1</sup> W	5					
14.14	WOak	26	N67 <sup>1</sup> W	32	14.23	WOak	12	S27 <sup>1</sup> W	19					
14.15	Hickory	12	S19 <sup>1</sup> E	10		do	8	N34 <sup>1</sup> E	21					
11.12	Sum	11	S79 <sup>1</sup> W	21	15.22	thorn	9	N10 <sup>1</sup> W	6					
13-14	BO	8	N82 <sup>1</sup> E	29		BOak	7	S65 <sup>1</sup> E	29					