


Township 18 Range 14 (Group 1)

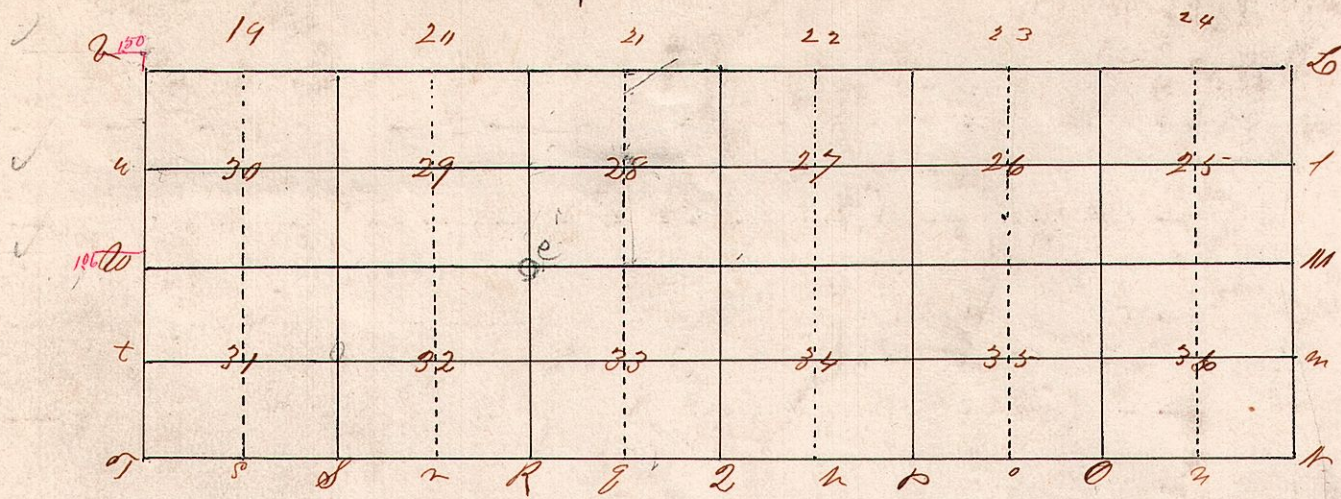

Post	Bearing	Dist	Corner	Link	Post	Bearing	Dist	Corner	Link
to	BOak	11	N47W	39, 41, 25, 33, 34	Hickory	9	East	37	
	Maple	15	S82E	25	do	8	N12E	26	
	WOak	7	S32W	12, 28, 19, 32, 33	SW Oak	18	S58 1/2 W	46	
	do	12	N43E	11	do	18	N25E	52	
M	WOak	9	S86	19, 28, 19, 32	WOak	11	S20E	13	
	Sapras	4	S31W	4	do	12	N9E	28	
m	WOak	10	S21W	9	25, 26	WOak	18	N11W	62
	do	12	N15W	19	do	20	S3E	48	
	do	30	N1E	22, 26, 27	Grass off	6	N43E	14	
	BOak	30	S70E	23	WOak	18	S32W	37	
O	do	30	N80W	13	27, 28	Hickory	10	N35W	16
	Elm	12	S34W	22	BOak	8	S26E	29	
o	WOak	34	N24E	40	28, 29	WOak	18	S87 1/2 E	47
	do	12	S33W	24	do	10	S32W	60	
P	Maple	Corner		29, 30	BOak	14	S35 1/2 W	5	
p	Sum	9	S53E	27	WOak	24	S18 1/2 E	19	
	do	7	S27E	35	31, 32	Hickory	11	S61E	35
D	BOak	6	S72E	17	WOak	16	S33W	79	
	do	6	N21W	10	52, 39	WOak	26	N27 1/2 W	2
g	do	4	S7E	17	BOak	18	S22 1/2 E	14	
	Chest	4	N1W	9	53, 34	BOak	6	N4E	24
R	WOak	15	N22W	21	Hickory	5	S35W	10	
	Maple	12	S32E	34	34, 35	do	8	N15W	41
r	Elm	4	N65W	7	do	7	S78W	33	
	WOak	24	S65E	25	35, 36	BOak	4	S57W	11
S	BOak	7	N52E	57	do	8	N22E	19	
	do	6	N42E	65	19, 31	In March			
s	WOak	15	S26E	40	24, 29	BOak	24	Corner	
	BOak	5	N15W	59	21, 28	Elm	26	S62E	33
T	BOak	8	N20W	18	Hickory	70	N11W	48	
	Sum	14	S32W	216	22, 27	WOak	14	N13 1/2 W	9
T	WOak	16	N11W	17	do	50	S16E	34	
	Hickory	14	S42W	27	23, 26	Cherry	14	N2E	24
U					Hickory	10	S23W	21	
u					24, 25	BOak	36	N77W	53
q					WOak	10	N83E	5	
Suberior Section Corners				25, 96	do	10	S52E	38	
19, 20, 29, 30	WOak	26	S7E	180	do	24	N17 1/2 W	33	
	do	26	S57W	294	26, 35	Hickory	10	Corner	
20, 21, 28, 29	do	26	N12 1/2 W	57	27, 34	WOak	14	S68W	23
	BOak	12	S39E	65	do	14	N37 1/2 E	52	
J	WOak	20	S49E	19	28, 38	WOak	30	S79E	64
	do	10	N67W	59	do	30	N83W	28	
32, 23, 26, 27	Elm	7	N9 1/2 W	28	29, 32	BOak	16	N53E	18
58, 45E	WOak	8	S8 1/2 E	50	WOak	10	S45W	77	
23, 24, 25, 26	do	12	S41W	20	30, 31	BOak	8	S53E	30
	BOak	16	N61E	50	do	7	N15E	15	
25, 26, 28, 36	Hickory	4	S14W	7	do	5	N1E	22	
	do	5	N1E	22					
26, 27, 34, 35	WOak	20	S35E	32					
	Hickory	12	N30W	18					