

Correction Plat

ASHLAND COUNTY  
HOLMES COUNTY

PLAT OF LANDS, CONTIGUOUS TO THE  
VILLAGE OF LOUDONVILLE, OHIO, BEING PART  
OF THE NORTHWEST QUARTER OF SECTION  
6, TOWNSHIP 19, RANGE 15, WASHINGTON  
TOWNSHIP, HOLMES COUNTY, OHIO, CONTAINING  
5.811 ACRES OF LAND.



CORPORATION LINE VILLAGE OF LOUDONVILLE  
N 5° 18' 46" E  
295'

LOT #1  
1.016 AC

LOT #2  
1.016 AC

LOT #3  
1.016 AC  
5.811 Acres

LOT #4  
1.234 AC

LOT #5  
1.529 AC

573° 56' 07" E  
254.96

State Route 39

490'

150'

447.46' 150'  
N 84° 41' 14" W

147.46'

150'

312.62'

160.08'

237.78'

527.74 83" W

101164  
RECTD. March 13, 1974  
AT 2:40 O'CLOCK P.M.  
RECORDED March 13, 1974  
HOLMES CO. Vol. 2, Pg. 150  
FEE: \$ 2 VC  
Richard Edwards RECORDER  
35, X, A, P, 2  
Correction Plat  
For original see  
underneath this plat.

This Plat prepared from  
Survey Records  
By: Shelby J. Edwards  
Reg. Surveyor 3925  
Reg. Engineer 4447

RECEIVED

MAR 13 1974  
JOHN OSWALD  
AUDITOR


Volume 2 Page 150

Curve Data  
Δ = 21° 55' 19"  
D = 7° 00' 44"  
R = 817.08'  
T = 158.25'  
L = 312.62'

RECORDED  
FEE: \$ 2 VC  
HOLMES CO. Vol. 2, Pg. 150  
RECORDED  
AT 2:40 O'CLOCK P.M.  
RECORDED  
RECTD. December 19, 1972

ASHLAND COUNTY  
HOLMES COUNTY

PLAT OF LANDS, CONTIGUOUS TO THE  
VILLAGE OF LOUDONVILLE, OHIO, BEING PART  
OF THE NORTHWEST QUARTER OF SECTION  
6, TOWNSHIP 19, RANGE 15, WASHINGTON  
TOWNSHIP, HOLMES COUNTY, OHIO, CONTAINING  
5.811 ACRES OF LAND.

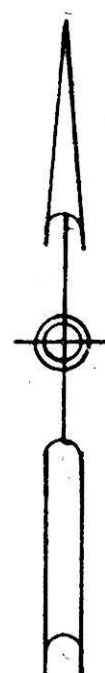

CORPORATION LINE VILLAGE OF LOUDONVILLE  
N 5° 18' 46" E  
295'

5.811 Acres

584° 41' 14" E  
895'

573° 56' 07" E  
254.96

State Route 39

490'

447.46' 150'  
N 84° 41' 14" W

PC

312.62'

527.74 83" W

97422  
RECTD. December 19, 1972  
AT 2:40 O'CLOCK P.M.  
RECORDED  
HOLMES CO. Vol. 2, Pg. 150  
FEE: \$ 2 VC  
Richard Edwards RECORDER  
See deed Vol. 182-Pg. 418

This Plat prepared from  
Survey Records  
By: Shelby J. Edwards  
Reg. Surveyor 3925  
Reg. Engineer 4447

Curve Data  
Δ = 21° 55' 19"  
D = 7° 00' 44"  
R = 817.08'  
T = 158.25'  
L = 312.62'