

**REFERENCES:**

DEED VOL. 239 PAGE 139  
 DEED VOL. 174 PAGE 321  
 DEED VOL. 264 PAGE 733  
 DEED VOL. 234 PAGE 375  
 DEED VOL. 179 PAGE 514  
 PLAT VOL. 11 PAGE 45  
 PLAT VOL. 8 PAGE 503  
 PLAT VOL. 10 PAGE 543


**CLARK TOWNSHIP  
 N. W. QTR. SECTION 10  
 T-8 N; R-5 W  
 HOLMES COUNTY, OHIO**

0 50 100 200

SCALE: 1" = 100'

- STONE FOUND
- IRON PIN FOUND
- △ R.R. SPIKE SET
- 5/8" RE BAR WITH I.D. CAP SET
- I.D. CAP MARKED "BAKER 6938"

BEARINGS FROM PLAT VOL. 11 PAGE 45

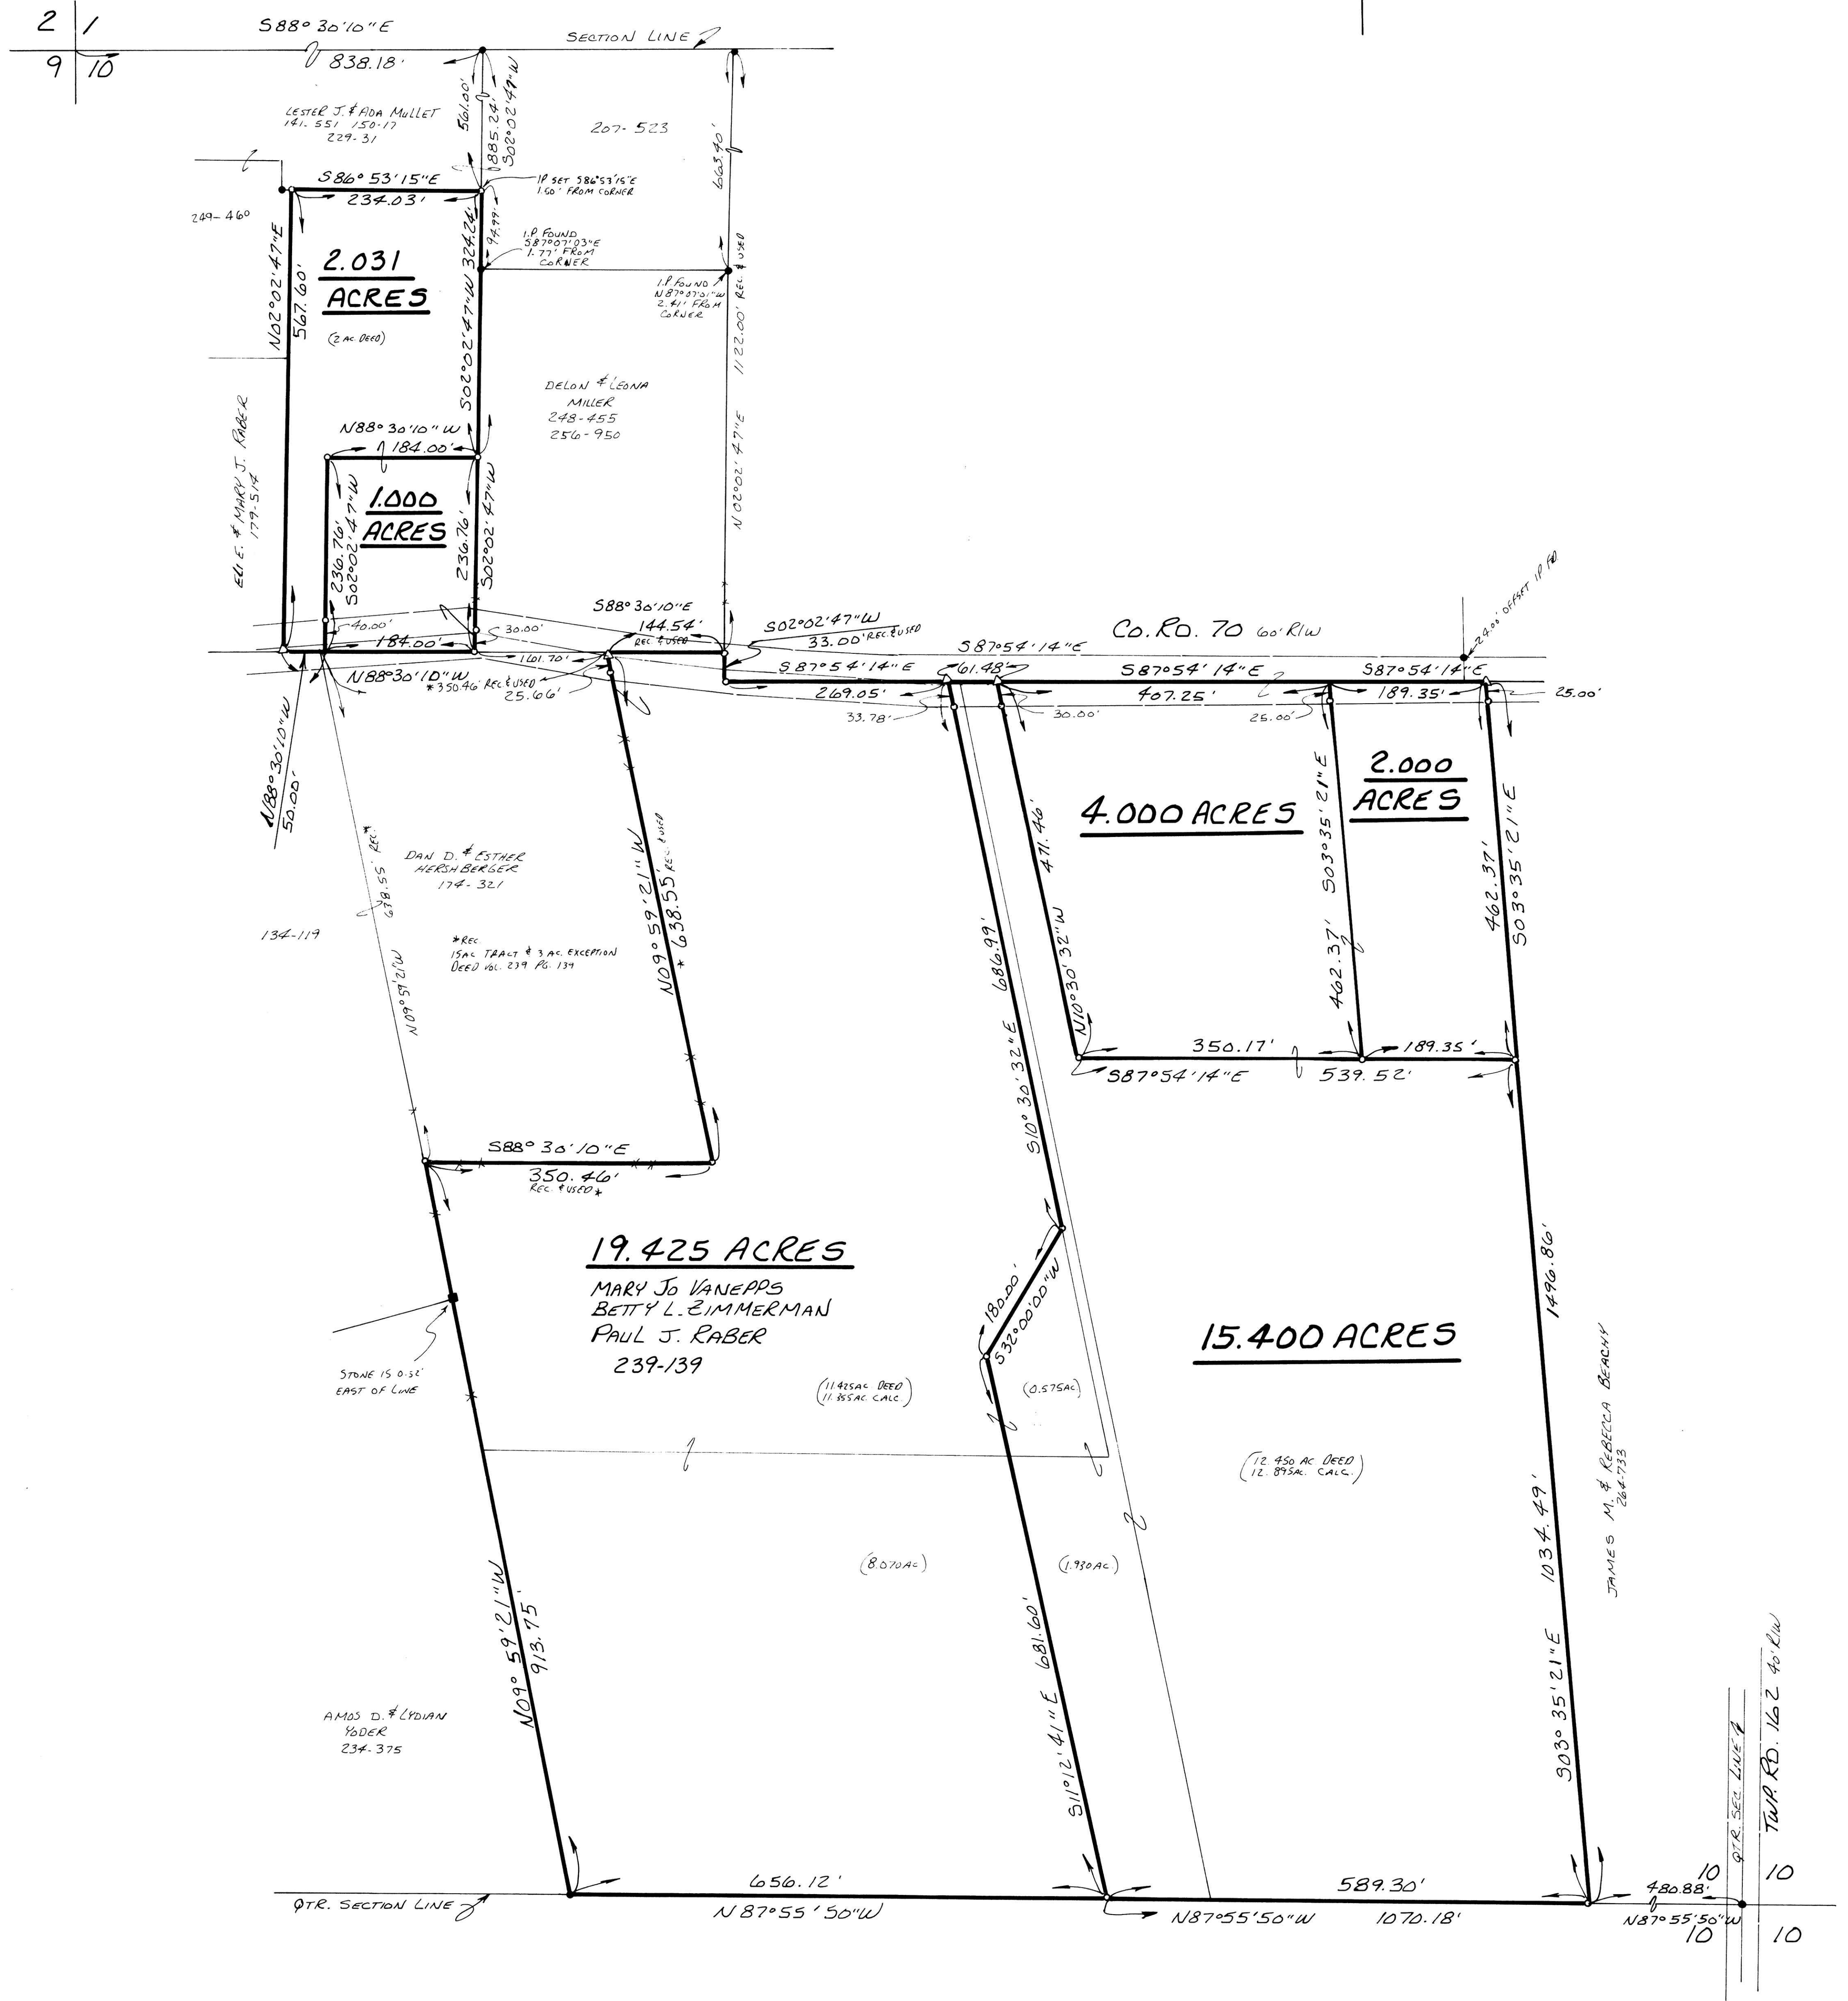

Book 3-10-1995 AT 3:10 PM  
 Recorded 3-13-1995 Holmes Co. Ohio Fee \$40.00  
 Plat Vol 2 Pg 247 Recorder Sissy Miller  
 by 26109 896

I CERTIFY THIS SURVEY TO BE CORRECT TO THE BEST OF MY KNOWLEDGE.

*Donald C. Baker*  
 DONALD C. BAKER P.S. 6938  
 5958 T.R. 322  
 MILLERSBURG, OHIO 44654  
 PH. (216) 674-4788  
 JANUARY 11, 1994

