These properties are subject to all legal highways, rights-of-way, easements, leases and restrions of record or otherwise legally established which may not be necessarily shown hereon.

2013000886352
8:2 Pg:502
FILED FOR RECORD IN
HOLMES COUNTY, OH
ANITA HALL, COUNTY RECORDER
11/27/2013 1:06 PM
PLAT LARGE (66.00)
PAGES: 1

ORV 247 pgs 1510 - 1513

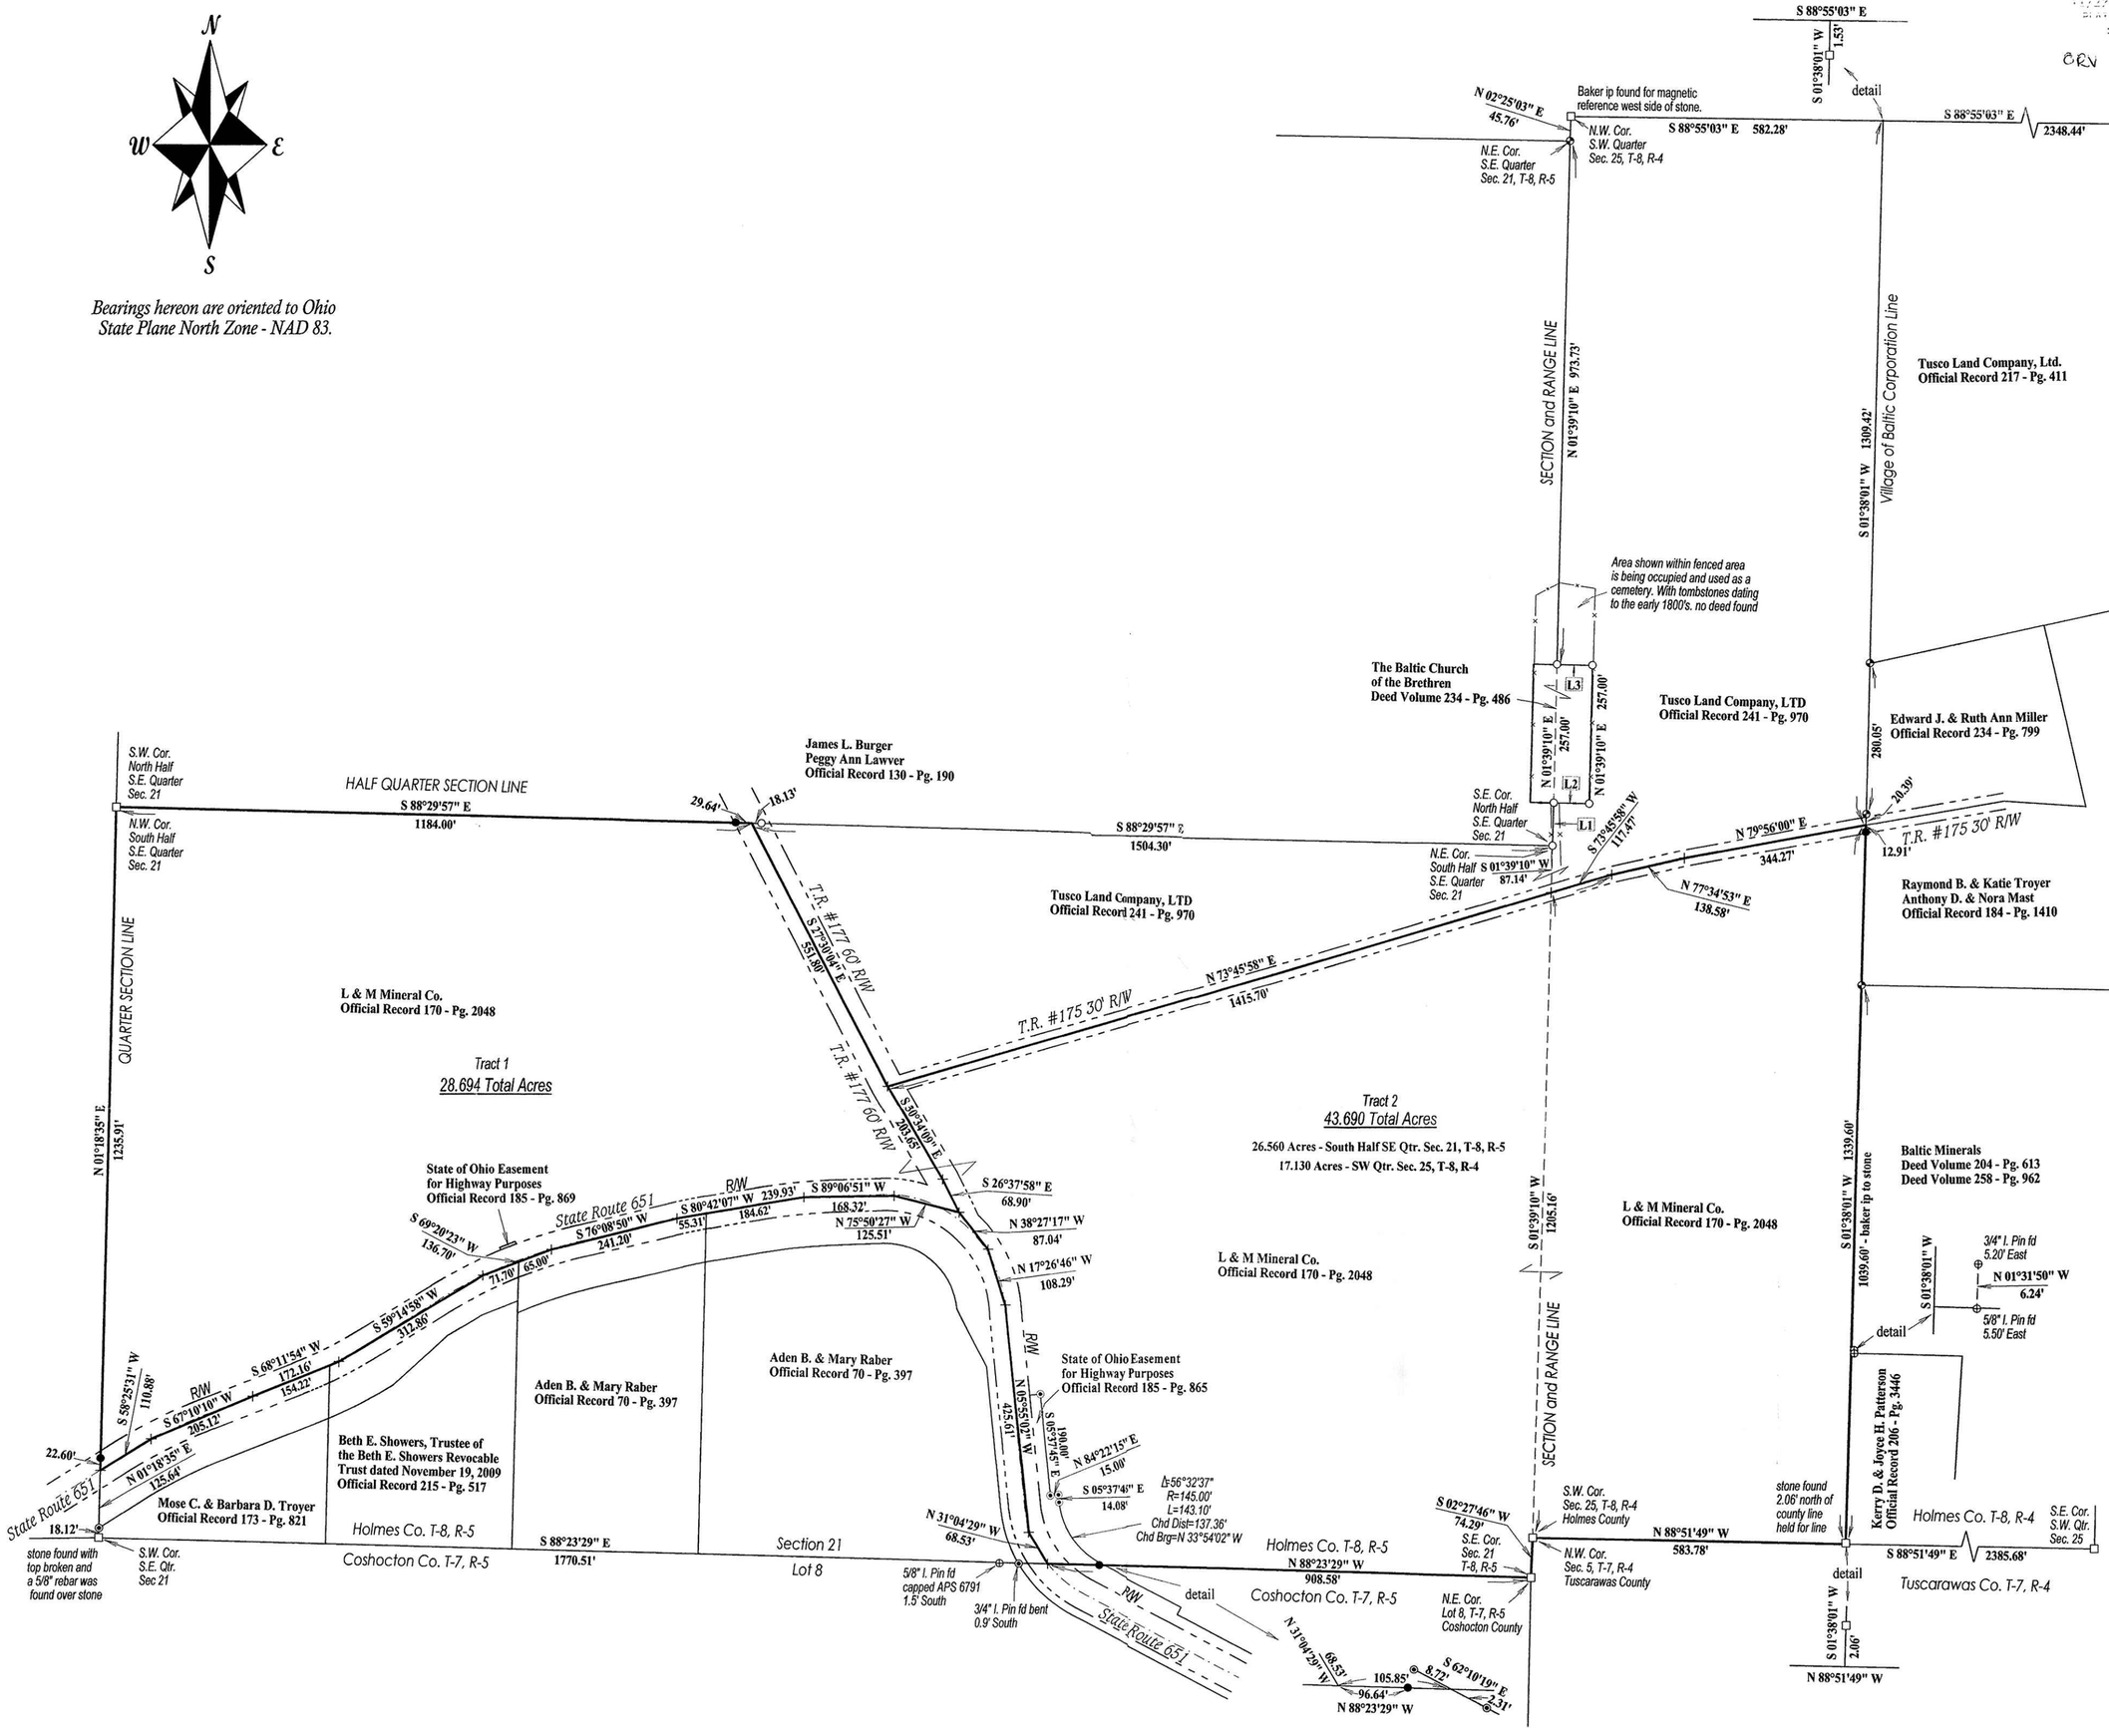

Id	Bearing	Distance
L1	N 01°39'10" E	79.70'
L2	S 88°20'50" E	66.00'
L3	N 88°20'50" W	66.00'

References:

OR Vol. 241 - Pg. 970
OR Vol. 170 - Pg. 2048
OR Vol. 130 - Pg. 190
OR Vol. 217 - Pg. 411
OR Vol. 234 - Pg. 799
OR Vol. 184 - Pg. 1410
OR Vol. 206 - Pg. 3446
Deed Vol. 204 - Pg. 613
Deed Vol. 258 - Pg. 962
Deed Vol. 234 - Pg. 486
Deed Vol. 100 - Pg. 144

Plat Vol. 17 - Pg. 55
Plat Vol. 19 - Pg. 20
Plat Vol. 19 - Pg. 1125
Plat Vol. 19 - Pg. 2203

● Denotes 5/8" x 30" iron rebar with blue plastic caps stamped F.A.W. 8401 set.

○ Denotes 5/8" x 30" iron rebar with blue plastic caps stamped F.A.W. 8401 set on a previous survey.

◐ Denotes 5/8" iron pin found capped BAKER 6938.

⦿ Denotes 3/4" iron pin found with 2" aluminum cap stamped OLOT R/W-District 5.

⊕ Denotes iron pin found as noted.

□ Denotes stone monument found.

Documents used were plats of local surveys, official records, deed volumes and pages as shown hereon.

Scale: 1 inch = 200 feet

200 100 0 200 400 600 800

APPROVED FOR TRANSFER ONLY
NO SUBDIVISION APPROVAL REQUIRED
(O.R.C. 711.0
By VB 11-20-13

PLAT APPROVED
11/20/2013

Plat of Survey
for
L & M Mineral Co.

Situated in the Township of Clark, the County of Holmes, the State of Ohio.

Being located in the South Half of the Southeast Quarter of Section 21 Township 8, Range 5 and also in the Southwest Quarter of Section 25 Township 8, Range 4.

Prepared by
WARD & EMLER SURVEYING, INC.
113 Third Street SE
New Philadelphia Ohio 44663-2512
(330) 364-5866 (voice)
(330) 364-1107 (fax)
E-mail: wesurvey@frontier.com

I, the undersigned, do hereby state that this plat was prepared from a field survey completed under my supervision and persuant to Chapter 4733-37 of the Ohio Administrative Code.

R. A. Wells

R. Aaron Wells P.S. #8401 October 4, 2013