
Stone -NW Cor. 80480 11.0 oc. tr. 27. 115-328 REC'D: February 28-1966 142-443 AT 4:00 O'CLOCK P.M. RECORDED: March 1, 1966 HOLMES CO. PART VOL 4 PG. 83 Stone NE Cor. EEE: \$ 1.00 NEQY. Sec. 18 ŝ velyos ORDER T- 9, R-5 State Route No. 39 N780141 266.31 N89"32W N86°38'W N81°42'E 115.4 148.0' 0 I.P. 1. P. 0.78/ ac. 719. Paul H. 4 Eli J. D.E Louna Mory Kauf man Miller 1.99 ac. · 20c. 79.6 ac. 144-569 132- 170 Plot of Survey of 1.99 AC.T.R. For Poul H. Loufmon N.E. Qr. Scc. 18, T-9, R-5 21046 Walnut Creck Township T. DEAN DAVIDSON REGISTERED SURVEYOR No. 4776 1116 WALNUT ST. - DOVER, OHIO Phone 52643 Scale]"= 100' Date 12-2-65 589 34 W 1.P.

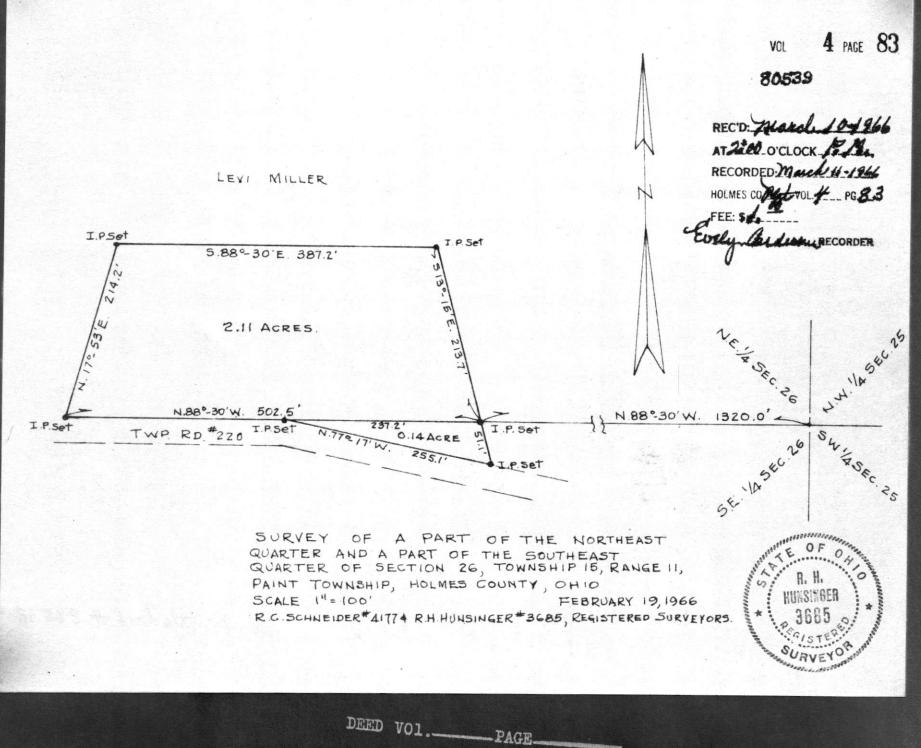

4 PAGE 83 VOL Post N85°56'W 800.5 Gacre tract Total Area 8.55 acres 369. 4 20. FN 1.1 363.95 301.45 1.P. 584°13 E 588'28'E I.P N. 85°ES 861.75 1160.55 12º1N loacre tract COUNTY \$84.75 80485 COUNTY TUSCARAWAS SIMTO REC'D: March 1-1966 AT 10 & O'CLOCK P.M. RECORDED March 2. 1966 HOLMES COPERTEVOL # PG. 23 N FEE: \$/ S.E.Cor. Sac.24 Auderson RECORDER Wely P. 153.5' 586°12'E Post Plat of Survey for Alfred E. Zahner. Being all of a 6 Acre tract and

Plat of Survey for Alfred E. Zahner. Being all of a 6 Acre tract and part of a 10 Acre tract in the Southeast Quarter of Section 24 in Township 9, Range 4, Walnutcreek Township, Holmes County, Ohio. No buildings. Surveyed cantary 27, 1965 AGE

AVIC YOST

RVEN

D. Y. M:

10

0

Surveyor # 4043


Scale: 1" = 100 ft.

DIFIERD

LOA

PACE

16 × 10

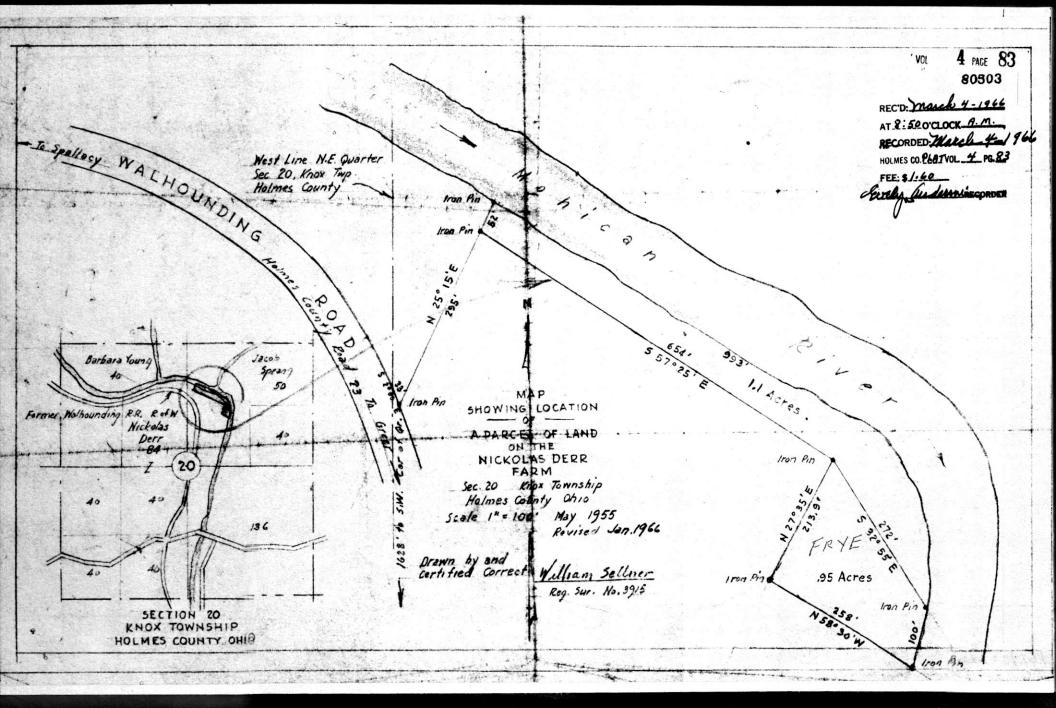

DEED VO1. PAGE