
WILLARD LANDIS

North Crownhill Road Extension (or CR 47) At the Intersection with CR 29 or 207 R.D. I, ORRYILLE, OHIO

REGISTERED PROFESSIONAL ENGINEER & SURVEYOR


HARDY TOWNSHIP--HOLMES COUNTY
PART OF THE NORTHWEST PART OF
LOT #1, 2ND QUARTER TWP. T-9, R-7

COUNTY AUDITOR: There are no buildings nor improvements on this 4.03 acre parcel

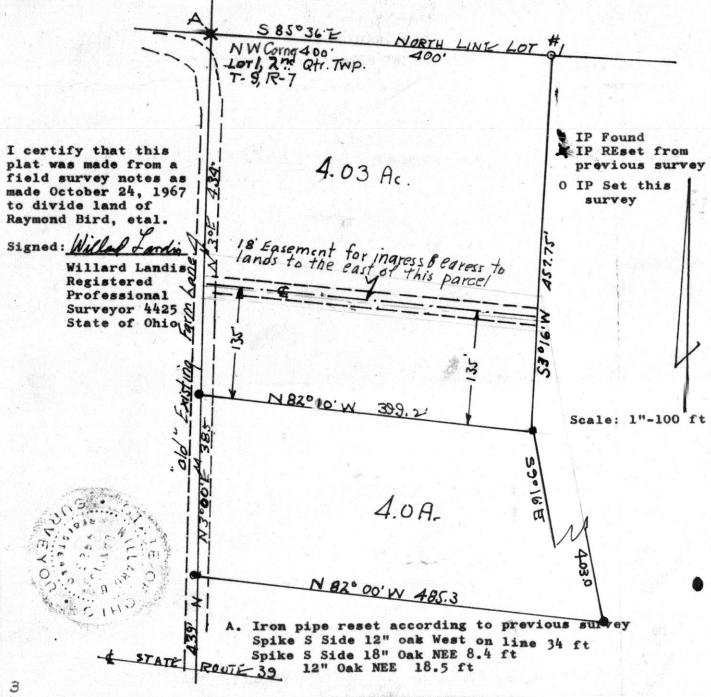

RECODER O'CLOCK HAM RECORDED: OCLOCK HAM HOLMES COLLET VOL. 4 PG. 151
FEE: \$ 1.00

WELLY GULDERSAL RECORDER

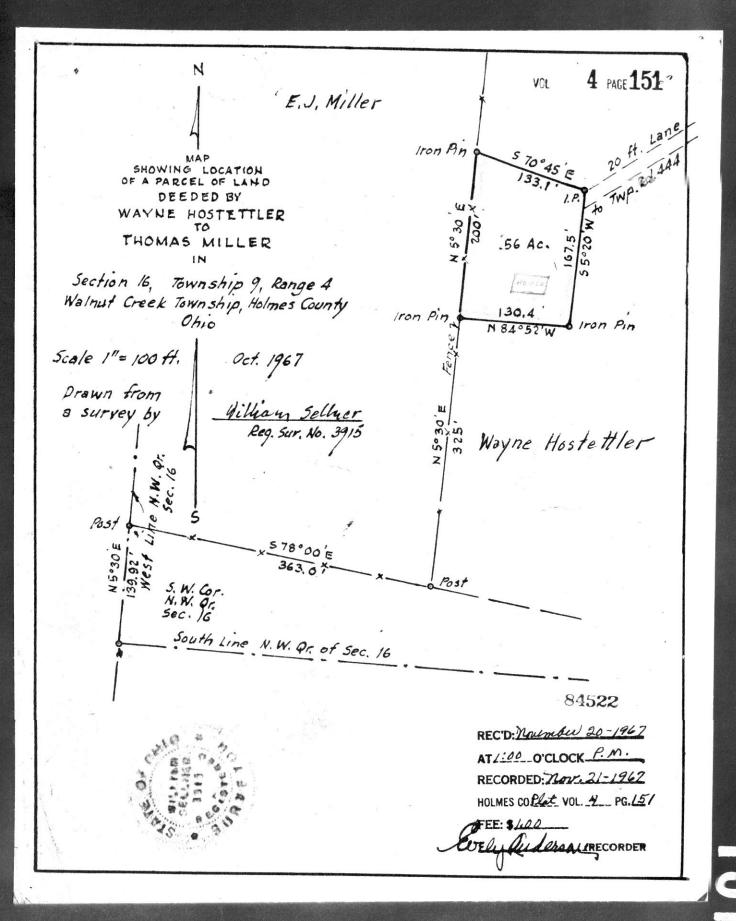

North Crownhill Road Extension (or CR 47) At the Intersection with CR 29 or 207

R.D. I, ORRVILLE, OHIO

Phone: 682-4906

WILLARD LANDIS

REGISTERED PROFESSIONAL ENGINEER & SURVEYOR

PART OF THE SOUTHEAST QUARTER SECTION 18
T-9
R-7

IP found
0 IP set

A Drive spike set

144.4.

COUNTY AUDITOR: There are no improvments nor building on the parcel hereby surveyed.

I certify that this plat was made from field notes of a field survey made October 3, 1967 to divide land of Raymond Bird, etal, 122: 182 and 123: 272.

Signed: Willan Landis

Willard Landis, Registered Promessional Surveyor #4425 State of Ohio

Willard Land
Registered F
State of Oh

3.0A

SECON Second

SECON Second

A - Solid IP found -deep.
Set drive Spike over it

SEC





FEE: \$1