



I hereby certify the above to be a correct plat and true return of field notes of a survey in Lot 22, Second Quarter, Mechanic Township, T-IN, R-6W, Holmes County made in March, 1968.

& Assoc.

EDGAR R. JOHNSTON R. S. 3828

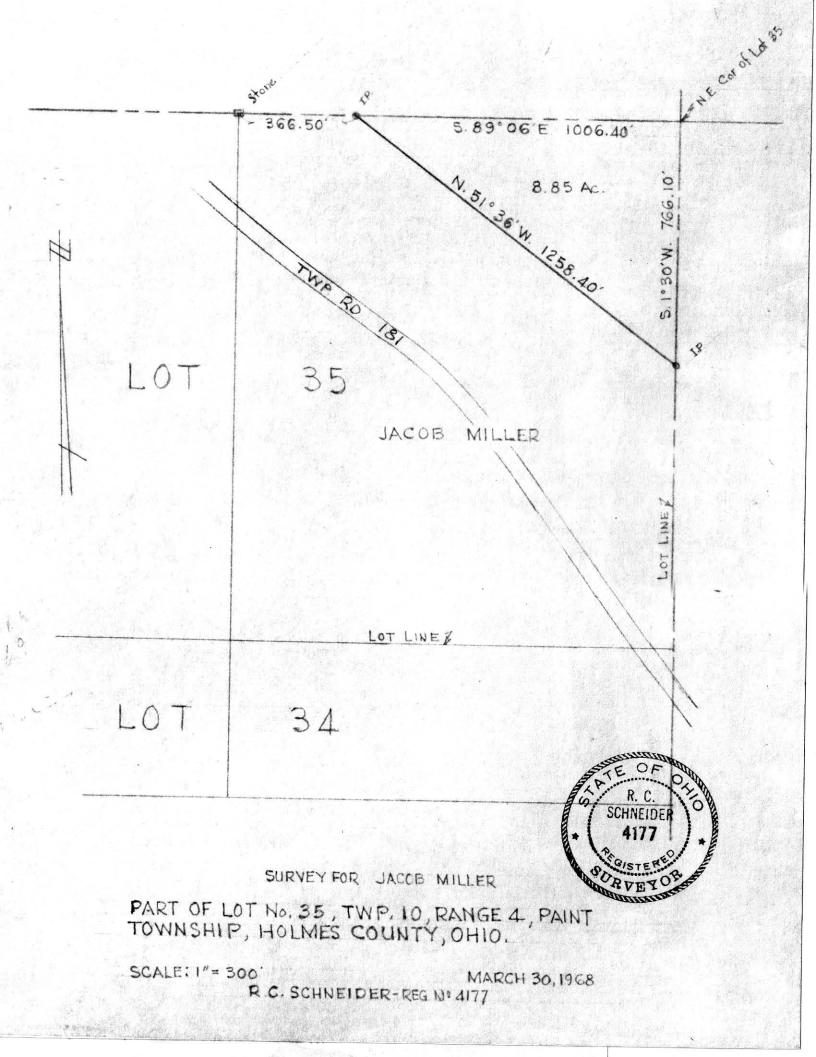

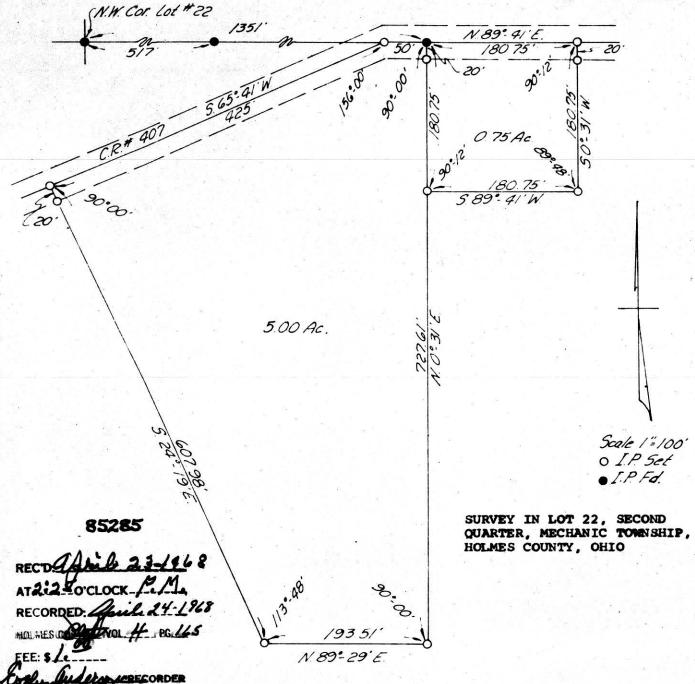

Shaffer, Johnston, Lichtenwalter & Assoc.

I hereby certify the above to be a correct plat and true return of field notes of a survey in Lot 22, Second Quarter, Mechanic Township, T-gN, R-6W, Holmes County made in March, 1968.

