


BEING PART OF: LOT 1
 SEC. 4
 QUAR. 4
 T. 9 N. R. 9 W. U.S.M.L.
 TOWNSHIP Knox
 COUNTY Holmes, Ohio

THE COSHOCTON LAND SURVEYING SERVICE
 233 S. FOURTH ST. COSHOCTON, OHIO 43812

SURVEY FOR: Dean Boyd
 DATE: Sept, 1977
 SCALE: 1" = 200'

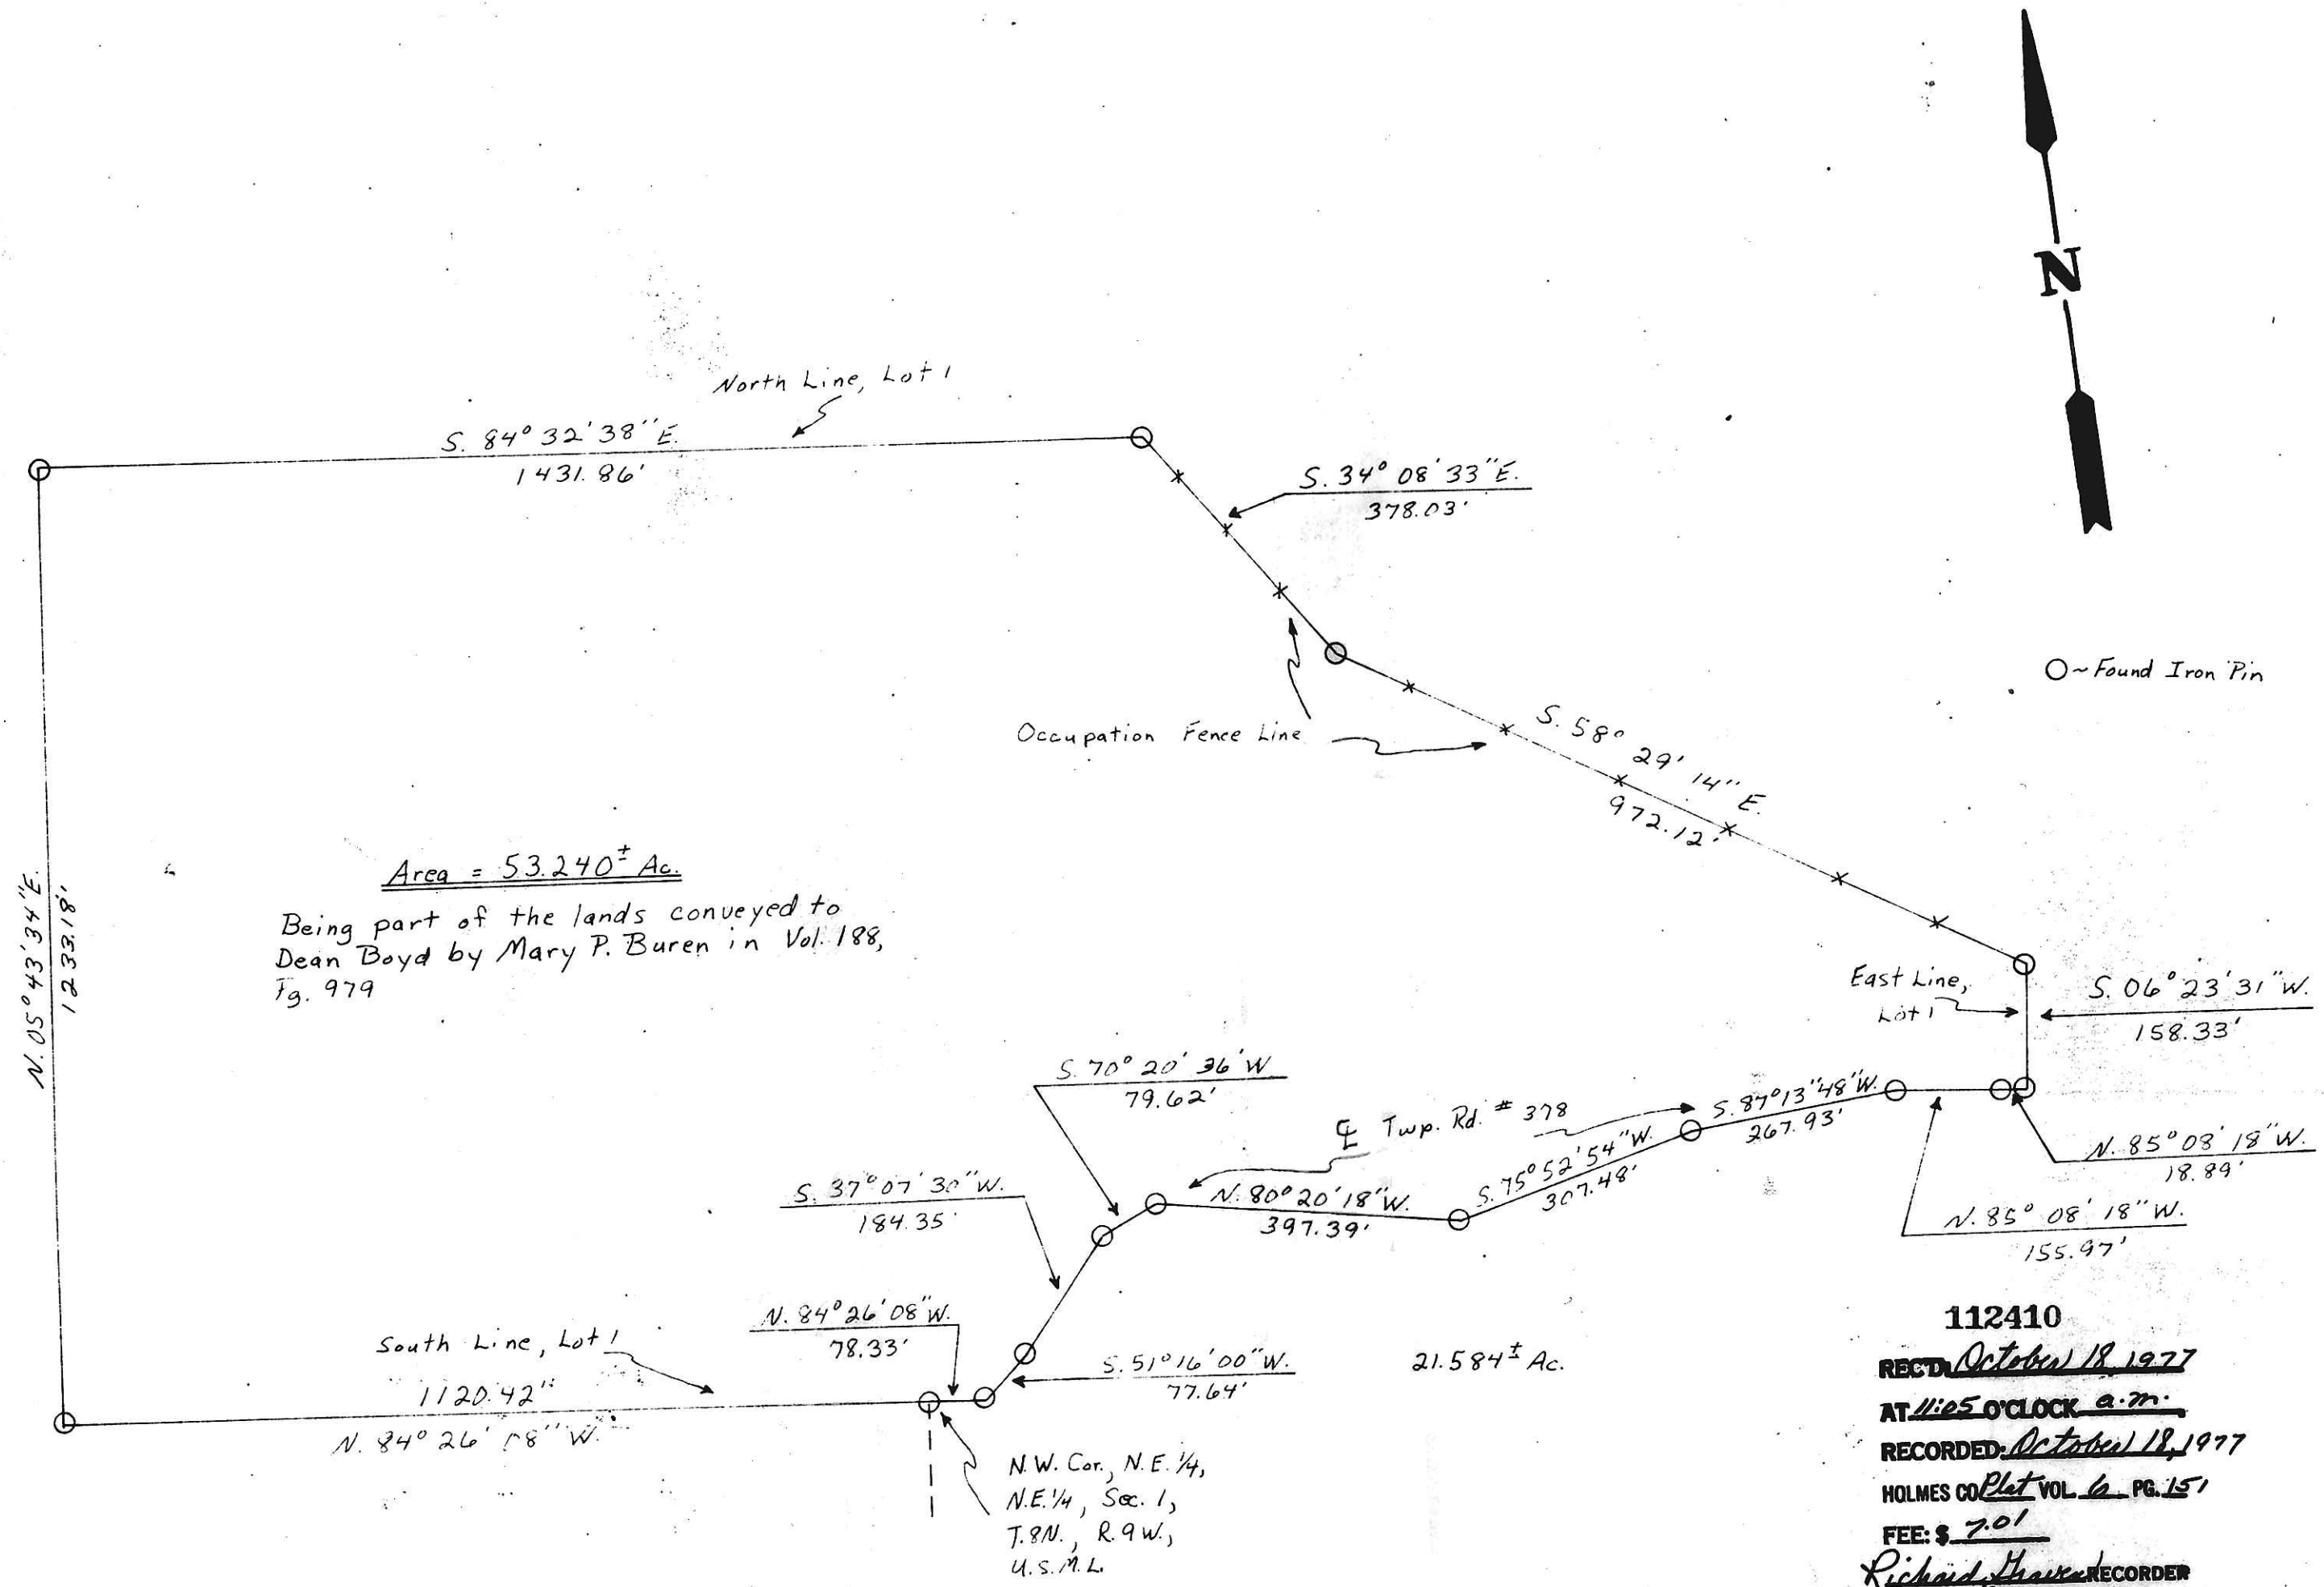

112410
 RECD. October 18, 1977
 AT 11:05 O'CLOCK a.m.
 RECORDED October 18, 1977
 HOLMES CO. Plat VOL. 6 PG. 151
 FEE: \$ 7.01
 Richard Shaw RECORDER
 16.5" x 21.25" x 2
 Deed Vol. 200-Pg. 84



I hereby certify the above plat to be correct to the best of my knowledge and belief.

THE COSHOCTON LAND SURVEYING SERVICE
 REGISTERED SURVEYOR 5935
 REGISTERED ENGINEER 57405

BRUNING 40-21 28409