

SALT CREEK TOWNSHIP
N. W. QTR. SEC. 33
TWP. - 15 RANGE - 12
HOLMES COUNTY
OHIO

RECT: April 2, 1973

AT 3:32 O'CLOCK PM

RECORDED: April 3, 1973

HOLMES CO. Vol 7 PG. 10

FEE: \$ 2.00


Richard Crane RECORDER
Deed Vol. 183-Pg. 449

VOL 7 PAGE 10

SURVEY FOR
DAVID M. MILLER

FEB. 1973

T.R. #439

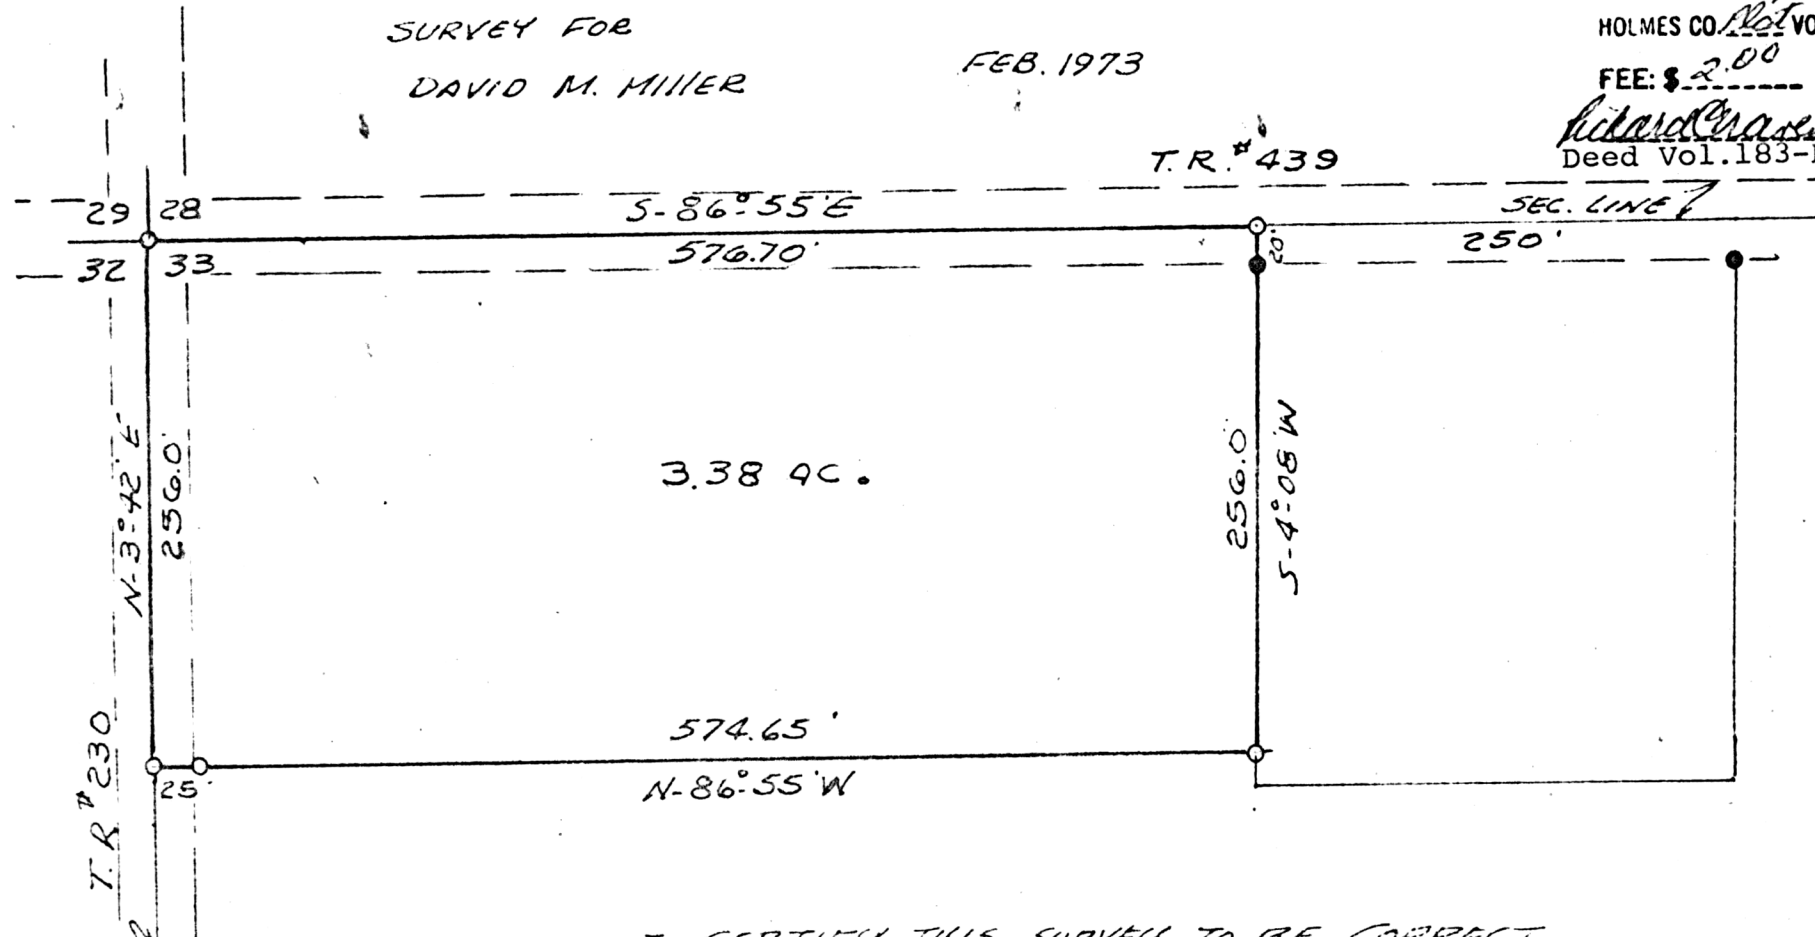

I CERTIFY THIS SURVEY TO BE CORRECT
TO THE BEST OF MY KNOWLEDGE.

Clyde E. Purdy
CLYDE E. PURDY R.S. #4900

SCALE
1"=100'

O I.P. SET
● I.P. FOUND

MAP OFFICE COPY