

Scale: 1" = 100'

- - Iron Pin Fd.
- - Iron Pin Set

100707

REC'D: Jan. 7, 1974


AT 4:31 O'CLOCK PM

RECORDED: Jan. 8, 1974

HOLMES CO. D/P VOL. 7 PG. 185

FEE: \$ 2.00

Richard J. Jones RECORDER
(D. G.)

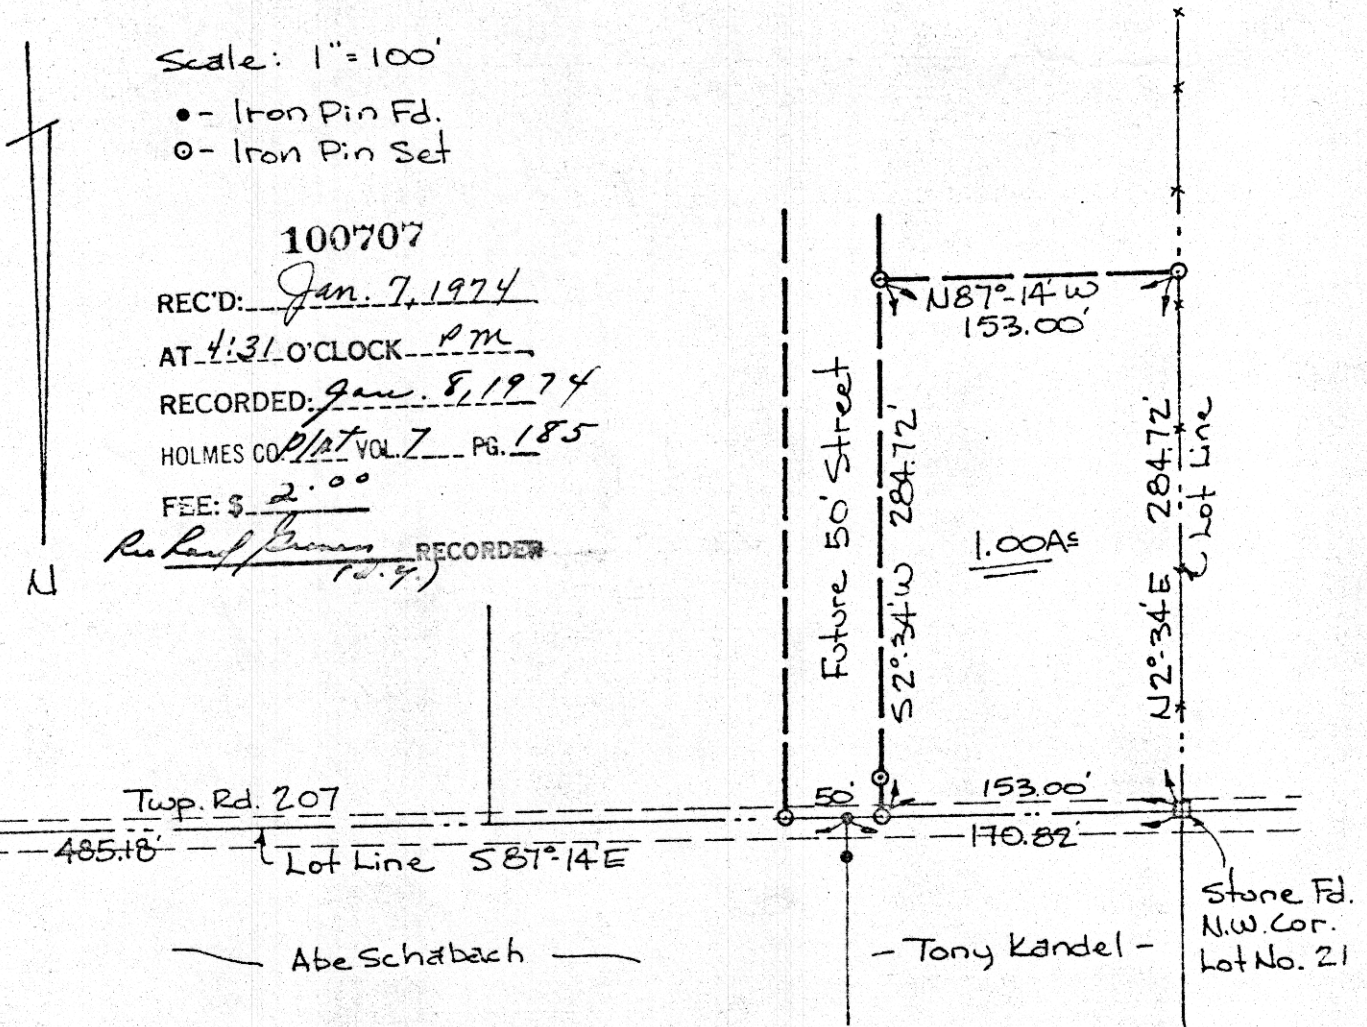

Lot No. 21
 BERLIN TOWNSHIP
 T-9, R-6
 HOLMES COUNTY
 OHIO

Ref. to Stone
 Tele. Marker N.W. 24.9'
 & S.E. 24.3'
 10" Walnut S. 18.7'


Survey for Joe D. Miller
 November 10, 1973

I certify this survey to be correct
 to the best of my knowledge.

George C. Mullet

Reg. Sur. #5796

Job No. S-44-73

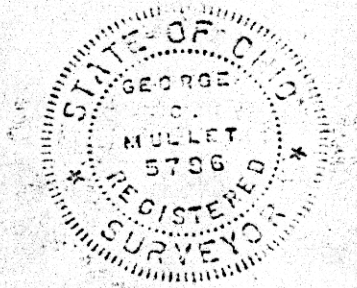

COPY

MAP OFFICE COPY