


ATLEE J. KEIM SURVEY
 LOT 16
 4TH. QTR. TOWNSHIP
 TOWNSHIP 10 RANGE 6
 SALT CREEK TOWNSHIP
 HOLMES COUNTY, OHIO
 COMPLETED 12/8/ 1973

101482

REC'D: April 25, 1974
 AT 11:26 D'CLOCK AM
 RECORDED: April 25, 1974
 HOLMES CO. Plat VOL 7 PG. 232
 FEE: \$ 2.00
Richard Brannon RECORDER
 (N.Y.)
 Deed Vol. 186 Page 885

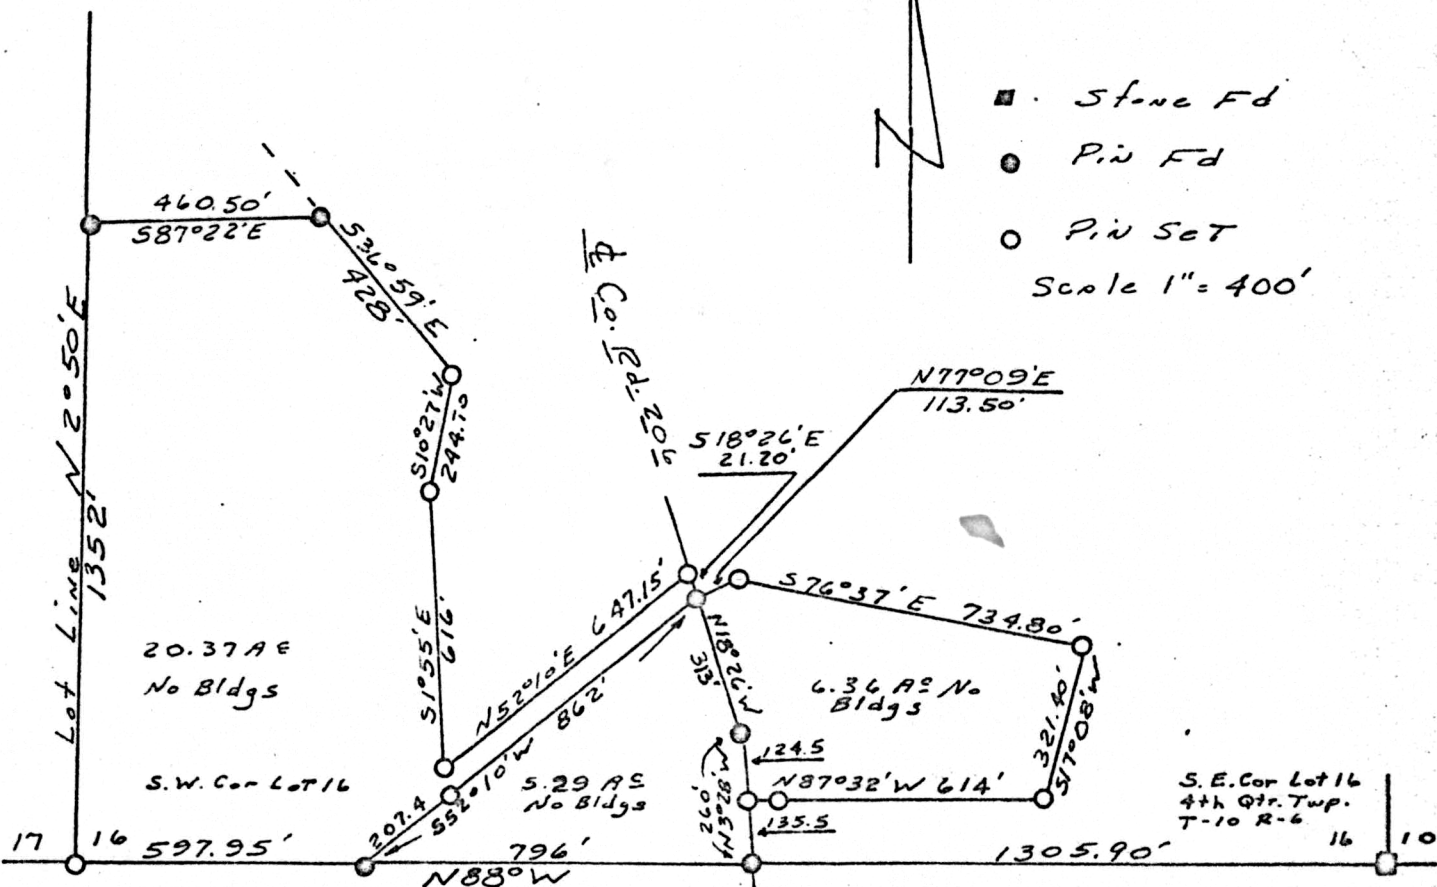

I CERTIFY THIS SURVEY TO BE CORRECT TO THE BEST OF MY KNOWLEDGE AND BELIEF.

SIGNED William T. Burkey
 WILLIAM T. BURKEY
 REGISTERED SURVEYOR #5107
 STATE OF OHIO

MAP OFFICE COPY