


VOL 7 PAGE 280

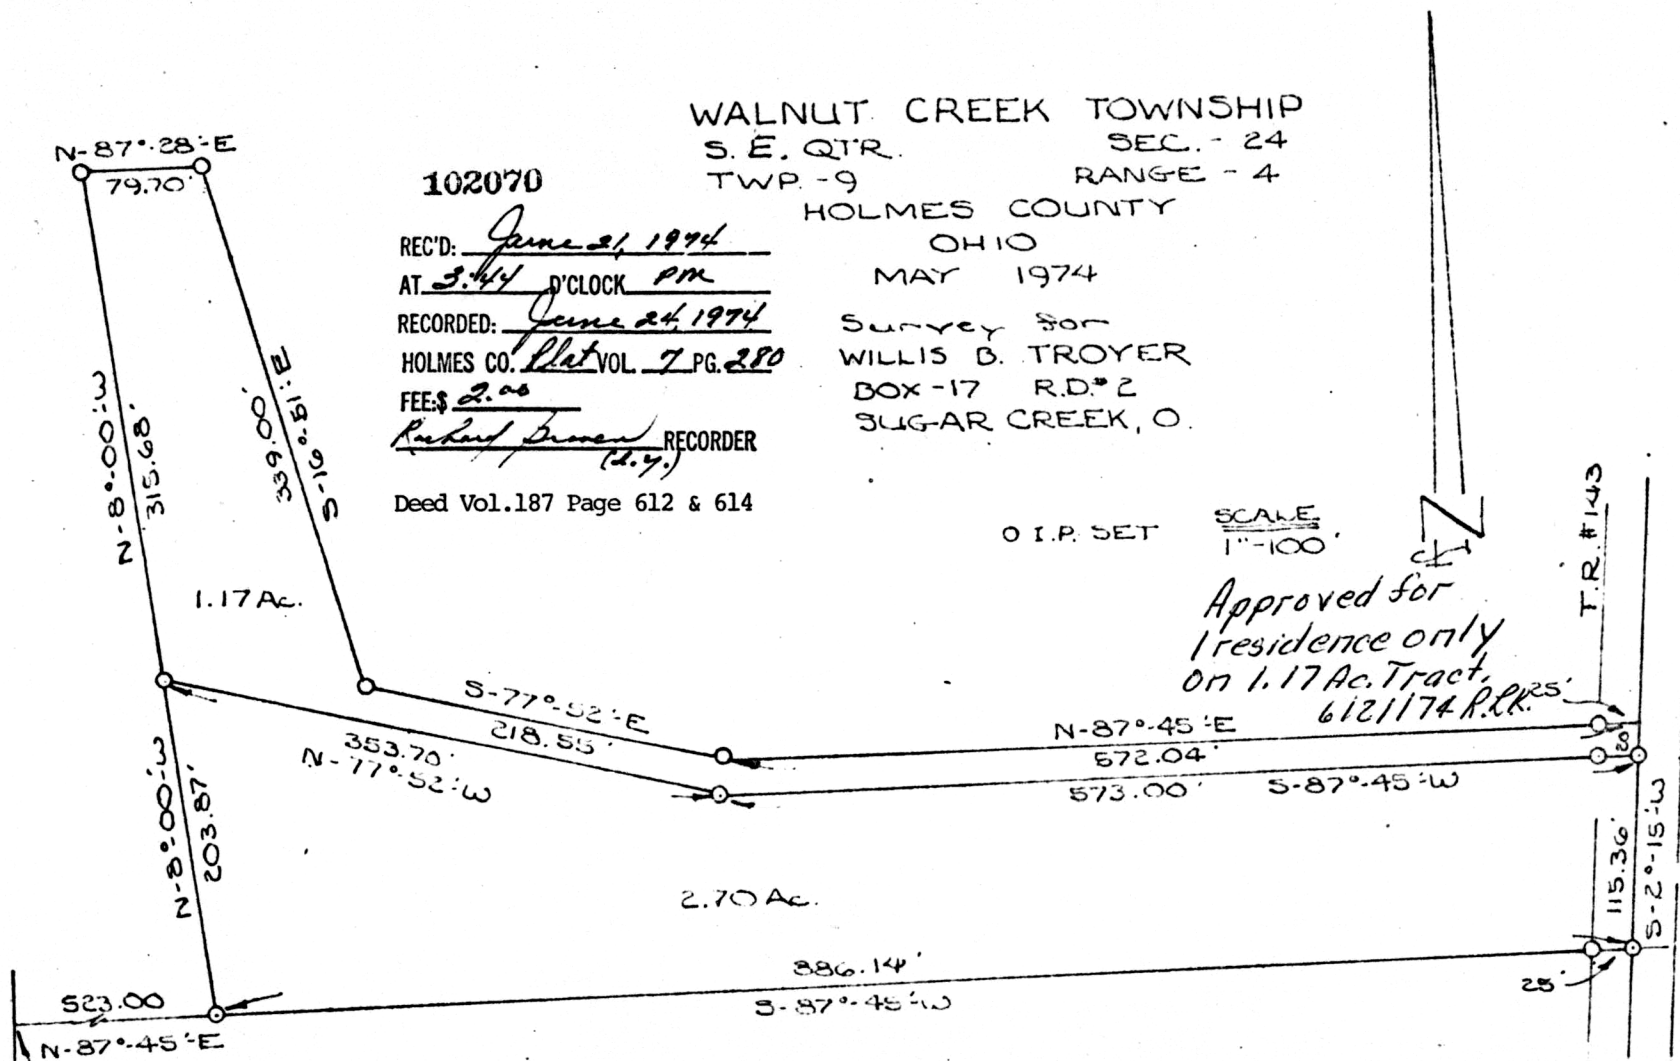

WALNUT CREEK TOWNSHIP
 S. E. QTR. SEC. - 24
 TWP. - 9 RANGE - 4
 HOLMES COUNTY
 OHIO

102070

REC'D: June 21, 1974
 AT 3:44 O'CLOCK PM
 RECORDED: June 24, 1974
 HOLMES CO. Plat VOL. 7 PG. 280
 FEES \$ 2.00
Richard Brown RECORDER
 (2.7.)

MAY 1974
 Survey for
 WILLIS D. TROYER
 BOX - 17 R.D. # 2
 SUGAR CREEK, O.

Deed Vol. 187 Page 612 & 614

O.I.P. SET SCALE 1"=100'

Approved for
 residence only
 on 1.17 Ac. Tract
 612/174 R.R.

S.W. COR.
 N. HALF
 S. E. QTR.
 SEC. - 24

I CERTIFY THIS SURVEY TO BE CORRECT
 TO THE BEST OF MY KNOWLEDGE.

Clyde E. Purdy
 CLYDE E. PURDY R.S.#

MAP OFFICE COPY