

3240 Shelly Blvd.
Wooster, Ohio 44691

Land Surveying
Telephone 345-7785




WM. TERRY BURKEY SURVEYING

102698

REC'D: Aug. 28, 1974 ALBERTA B. DAVIS SURVEY
 AT 12:17 D'CLOCK P.M. NORTH WEST QTR. SEC. 3
 RECORDED: Aug. 29, 1974 TOWNSHIP 19 RANGE 15
 HOLMES CO. Plot VOL. 7 PG. 321 WASHINGTON TOWNSHIP
 HOLMES COUNTY, OHIO
 FEES 2.00 COMPLETED DEC. 30, 1972

Richard Straven RECORDER


Deed Vol. 188 Page 411

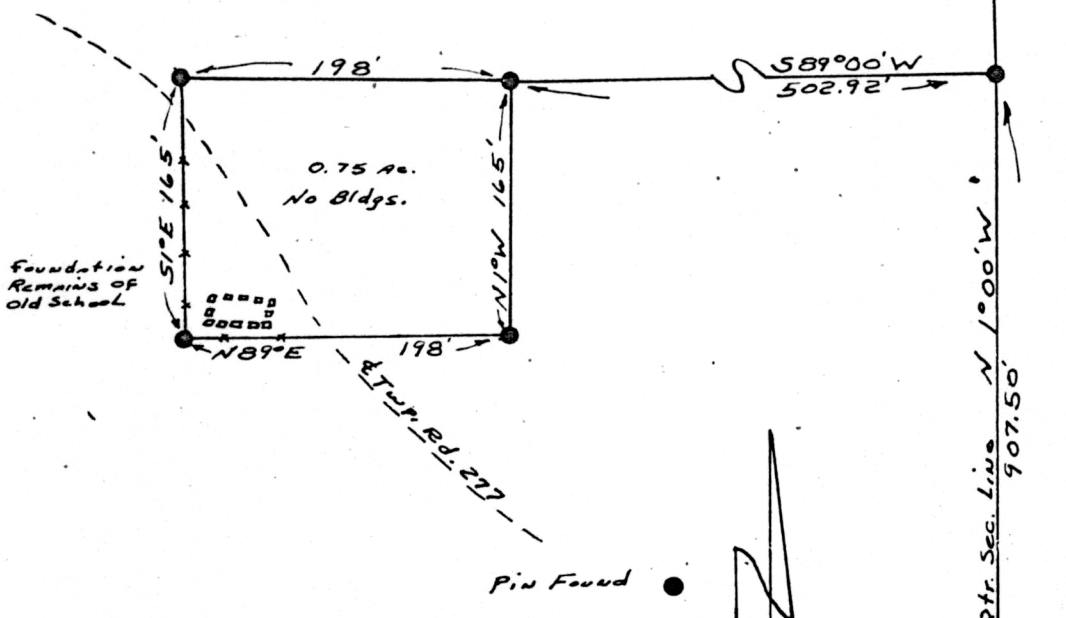

I CERTIFY THIS SURVEY TO BE CORRECT TO THE BEST OF MY KNOWLEDGE AND BELIEF.

SIGNED William T. Burkey
 WILLIAM T. BURKEY
 REGISTERED SURVEYOR #5107
 STATE OF OHIO

S.E. Cor.
 N.W. Qtr.
 Sec. 3
 T-19 R-15

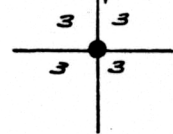

MAP OFFICE COPY