
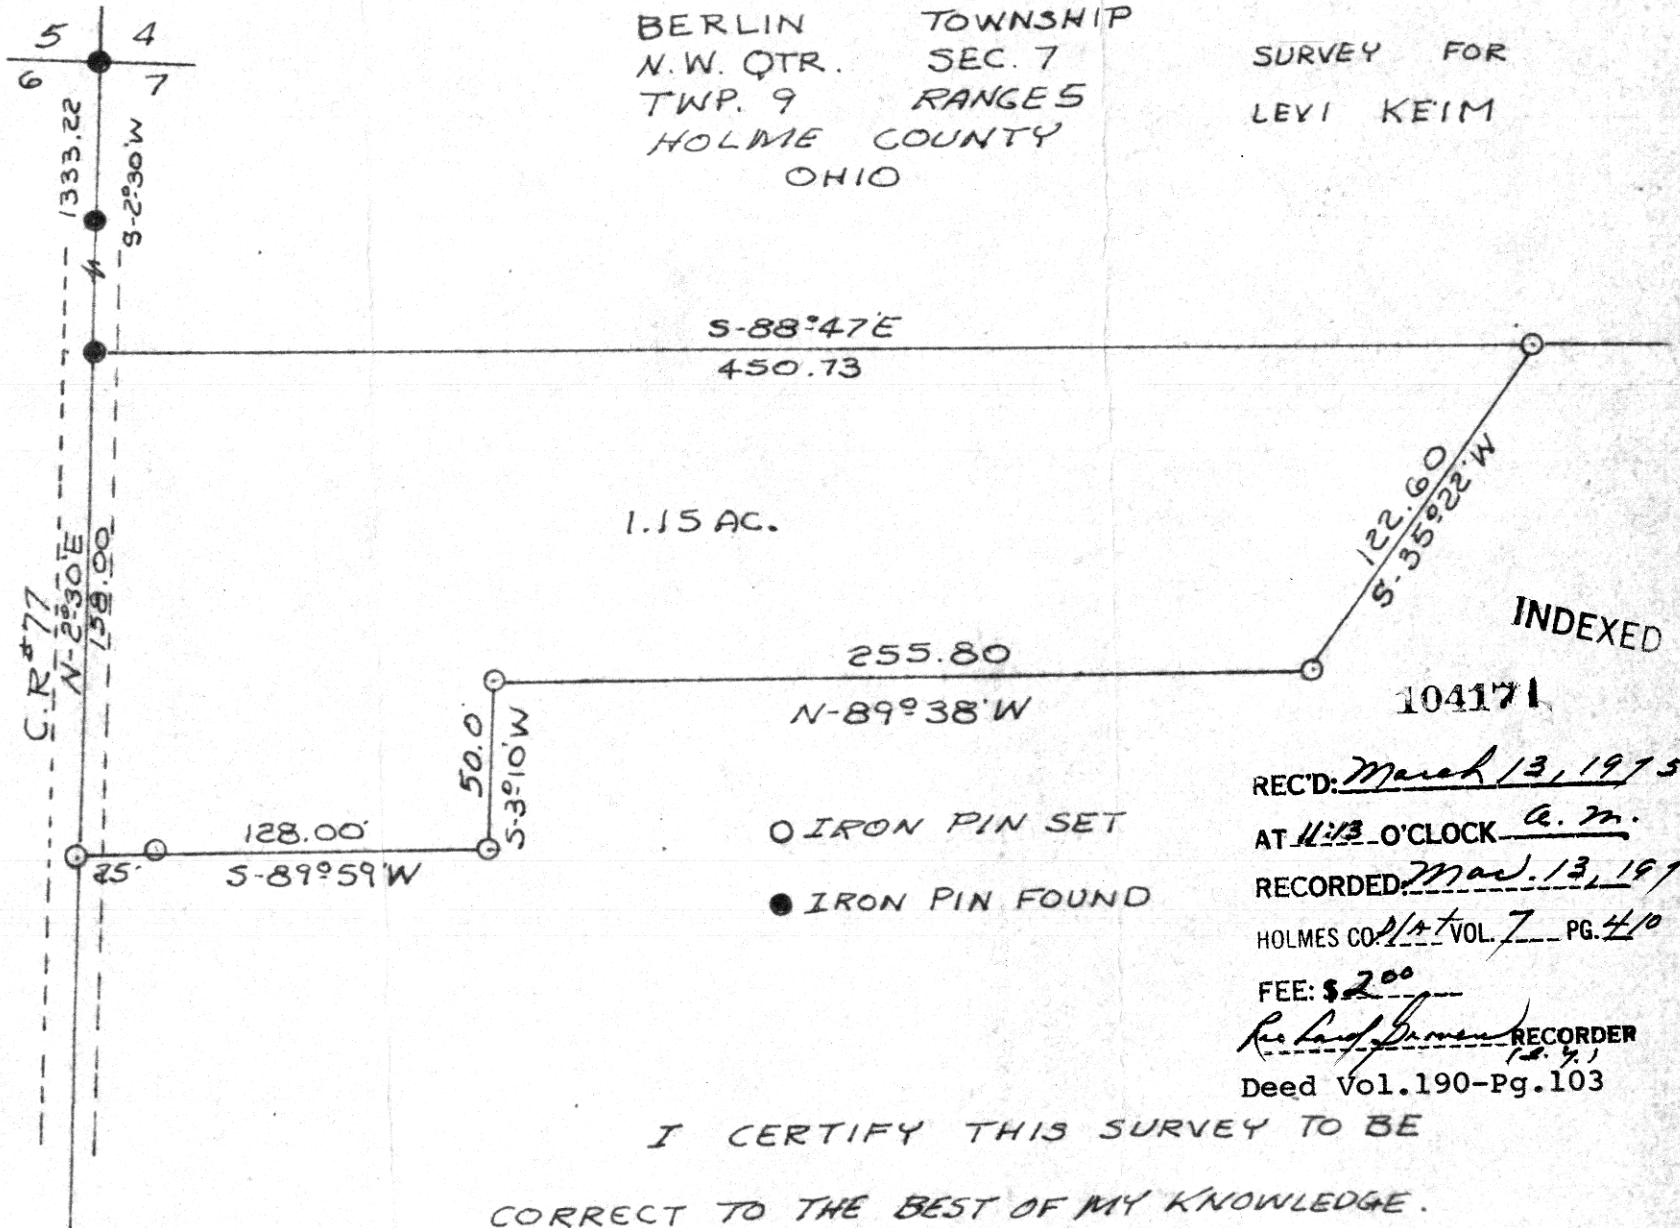


JAN. 1975

BERLIN TOWNSHIP  
N.W. QTR. SEC. 7  
TWP. 9 RANGES  
HOLMES COUNTY  
OHIO

SURVEY FOR  
LEVI KEIM

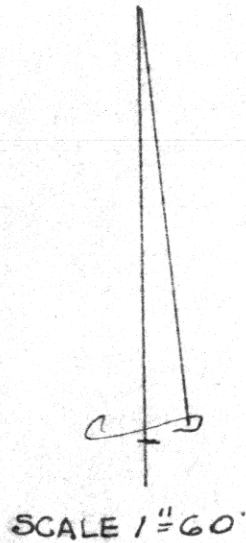

1.15 AC.

INDEXED

104171

- IRON PIN SET
- IRON PIN FOUND

REC'D: March 13, 1975  
 AT 11:13 O'CLOCK a.m.  
 RECORDED: Mar. 13, 1975  
 HOLMES CO. 1/2 VOL. 7 PG. 4/10  
 FEE: \$2.00  
Richard J. ... RECORDER  
 (Feb. 4, 1975)  
 Deed Vol. 190-Pg. 103

I CERTIFY THIS SURVEY TO BE  
CORRECT TO THE BEST OF MY KNOWLEDGE.

Clyde E. Purdy  
CLYDE E. PURDY R.S. #4900

MAP OFFICE COPY