

# WM. TERRY BURKEY SURVEYING

MOSES B. MAST SURVEY  
N. W. QUARTER SEC. 19  
TOWNSHIP 9 RANGE 5  
WALNUT CREEK TOWNSHIP  
HOLMES COUNTY, OHIO  
COMPLETED JUNE 7, 1975

**INDEXED 105029**

REC'D: June 27, 1975

AT 3:01 O'CLOCK P.M.

RECORDED: June 30, 1975


HOLMES CO. Pla VOL. 7 PG. 468

FEE: \$ 2.00

Richard Craven RECORDER

Deed Vol. 191-Pg. 132

2.00 A = No Bldg.

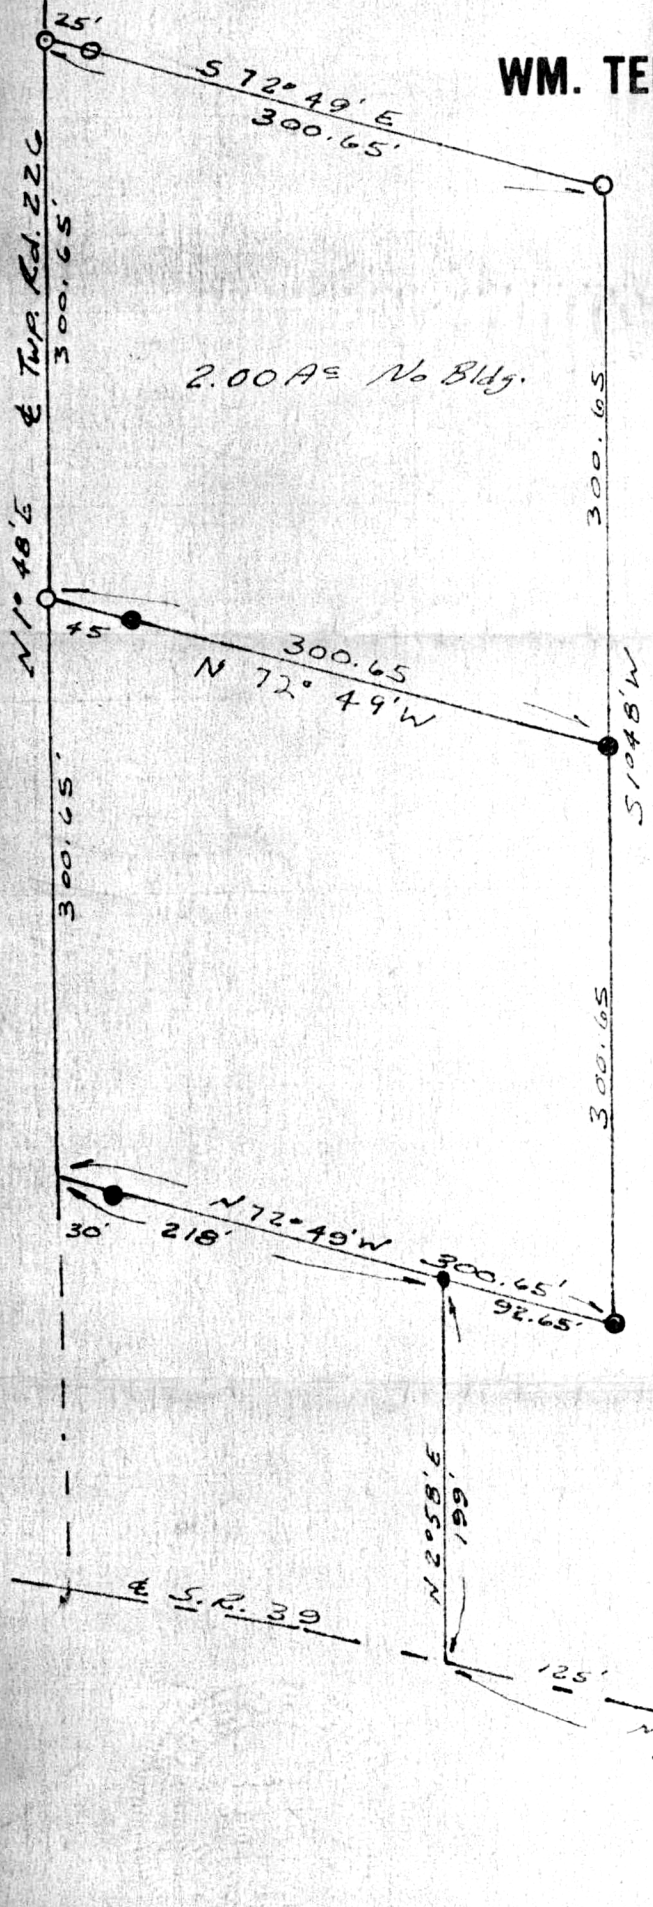

VOL. \_\_\_\_\_

○ Pin Set

● Pin Fd

■ Stone

VOL. \_\_\_\_\_

Scale 1" = 100'

Reference Survey  
Miskimen Eng. & Sur.  
Apr. 2, 1975

I CERTIFY THIS SURVEY TO BE CORRECT TO THE BEST OF MY KNOWLEDGE AND BELIEF.

SIGNED William T. Burkey  
**WILLIAM T. BURKEY**  
REGISTERED SURVEYOR #5107  
STATE OF OHIO

S.E. Cor  
N.W. Qtr.  
Sec. 19  
T-9 R-5  
Walnut Creek  
Twp.

19	19
19	19