

THE COSHOCTON LAND SURVEYING SERVICE

233 S. FOURTH ST.


COSHOCTON, OHIO 43812

BEING PART OF:	LOT 1	~
	SEC. ~	1
	QUAR. 4 <sup>th</sup>	1 <sup>st</sup>
	T 9 N, R 9 W U.S.M.L.	T. 8 N, R. 9 W. U.S.M.L.
	TOWNSHIP Knox	Richland
	COUNTY Holmes	

SURVEY FOR: Dean Boyd

DATE: Sept. 1975

SCALE: 1" = 200'

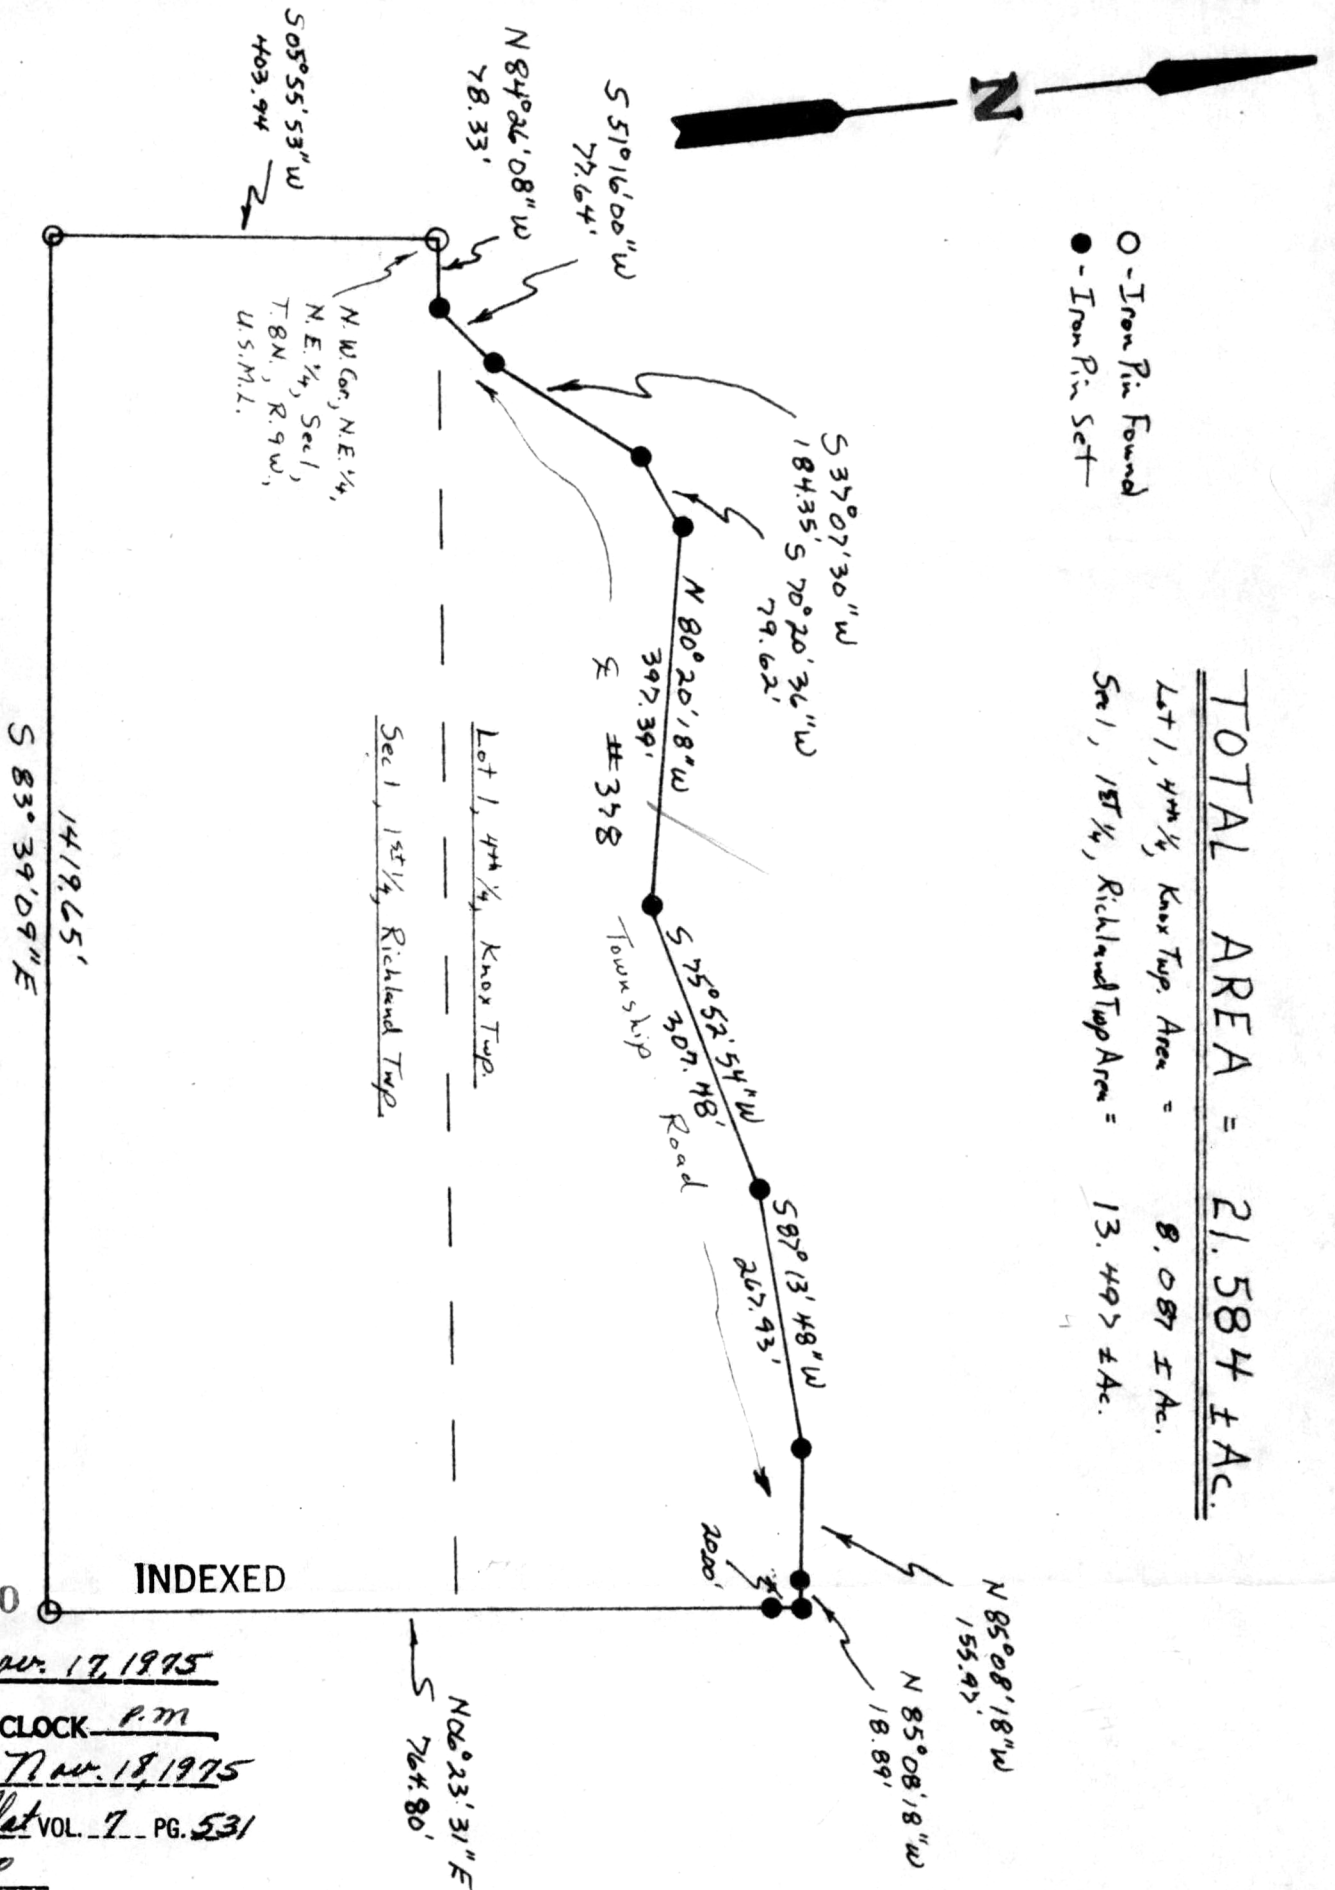

**TOTAL AREA = 21.584 ± Ac.**

Lot 1, 4<sup>th</sup> 1/4, Knox Twp. Area = 8.087 ± Ac.  
 Sec 1, 1<sup>st</sup> 1/4, Richland Twp. Area = 13.497 ± Ac.

106190 INDEXED

REC'D: Nov. 17, 1975  
 AT 2:19 O'CLOCK P.M.  
 RECORDED: Nov. 18, 1975  
 HOLMES CO. Plat VOL. 7 PG. 531  
 FEE: \$ 2.00

Richard Brown RECORDER

Deed Vol. 192- I hereby certify the above plat to be correct to the best of my knowledge and belief. Pg. 399

**MAP OFFICE COPY**

THE COSHOCTON LAND SURVEYING SERVICE

John E. Smith  
 REGISTERED SURVEYOR 5935