

# THE COSHOCTON LAND SURVEYING SERVICE

233 S. FOURTH ST.


COSHOCTON, OHIO 43812

BEING PART OF: LOT ~  
 SEC. 23  
 QUAR. 3<sup>rd</sup>  
 T9N, R9W U.S.M.L.  
 TOWNSHIP Knox  
 COUNTY Holmes

SURVEY FOR: William Grassbaugh

DATE: Aug 9, 1975

SCALE: 1" = 200'

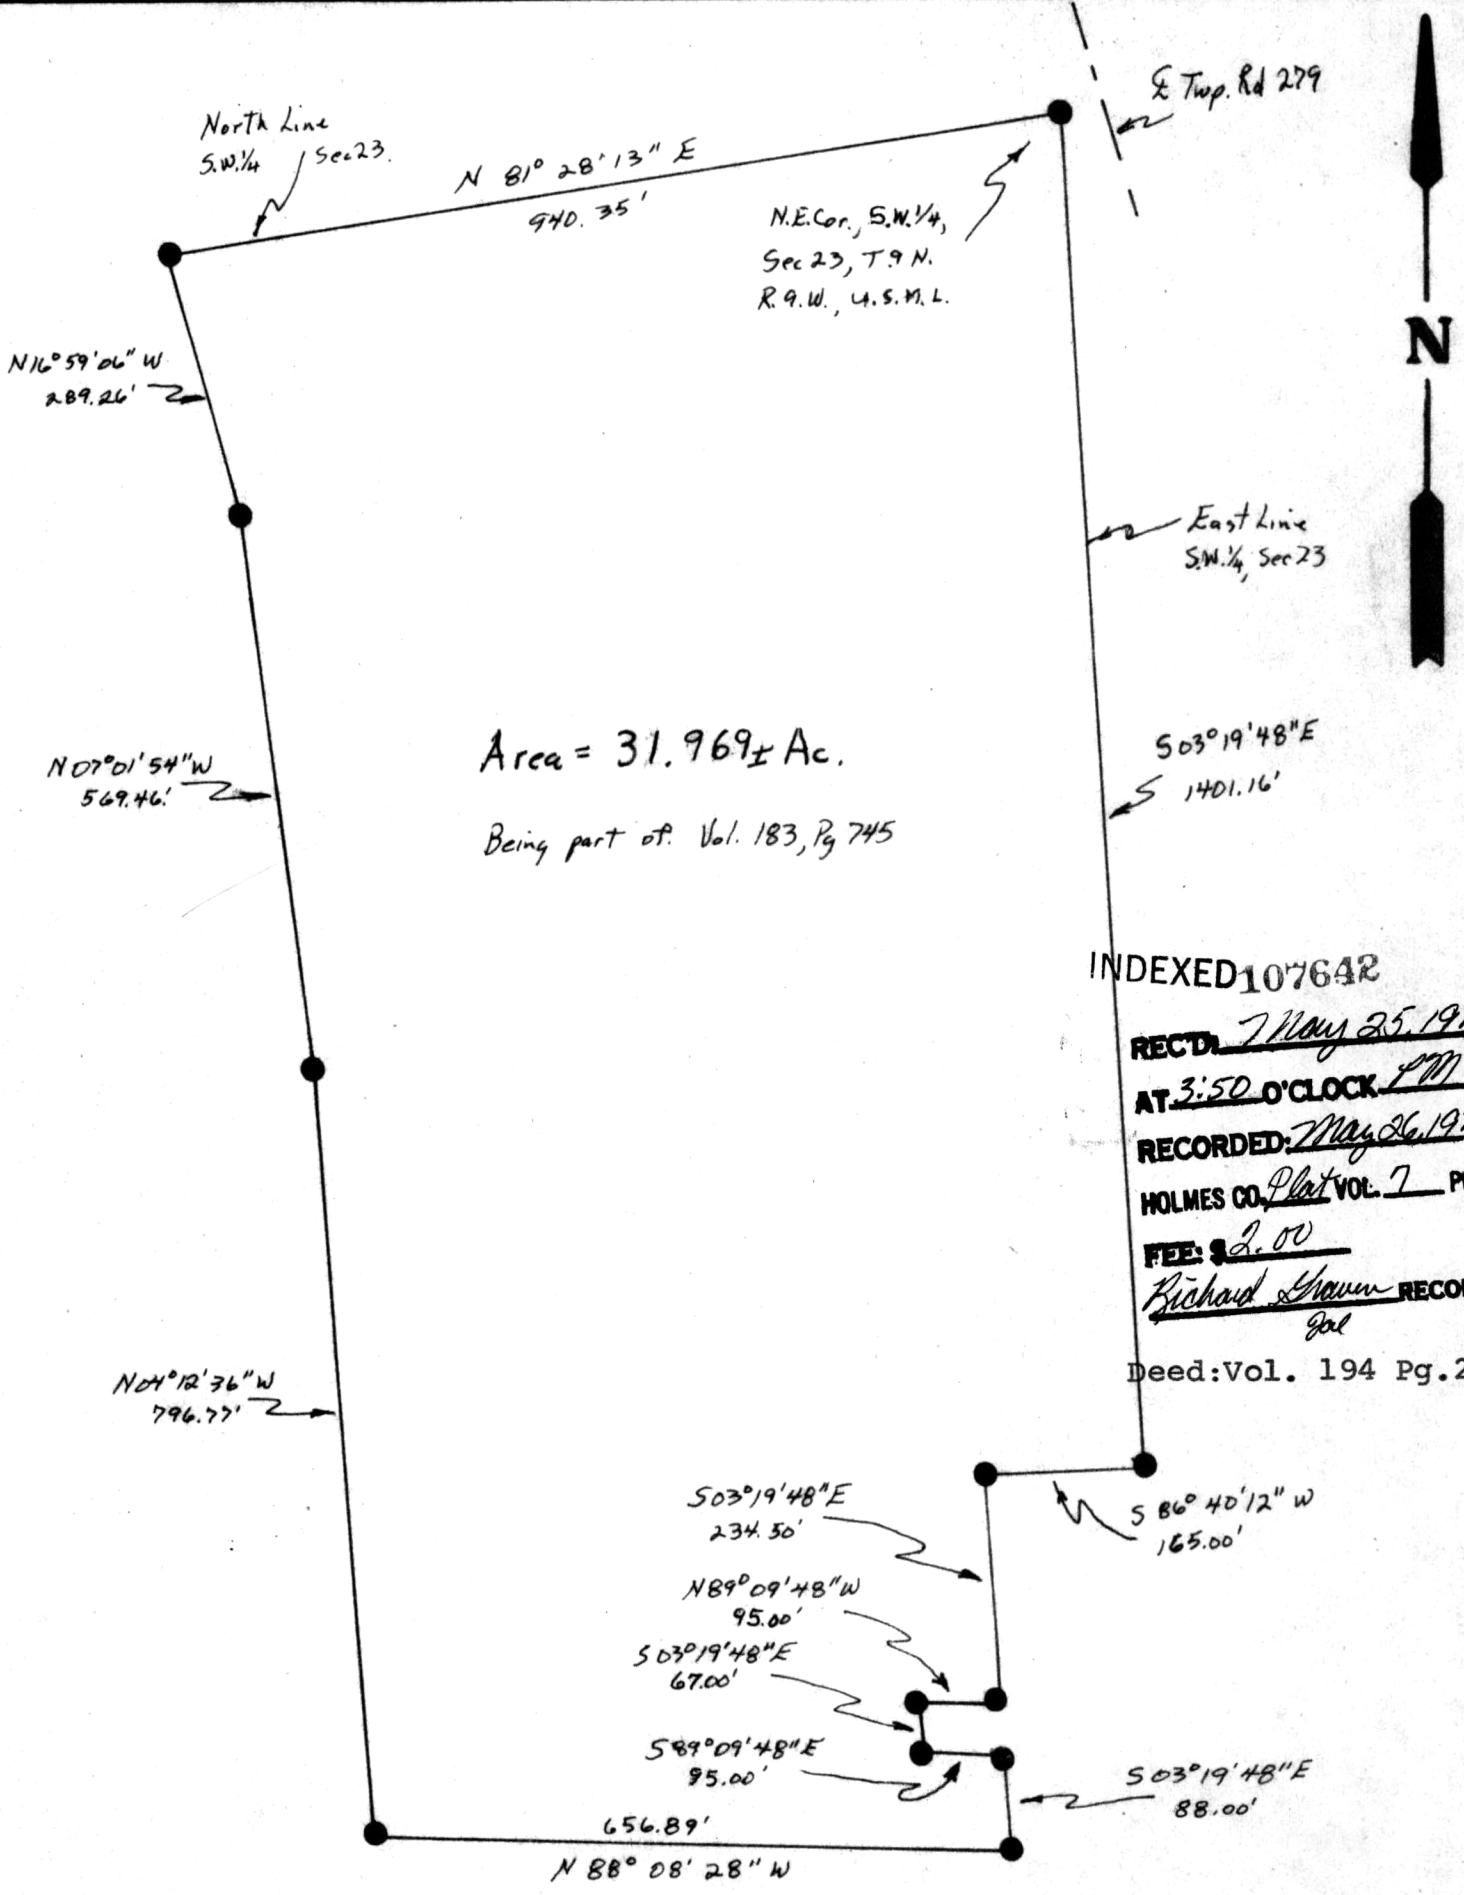

Area = 31.969± Ac.  
 Being part of Vol. 183, Pg 745

INDEXED 107642

REC'D May 25, 1976  
 AT 3:50 O'CLOCK PM  
 RECORDED: May 26, 1976  
 HOLMES CO. Plat VOL. 7 PG. 215  
 FEE: \$ 2.00  
Richard Shaver RECORDER  
 Gal  
 Deed: Vol. 194 Pg. 229

I hereby certify the above plat to be correct to the best of my knowledge and belief.

THE COSHOCTON LAND SURVEYING SERVICE

● - Iron Pin Set

**MAP OFFICE COPY**

*John J. [Signature]*  
 REGISTERED SURVEYOR 5935