

Stone Rd.
N.W. Corner
Lot No. 21


109314

Twp. Rd. 207

Lot Line S87°14'E

REC'D: November 16, 1976
AT 9:52⁰ CLOCK A.M.
RECORDED: November 16, 1976
HOLMES CO. PLAT VOL. 7 PG. 733
FEE: \$ 2.⁰⁰
Richard Haven RECORDER

N

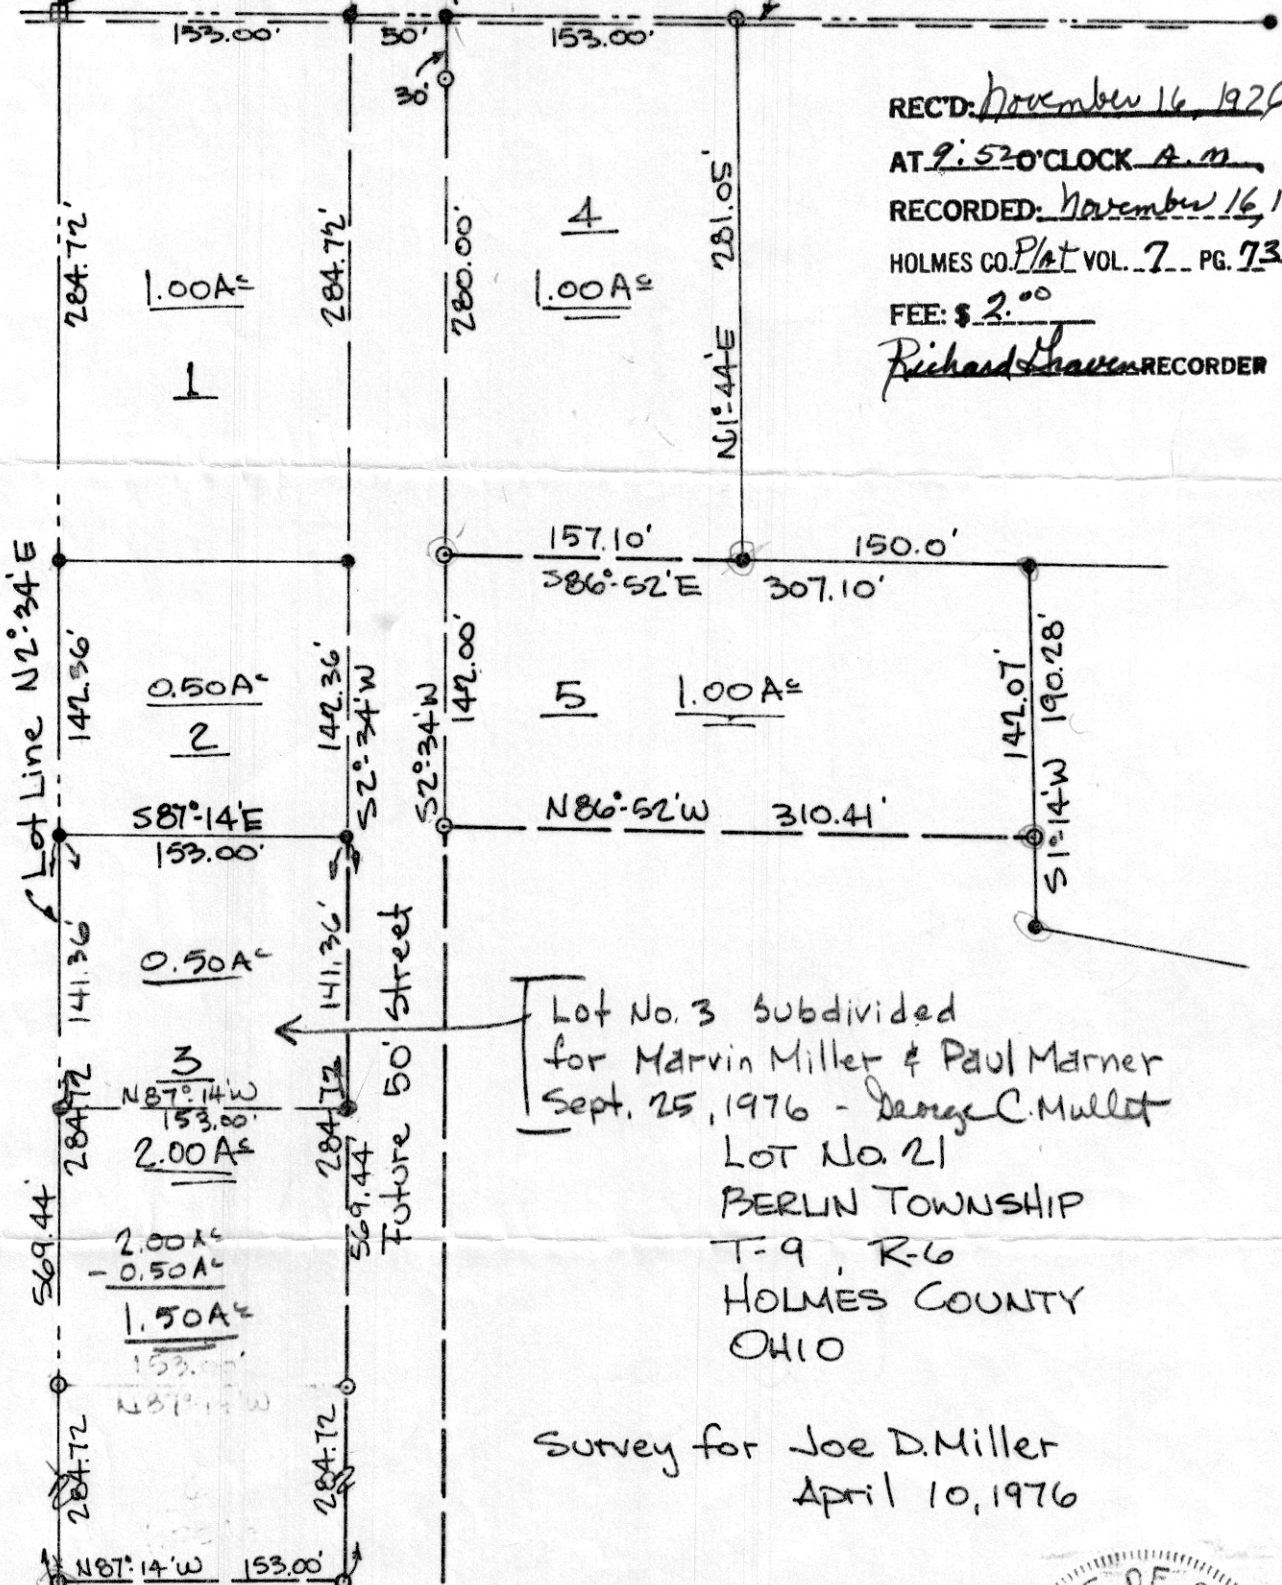

Scale:
1"=100'

Lot No. 3 subdivided
for Marvin Miller & Paul Manner
Sept. 25, 1976 - George C. Mullet
Lot No. 21
BERLIN TOWNSHIP
T-9, R-6
HOLMES COUNTY
OHIO

Survey for Joe D. Miller
April 10, 1976

I certify this survey to be correct
to the best of my knowledge.

George C. Mullet
Reg. Sur. #5796



MAP OFFICE COPY

Job No. S-11-76

Revision: {Lot #3 added} May 29, 1976
1 acres