

# WM. TERRY BURKEY SURVEYING




WILES HAMILTON SURVEY  
EAST HALF SECTION #4  
N.E. QTR. SECTION #9  
TOWNSHIP 19 RANGE 15  
WASHINGTON TOWNSHIP  
HOLMES COUNTY, OHIO  
COMPLETED SEPT. 18, 1976

109878

REC'D: January 21, 1977  
AT 10:25 O'CLOCK A.M.  
RECORDED: January 21, 1977  
HOLMES CO. Plat VOL. 7 PG. 769  
FEE: \$2.00

*Richard Crane* RECORDER  
Deed Vol. 197 Page 88

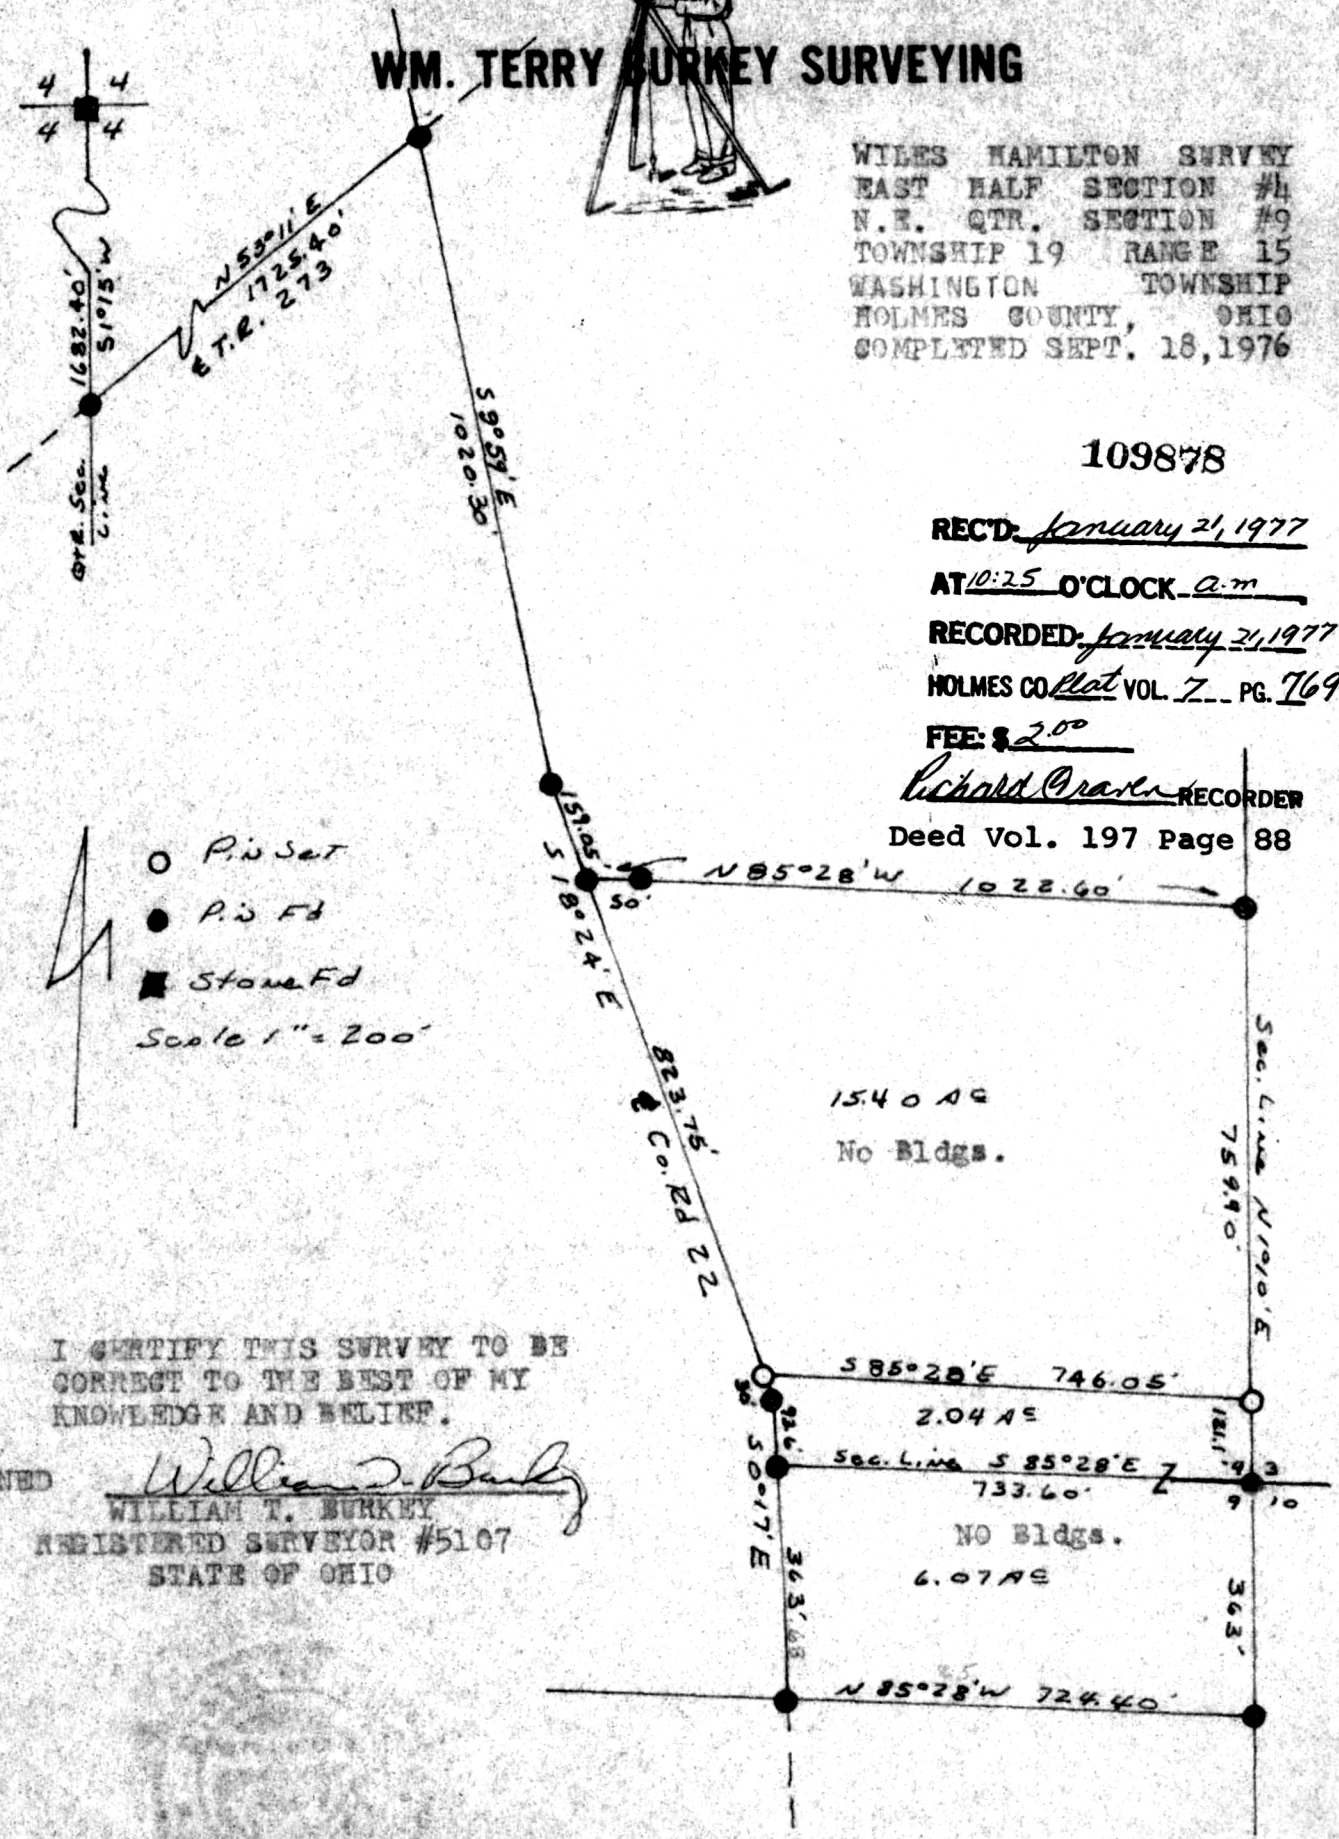

- Pin Set
  - Pin Fd
  - Stone Fd
- Scale 1" = 200'

I CERTIFY THIS SURVEY TO BE  
CORRECT TO THE BEST OF MY  
KNOWLEDGE AND BELIEF.

SIGNED William T. Burkey  
WILLIAM T. BURKEY  
REGISTERED SURVEYOR #5107  
STATE OF OHIO

## MAP OFFICE COPY