
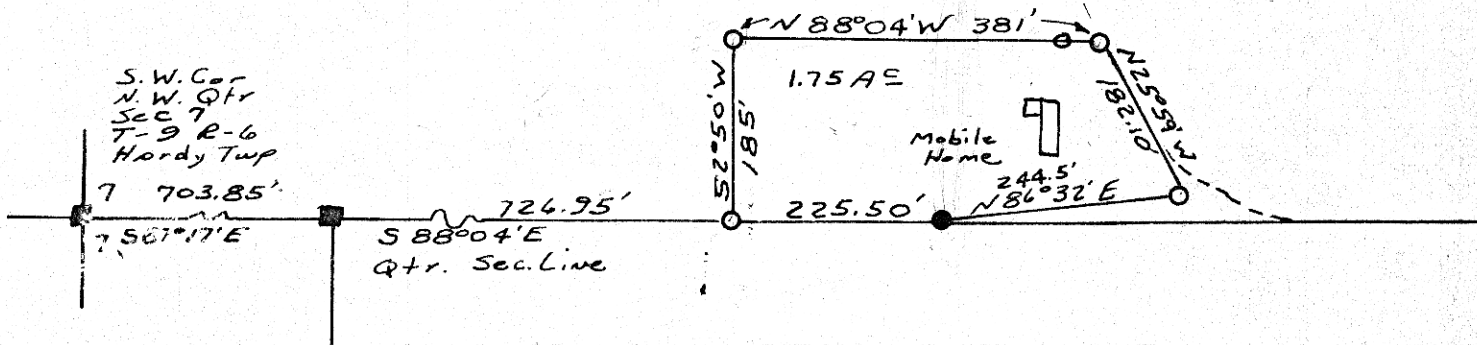


MILLER-COBLENTZ SURVEY
 N. W. QTR. SECTION 7
 TOWNSHIP 9 RANGE 6
 HARDY TOWNSHIP
 HOLMES COUNTY, OHIO
 COMPLETED 12/1/1973

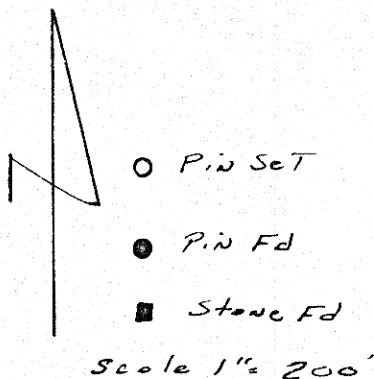

I CERTIFY THIS SURVEY MADE FOR HENRY C. MILLER AND
 LESTER COBLENTZ TO BE CORRECT TO THE BEST OF MY KNOWLEDGE
 AND BELIEF.

SIGNED William T. Burkey
 WILLIAM T. BURKEY
 REGISTERED SURVEYOR #5107
 STATE OF OHIO

100128

APPROVED
 BY
 THE HOLMES COUNTY HEALTH DEPARTMENT
 BY Henry Stuebel K6P
 DATE 2/22/77

REC'D: March 3, 1977
 AT 2:35 O'CLOCK P.M.
 RECORDED: March 4, 1977
 HOLMES CO. plat VOL. 7 PG. 780
 FEE: \$ 2.00

Richard Graver RECORDED
 Deed Vol. 197-Pg. 360
J. Wallman