


N

• - I.P. Set all corners
Scale: 1" = 200'

S.E. & S.W. QUARTERS - SECTION 18
WASHINGTON TOWNSHIP
N.E. & N.W. QUARTERS - SECTION 19
KNOX TOWNSHIP
T. 19, R. 15
HOLMES COUNTY, OHIO

Survey for Phillip Boreman
March 1977

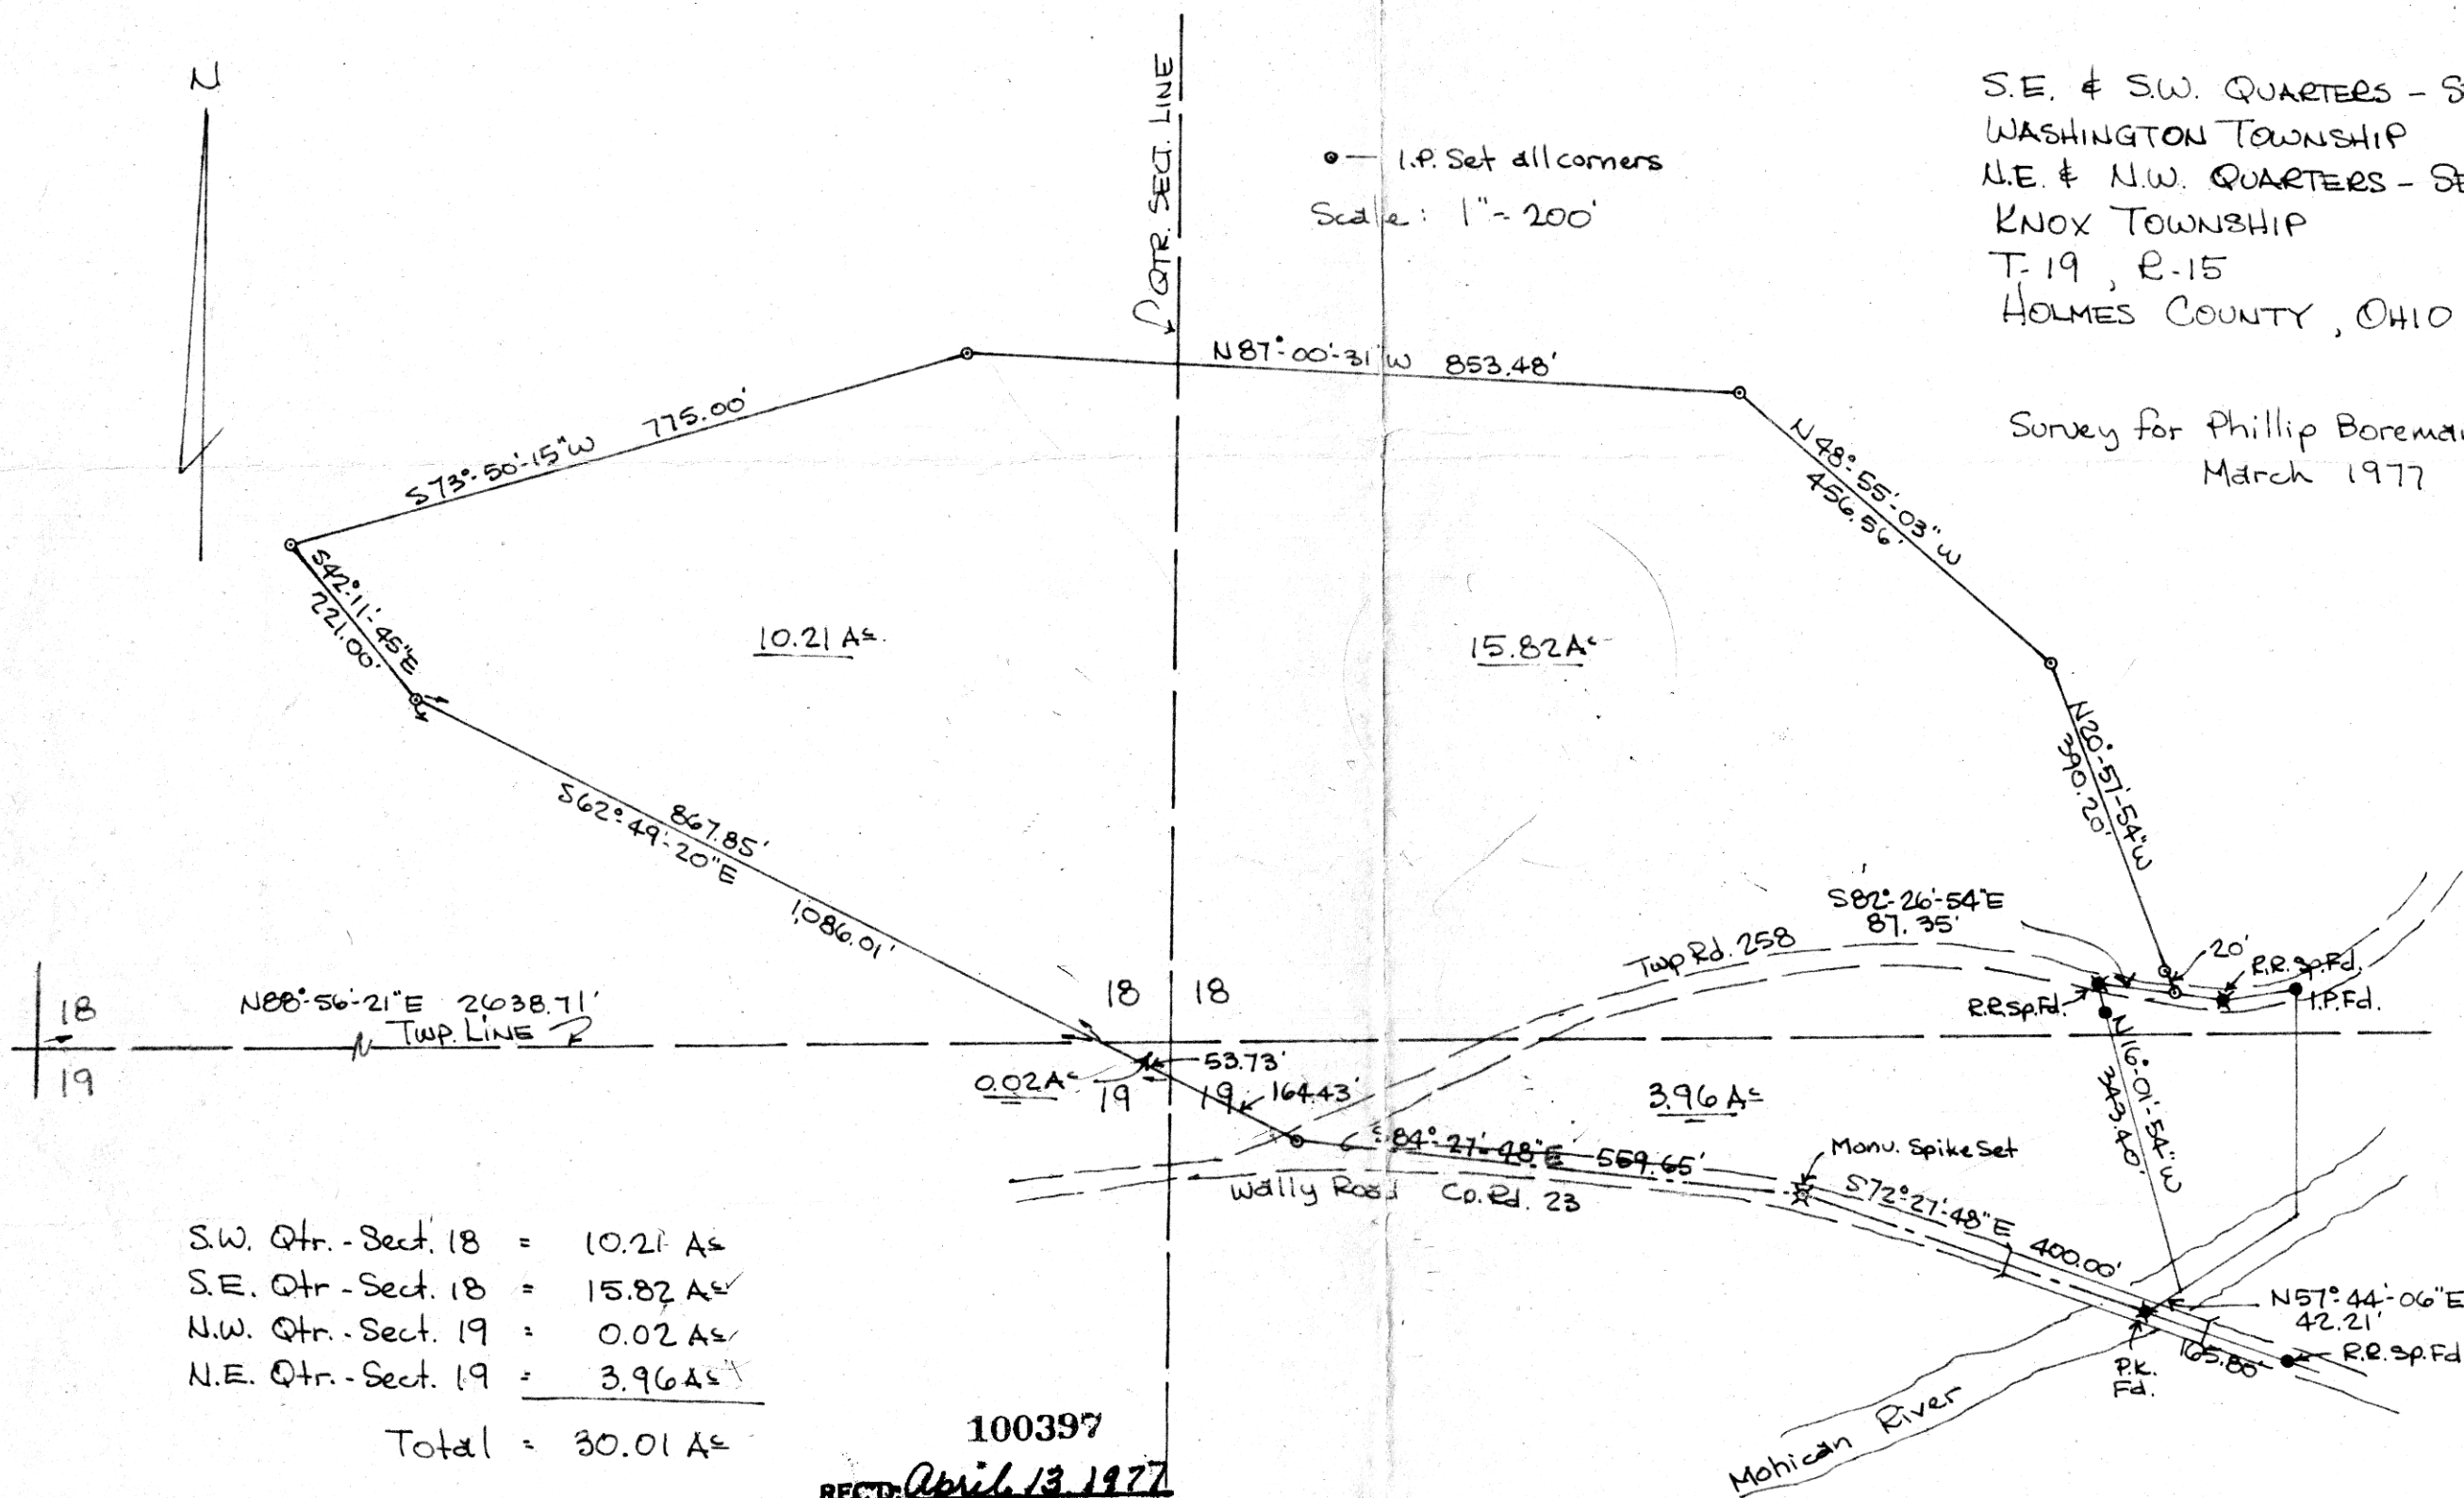

S.W. Qtr. - Sect. 18	=	10.21 Acs
S.E. Qtr. - Sect. 18	=	15.82 Acs
N.W. Qtr. - Sect. 19	=	0.02 Acs
N.E. Qtr. - Sect. 19	=	3.96 Acs
Total	=	30.01 Acs

100397

REC'D April 13, 1977

AT 11:27 O'CLOCK

RECORDED April 13, 1977

HOLMES CO. Plat VOL. 7. PG. 192

FEE: \$ 3.74

Richard Weaver, RECORDER


11x17 x 2

Deed Vol. 197 Page 593

I certify this survey to be correct
to the best of my knowledge.

George C. Mullet

Reg. Sur. # 5796

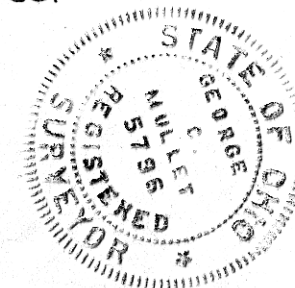

MAP OFFICE COPY