

BEING PART OF: LOT 3 & 7
 SEC. 26
 QUAR. 200
 T 9 N. R 9 W
 TOWNSHIP KNOT
 COUNTY HOLMES

THE COSHOCTON LAND SURVEYING SERVICE

233 S. FOURTH ST.


COSHOCTON, OHIO 43812

BUCKHORN ENERGY CO.
 SURVEY FOR:
 DATE: 8-77
 SCALE: 1" = 100'

Revised: Sept 1978
 Show R/W into Tract #9

GREENVILLE TREATY ESTATES - PART. 2

BEING A PART OF THE LAND CONVEYED TO THE BUCKHORN ENERGY CO. BY JONAS WEAVER IN V. 198, P. 526

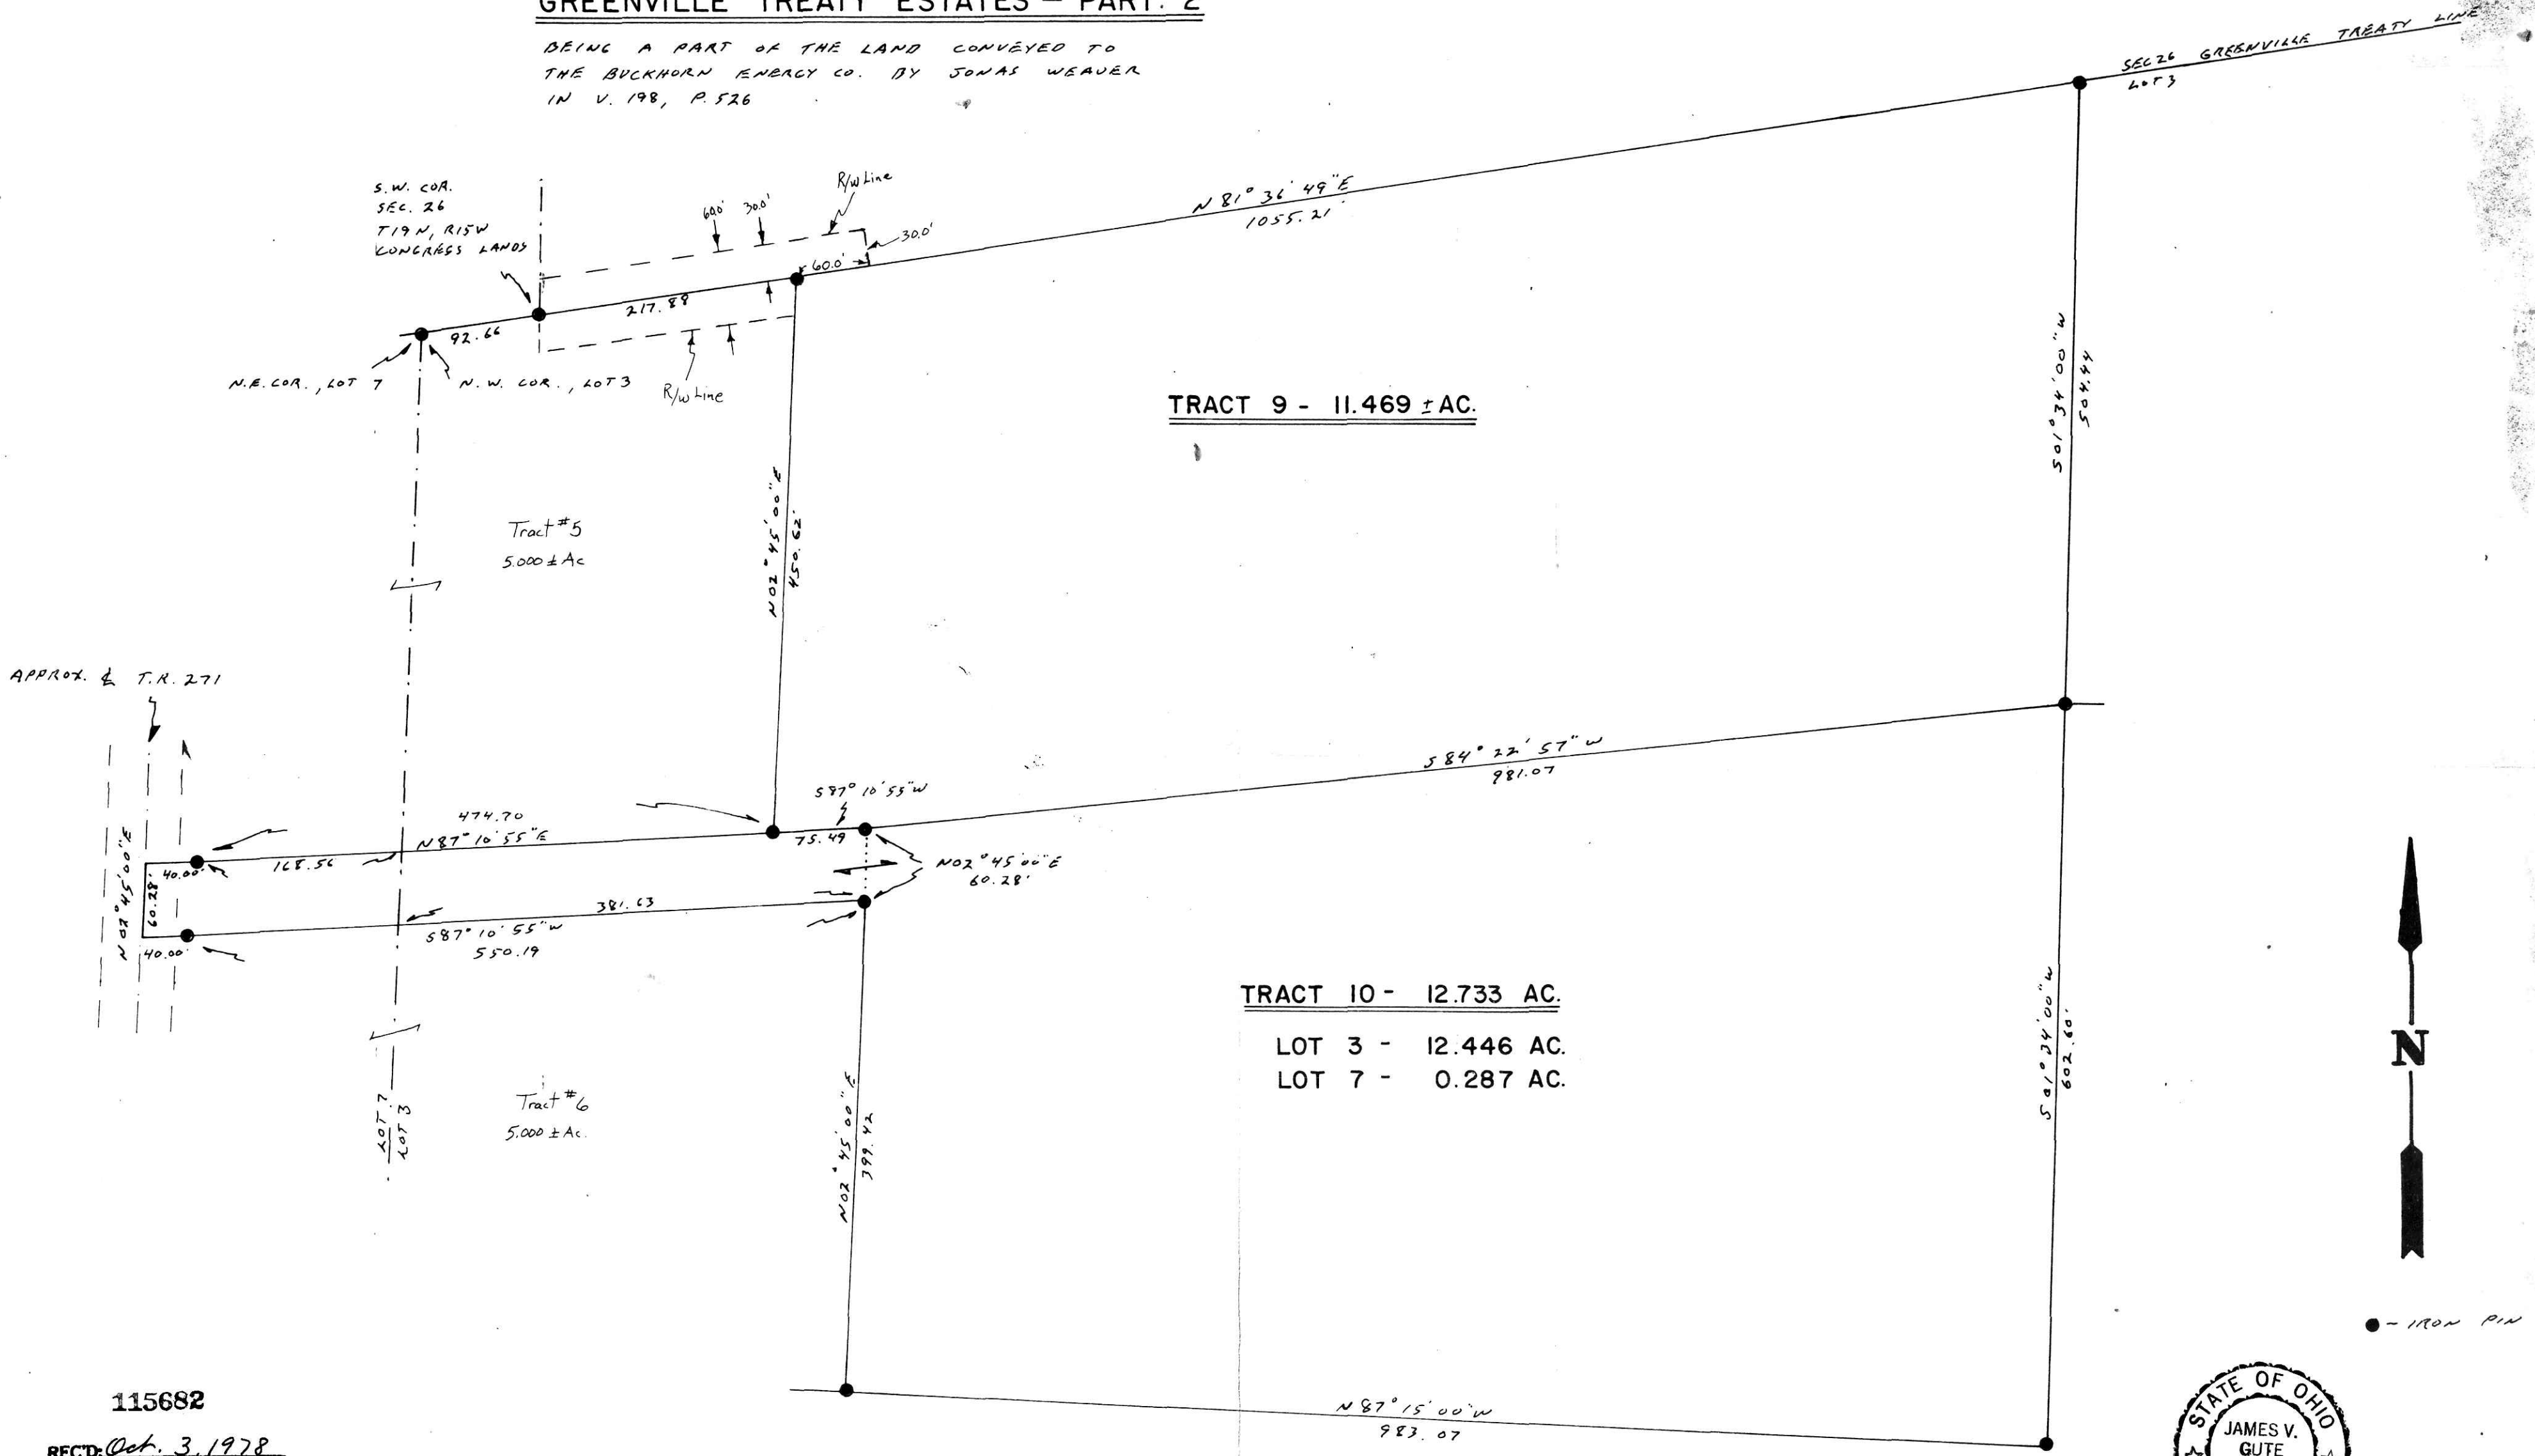

TRACT 10 - 12.733 AC.
 LOT 3 - 12.446 AC.
 LOT 7 - 0.287 AC.



- IRON PIN



I hereby certify the above plat to be correct to the best of my knowledge and belief.

THE COSHOCTON LAND SURVEYING SERVICE

REGISTERED SURVEYOR 5935
 REGISTERED ENGINEER 37405

115682

REC'D Oct. 3, 1978
 AT 2:59 O'CLOCK P.M.
 RECORDED Oct. 4, 1978
 HOLMES CO. Plat VOL. 9 - PG. 3
 FEE: \$7.14
 Richard Stearns RECORDER
 17X21X2
 Deed Vol. 203-Pg. 505

BRUNING 40-21 28409