


BEING PART OF
LOT 2
SEC 11
QUAR 1st & 2nd
T 8 N. R 8 W. U.S.M.L.
TOWNSHIP KILLBUCK
COUNTY Holmes

THE COSHOCTON LAND SURVEYING SERVICE
233 S. FOURTH ST.
COSHOCTON, OHIO 43812

SURVEY FOR: Dean Boyd
DATE: Sept 25, 1978
SCALE: 1" = 200'



- - Iron Pin Found
- - Iron Pin Set
- ▲ - Found Spike Nail

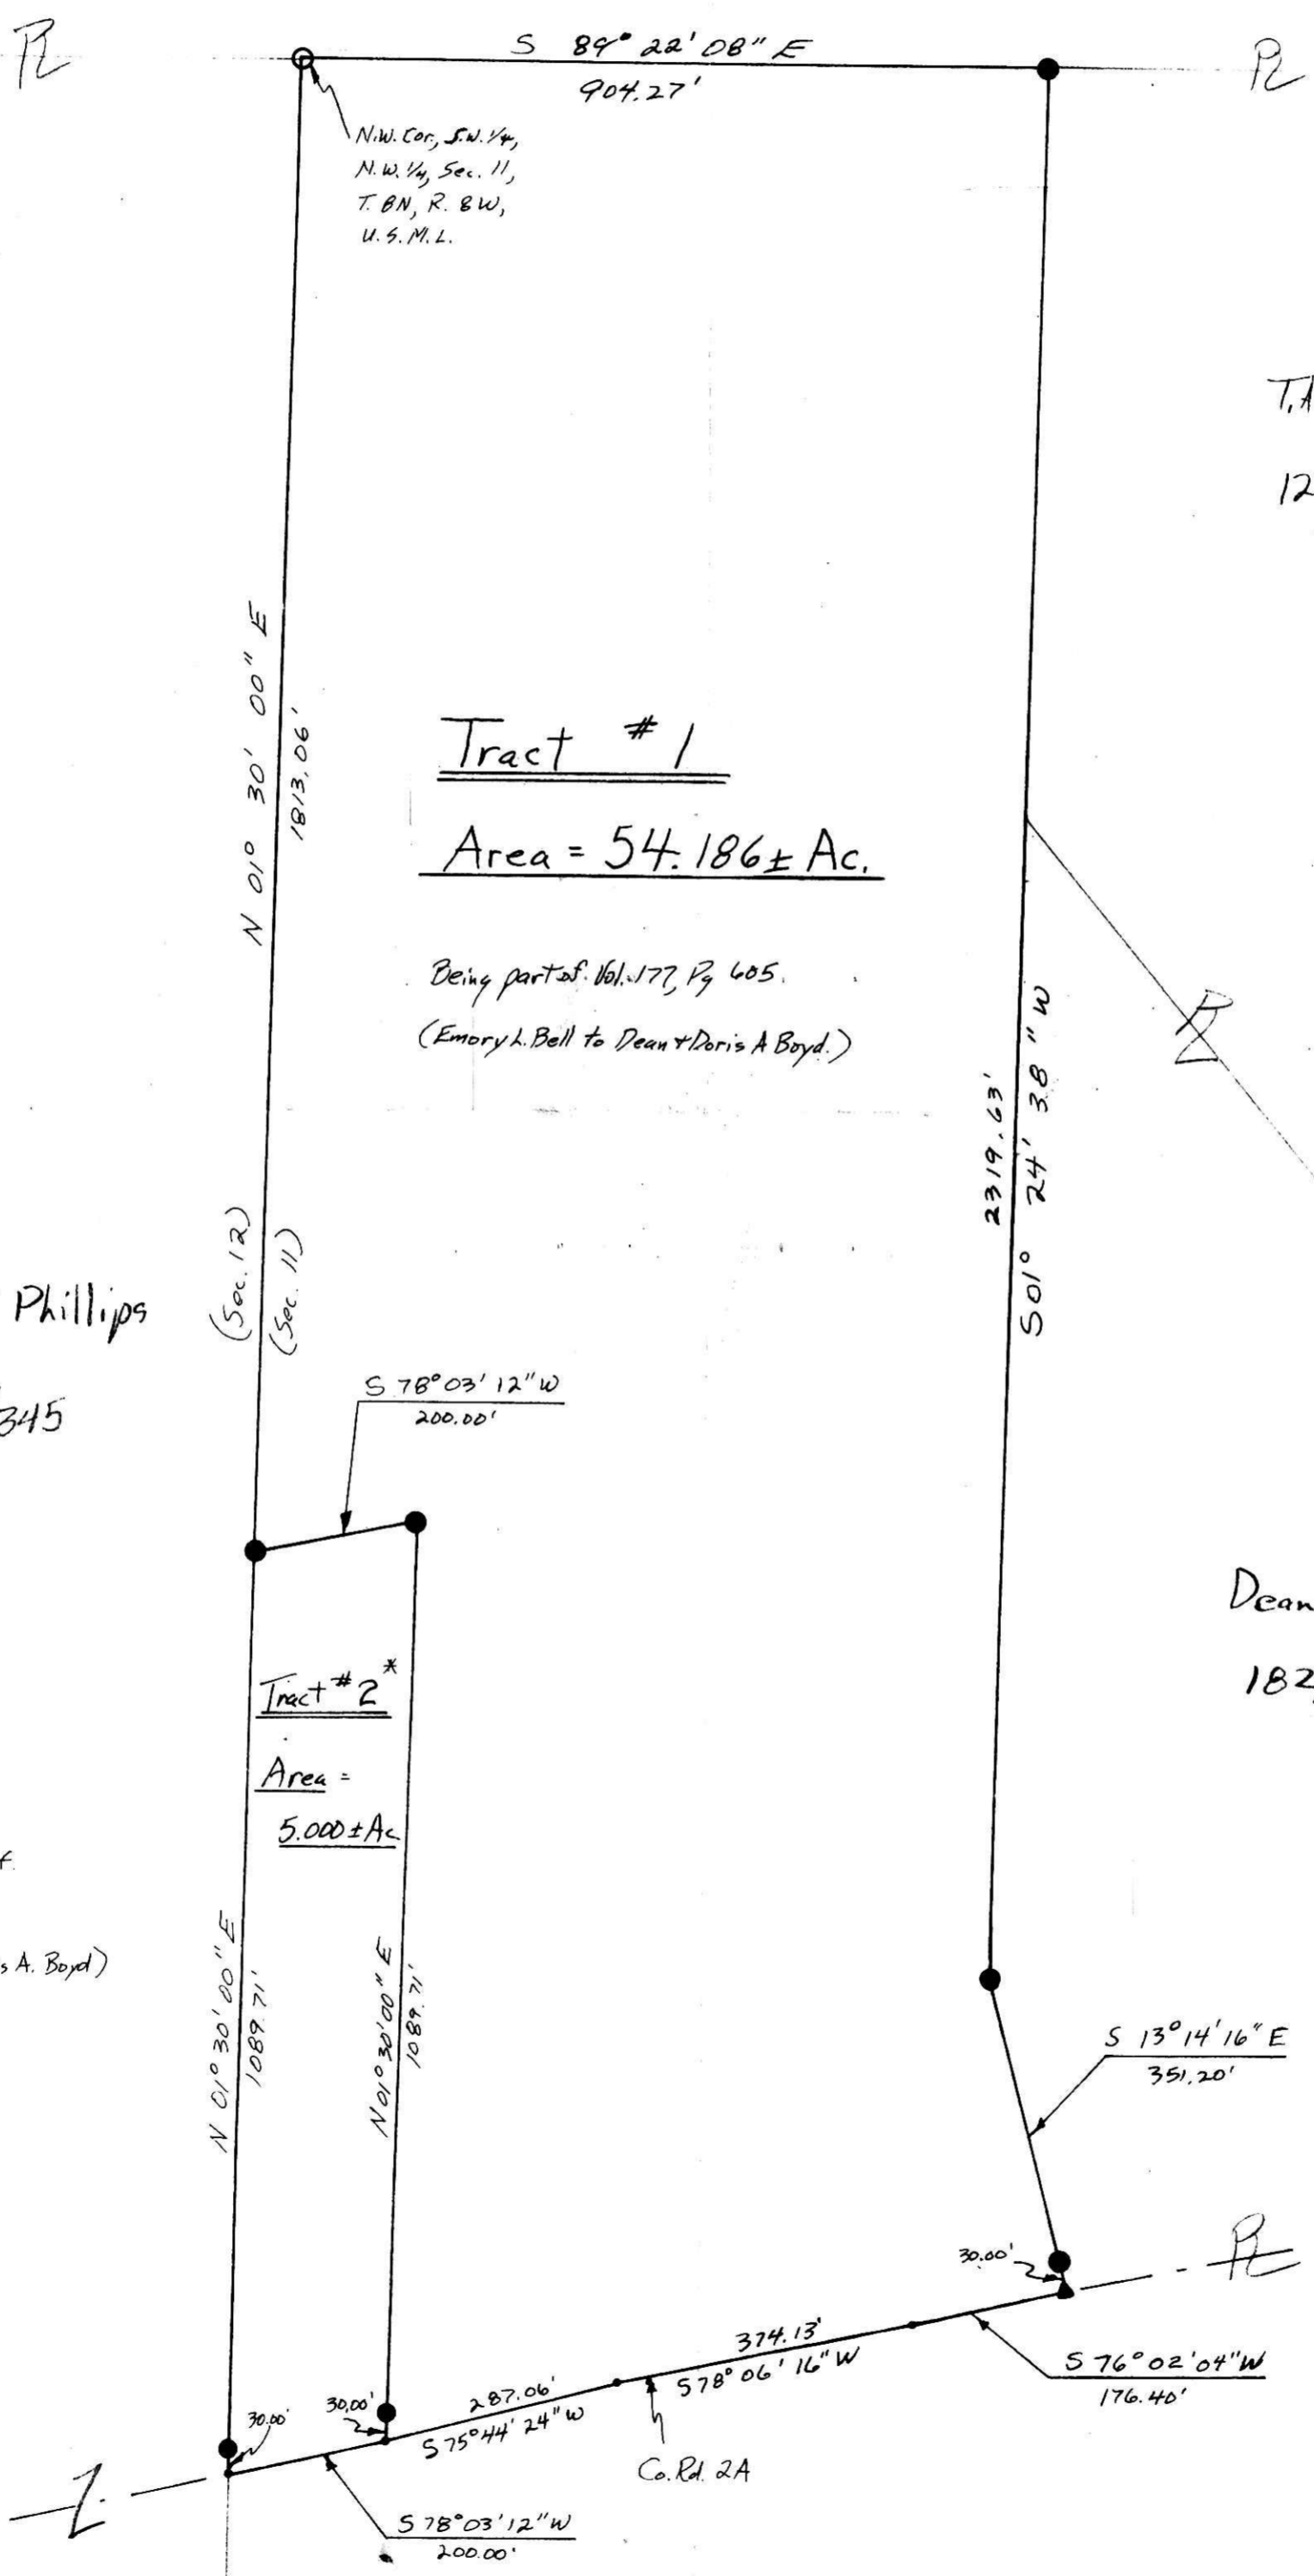

N.W. Cor, S.W. 1/4,
N.W. 1/4, Sec. 11,
T. 8N, R. 8W,
U.S.M.L.

T.H. Martin
127/289

Tract # 1
Area = 54.186 ± Ac.

Being part of Vol. 177, Pg. 605.
(Emory L. Bell to Dean & Doris A. Boyd.)

Harry F. Phillips
178/345

S 78° 03' 12" W
200.00'

Tract # 2
Area = 5.000 ± Ac.

Dean Boyd
182/863

S 13° 14' 16" E
351.20'

* Tract # 2 being part of
Vol. 177, Pg. 605
(Emory L. Bell to Dean & Doris A. Boyd)

N 01° 30' 00" E
1089.71'
N 01° 30' 00" E
1088.71'

S 76° 02' 04" W
176.40'

115913

30.00'
30.00'
287.06'
S 75° 44' 24" W
S 78° 03' 12" W
200.00'

D. Boyd
177/605

Co. Rd. 2A

RECD: October 24, 1978
AT 1:57 O'CLOCK P.M.
RECORDED: October 24, 1978
HOLMES COLLET VOL. 9, PG. 6
FEE: \$ 7.¹⁰
Richard H. ...
2 1/2 x 16 1/2 x 2

I hereby certify the above plat to be correct to the best of my knowledge and belief.



THE COSHOCTON LAND SURVEYING SERVICE
REGISTERED SURVEYOR 5935
REGISTERED ENGINEER