

BEING PART OF: LOT         
 SEC. 11 N.E. 1/4  
 QUAR.         
 T & N. R & W         
 TOWNSHIP RICHLAND  
 COUNTY HOLMES, OHIO, U.S.A.

THE COSHOCTON LAND SURVEYING SERVICE, INC.


233 S. FOURTH ST.

COSHOCTON, OHIO 43812

SURVEY FOR: LUTHER HOTHEM

DATE: 6/79

SCALE: 1" = 100'

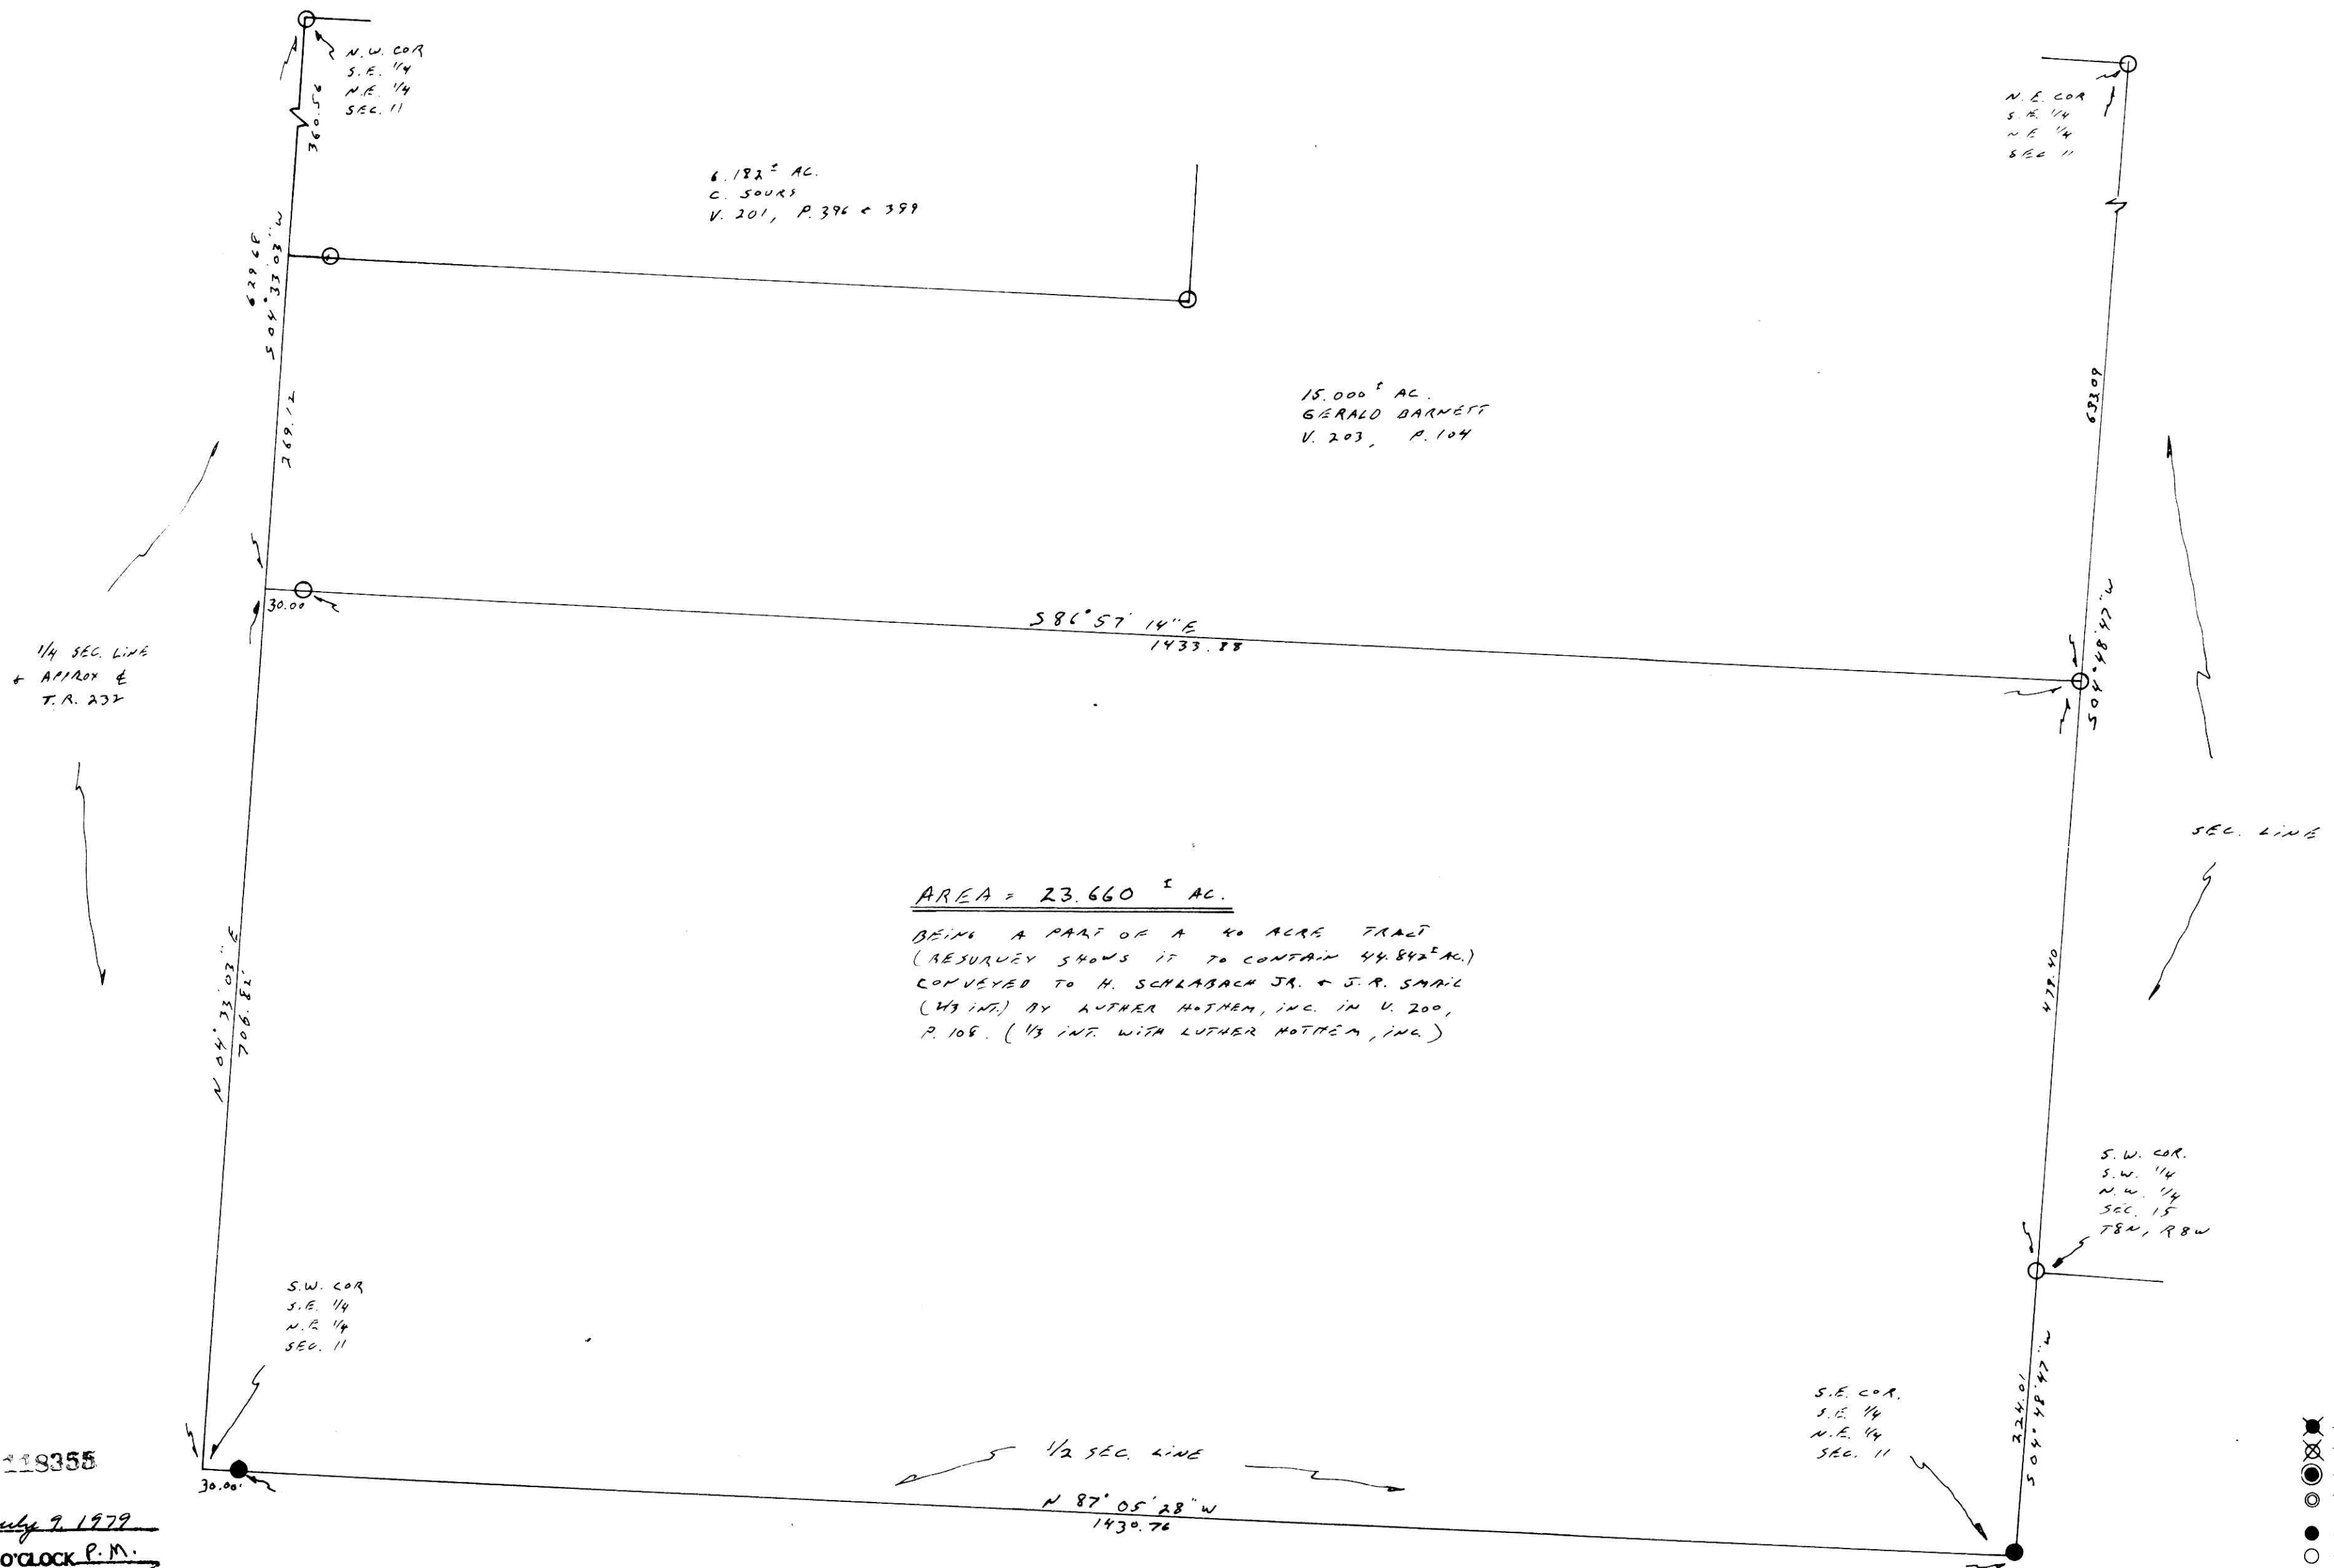

AREA = 23.660 ± AC.


BEING A PART OF A 40 ACRE TRACT  
 (RESURVEY SHOWS IT TO CONTAIN 44.842 AC.)  
 CONVEYED TO H. SCHLABACH JR. + J. R. SMITH  
 (W/INT) BY LUTHER HOTHEM, INC. IN V. 200,  
 P. 108. (1/3 INT. WITH LUTHER HOTHEM, INC.)


119355

REC'D: July 9, 1979  
 AT 3:35 O'CLOCK P.M.  
 RECORDED: July 10, 1979  
 HOLMES CO. Plat VOL. 9 PG. 44  
 FEE: \$7.01

Richard Brown RECORDER  
 16 1/4 x 21 1/2 x 2 443  
 Deed Vol. 206-Pg. 446

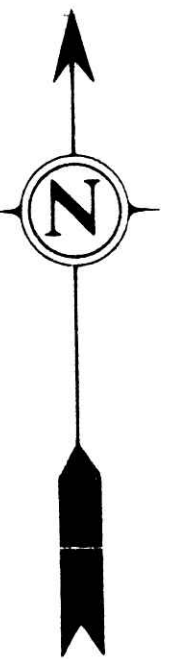

- ⊗ - SET RR SPIKE
- ⊙ - FND RR SPIKE
- ⊗ - SET CONC MON
- ⊙ - FND CONC MON
- - SET IRON PIN
- - FOUND IRON PIN
- - FOUND STONE
- ▲ - SET PK NAIL
- △ - FOUND PK NAIL
- - CORNER POST

I hereby certify the above plat to be correct to the best of my knowledge and belief.



THE COSHOCTON LAND SURVEYING SERVICE

James V. Gute  
 REGISTERED SURVEYOR 5335  
 REGISTERED ENGINEER 37405

Subject To All Easements  
 And Right-Of-Way's, Public  
 And Private, Of Record