



BEING PART OF: LOT 27
 SEC. 4
 QUAR. 424
 T 10 N. R 5 W PAINT
 TOWNSHIP PAINT
 COUNTY HOLMES, OHIO, U.S.M.C.

THE COSHOCTON LAND SURVEYING SERVICE, INC.
 233 S. FOURTH ST. COSHOCTON, OHIO 43812

SURVEY FOR: JR. A. SWARTZENTAUER
 DATE: 5/80
 SCALE: 1" = 50'

VOL 9 PAGE 64

TRACTS 1 & 2 BEING PART OF
 A 68 AC. TRACT CONVEYED TO
 JR. A. SWARTZENTAUER BY A.
 SCHLAGBACH, ET. AL. IN V. 175,
 P. 522

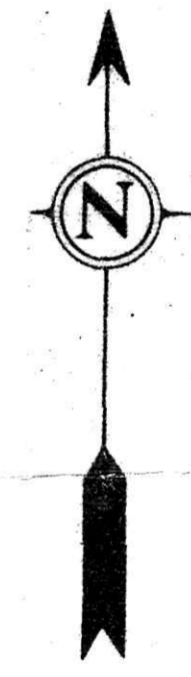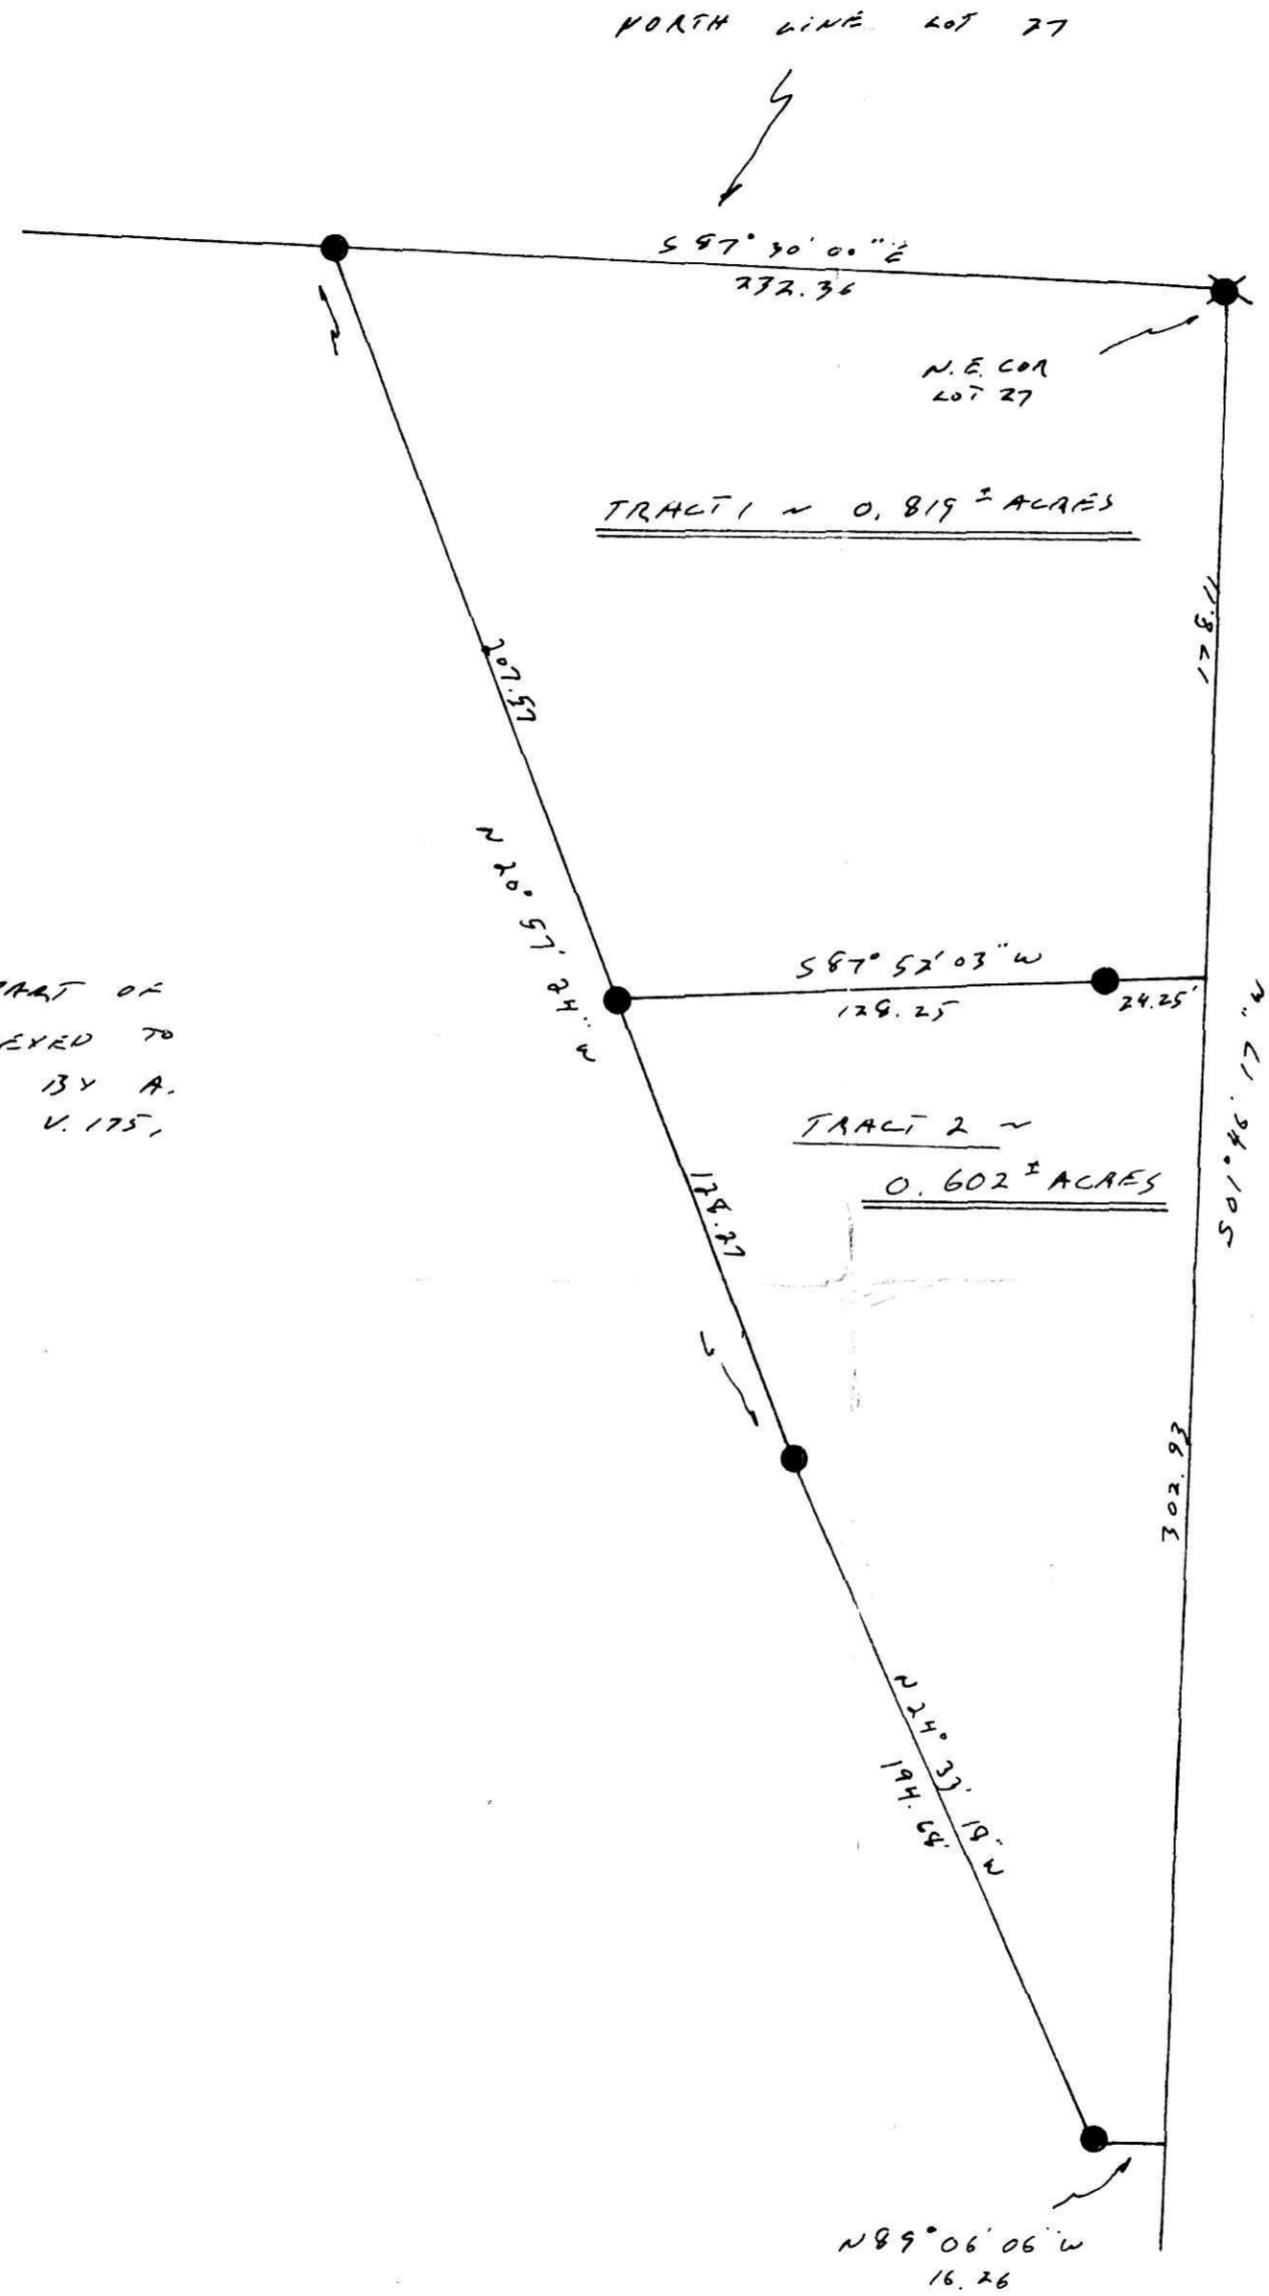

121382

RECD April 17, 1980
 AT 3:15 O'CLOCK P.M.
 RECORDED April 18, 1980
 HOLMES CO. PLAT VOL 9 PG. 64
 FEE: \$ 7.01
Richard C. G. G. G. RECORDER
 16 1/2 x 21 1/4 x 2
 Deed Vol. 209-Pg. 240

Subject To All Easements
 And Right-Of-Way's, Public
 And Private, Of Record



- ⊗ - SET RR SPIKE
- ⊗ - FND RR SPIKE
- ⊙ - SET CONC MON
- ⊙ - FND CONC MON
- - SET IRON PIN
- - FOUND IRON PIN
- - FOUND STONE
- ▲ - SET PK NAIL
- △ - FOUND PK NAIL
- - CORNER POST

I hereby certify the above plat to be correct to the best of my knowledge and belief.

THE COSHOCTON LAND SURVEYING SERVICE

James V. Gute
 REGISTERED SURVEYOR 5935
 REGISTERED ENGINEER 5740

C 56 P 27 16, 8, 78, P 35

BRUNING 40-21-38975