


Survey made for -
 TERRY SEARS
 792 OAK HILL Rd.
 WOOSTER, OHIO
 Ph. 264-3624

Survey of a 70.001 Ac. tract, a 40.007 Ac. tract
 & 3.500 Ac. tract
 LOT No. 8 FIRST QUARTER
 WALNUT CREEK TOWNSHIP
 T-9-N R-5-W
 HOLMES COUNTY, OHIO

Work Completed
 October, 1980

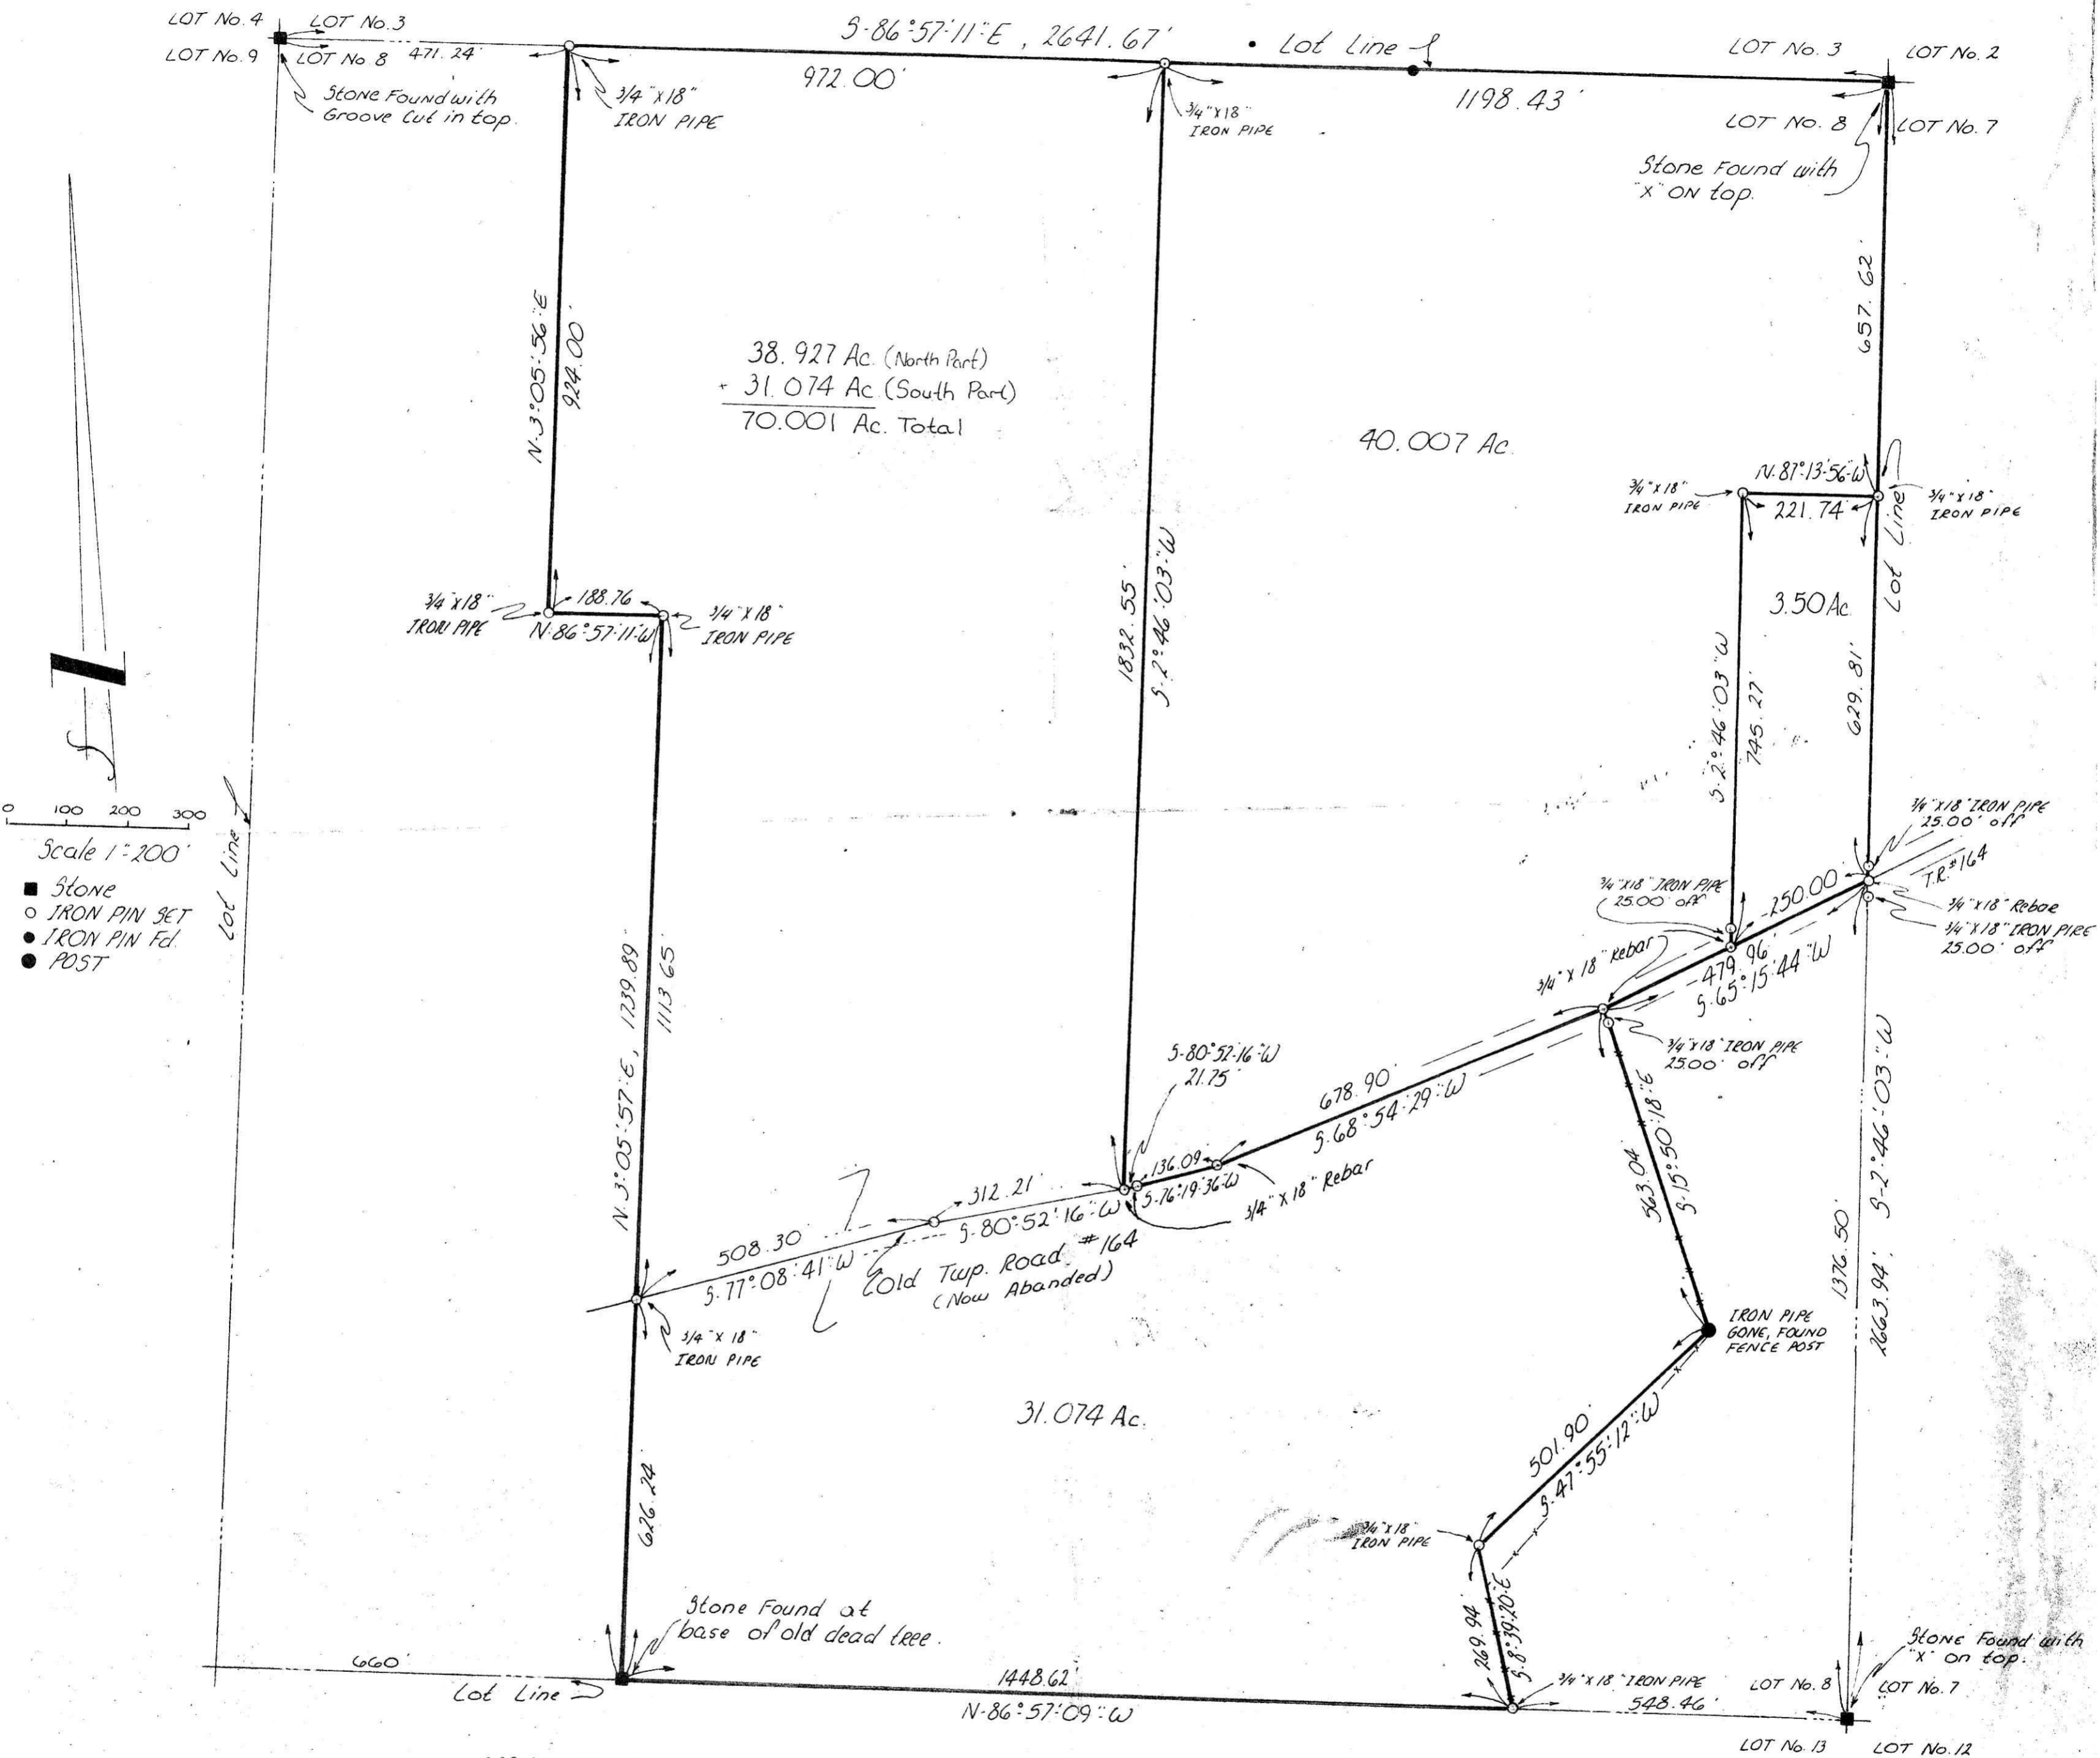

Scale 1"=200'
 ■ Stone
 ○ IRON PIN SET
 ● IRON PIN Fd.
 ● POST

BASIS OF BEARING:
 LOT LINE BETWEEN LOT No. 8 &
 LOT No. 3 FROM ROBERT L. KASNAR
 SURVEY (No Date)

DETERMINATION:
 1. DEED RECORDS
 2. MONUMENT RECORDS
 3. MAP OF SURVEY BY ROBERT L. KASNAR (No Date)
 4. MAP OF SURVEY BY RONALD G. RUDOLPH (11-4-78)

I CERTIFY THIS SURVEY TO BE CORRECT TO THE BEST
 OF MY KNOWLEDGE

Clyde Purdy
 PURDY, FRIEDL & HARRIS, INC.
 ENGINEERS - SURVEYORS
 CLEVELAND, OHIO 44115

R.S. #4900

123902

REC'D. November 4, 1980
 AT 2:42 O'CLOCK P.M.
 RECORDED November 5, 1980
 Plat VOL 9 PG. 84
 Holmes Co. Ohio Fee: \$7.02
 Richard Strauss Recorder
 22 x 18 x 2
 Deed Vol. 211-Pg. 335
 211-Pg. 338
 211-Pg. 340