


PAINT TOWNSHIP
HOLMES COUNTY, OHIO
LOT 13, 3RD QTR. T-10, R-4

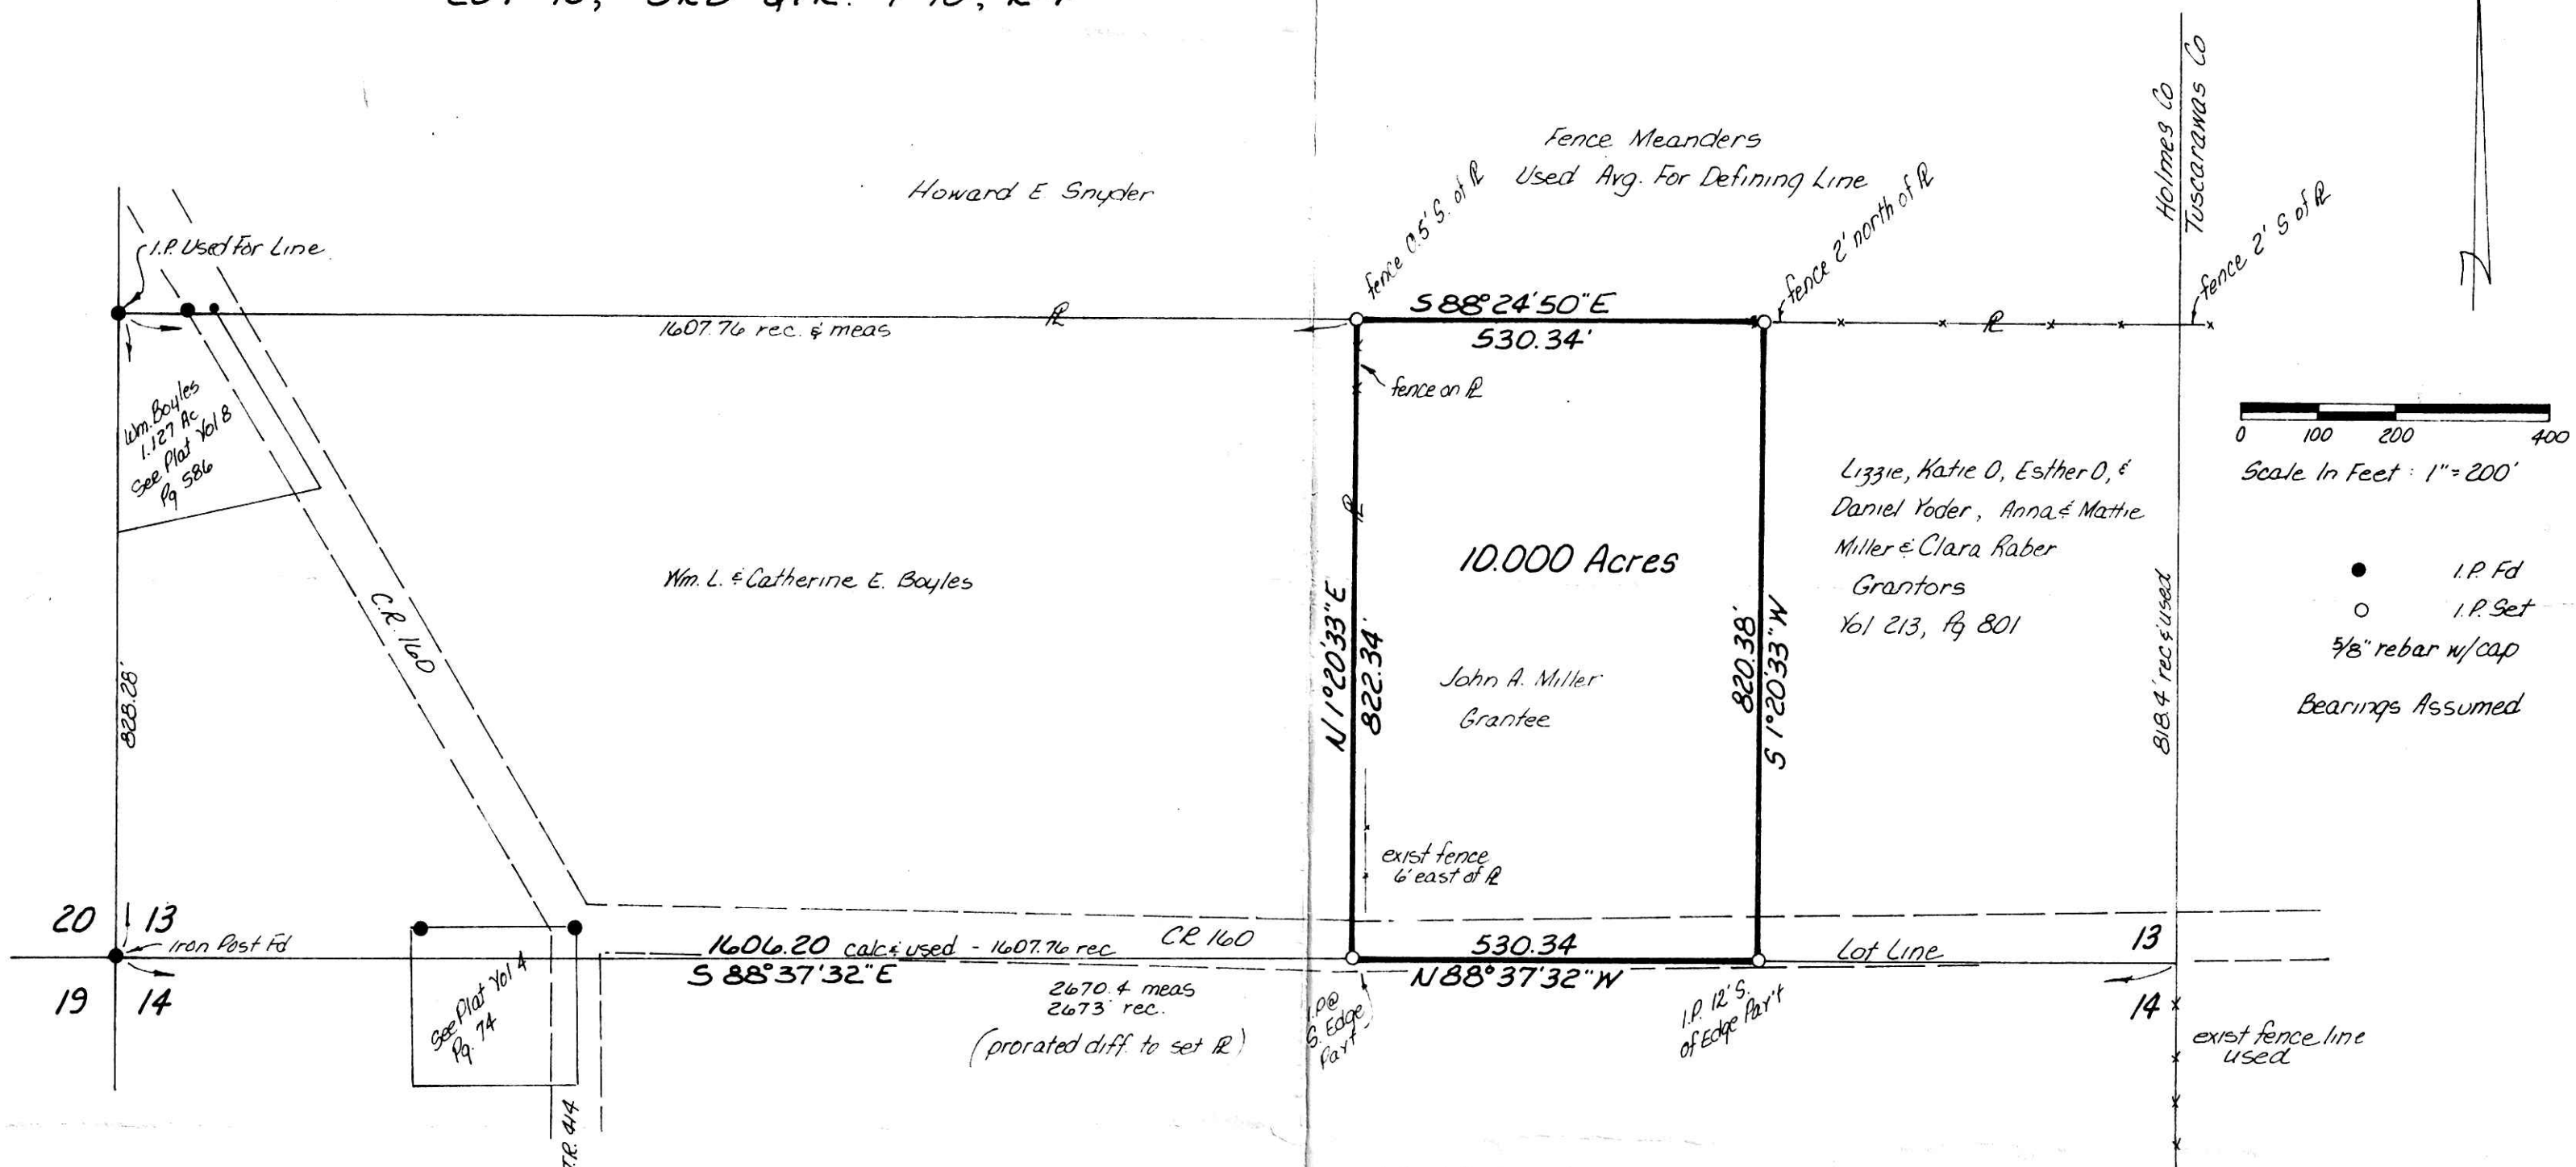

I Certify This Survey To Be Correct To The Best
Of My Knowledge

William H. Long Jan 24, 1983

William H. Long R.S. 6505
R.D. 1 Box 69A
Big Prairie, Ohio 44611

135925

Rec'd. Feb 22, 1983 AT 10:50 O'CLOCK AM
Recorded Feb 22, 1983 Holmes Co. Ohio Fee: 4.32
Plat Vol. 9 Pg. 166 Recorder Richard Shaven
18X12

Deed Vol. 219; Pg. 584.