



137031

RIPLEY TOWNSHIP
HOLMES COUNTY, OHIO
N.W. Qtr., Sec. 7, T-17, R-14

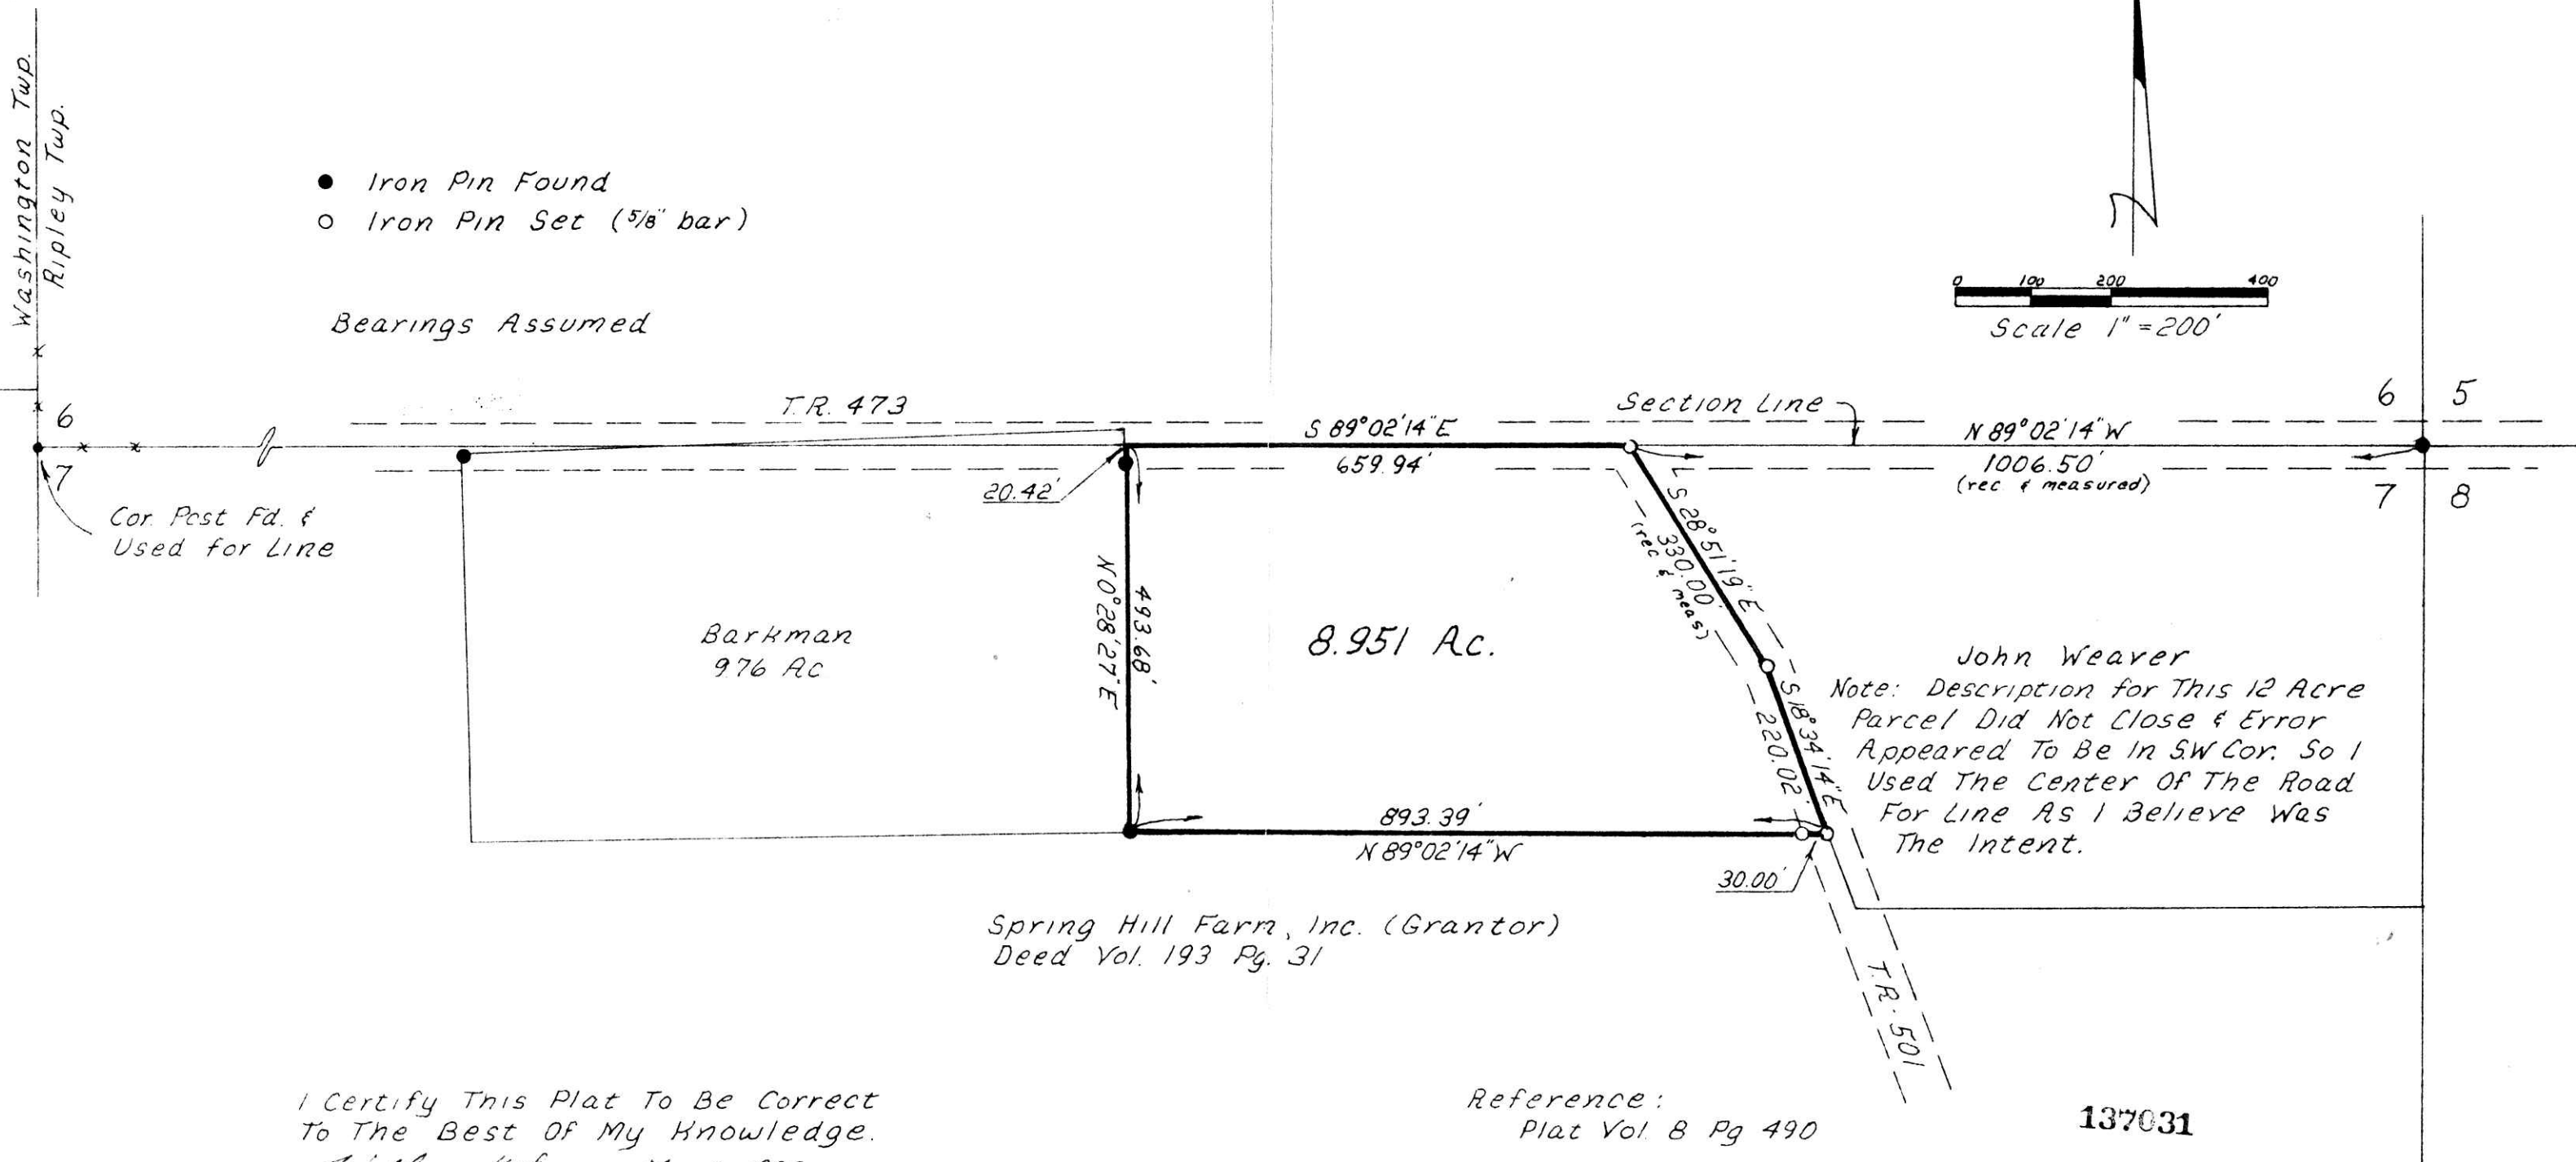

- Iron Pin Found
- Iron Pin Set (5/8" bar)

Bearings Assumed

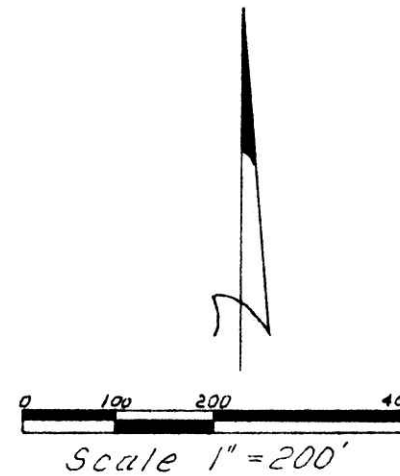

John Weaver
 Note: Description for This 12 Acre Parcel Did Not Close & Error Appeared To Be In SW Cor. So I Used The Center Of The Road For Line As I Believe Was The Intent.

Spring Hill Farm, Inc. (Grantor)
 Deed Vol. 193 Pg. 31

I Certify This Plat To Be Correct
 To The Best Of My Knowledge.

William H Long May 2, 1983
 William H Long R.S. 6505
 RD#1 Box 69A
 Big Prairie, Ohio, 44611

Reference:
 Plat Vol. 8 Pg 490

137031

MAP OFFICE COPY

rec'd. May 13, 1983 AT 3:55 O'CLOCK P.M.
 Recorded May 16, 1983 Holmes Co. Ohio Fee: 9.90
 Plat Vol. 9 Pg. 177 Recorder Richard Thaven
 11 X 18 Deed Vol. 220; Pg. 365.