


136642



WM. TERRY BURKEY SURVEYING

MILLER TO MILLER SURVEY
S. E. QTR. SECTION 35
TOWNSHIP 15 RANGE 12
SALT CREEK TOWNSHIP
HOLMES COUNTY, OHIO
COMPLETED DEC. 18, 1982

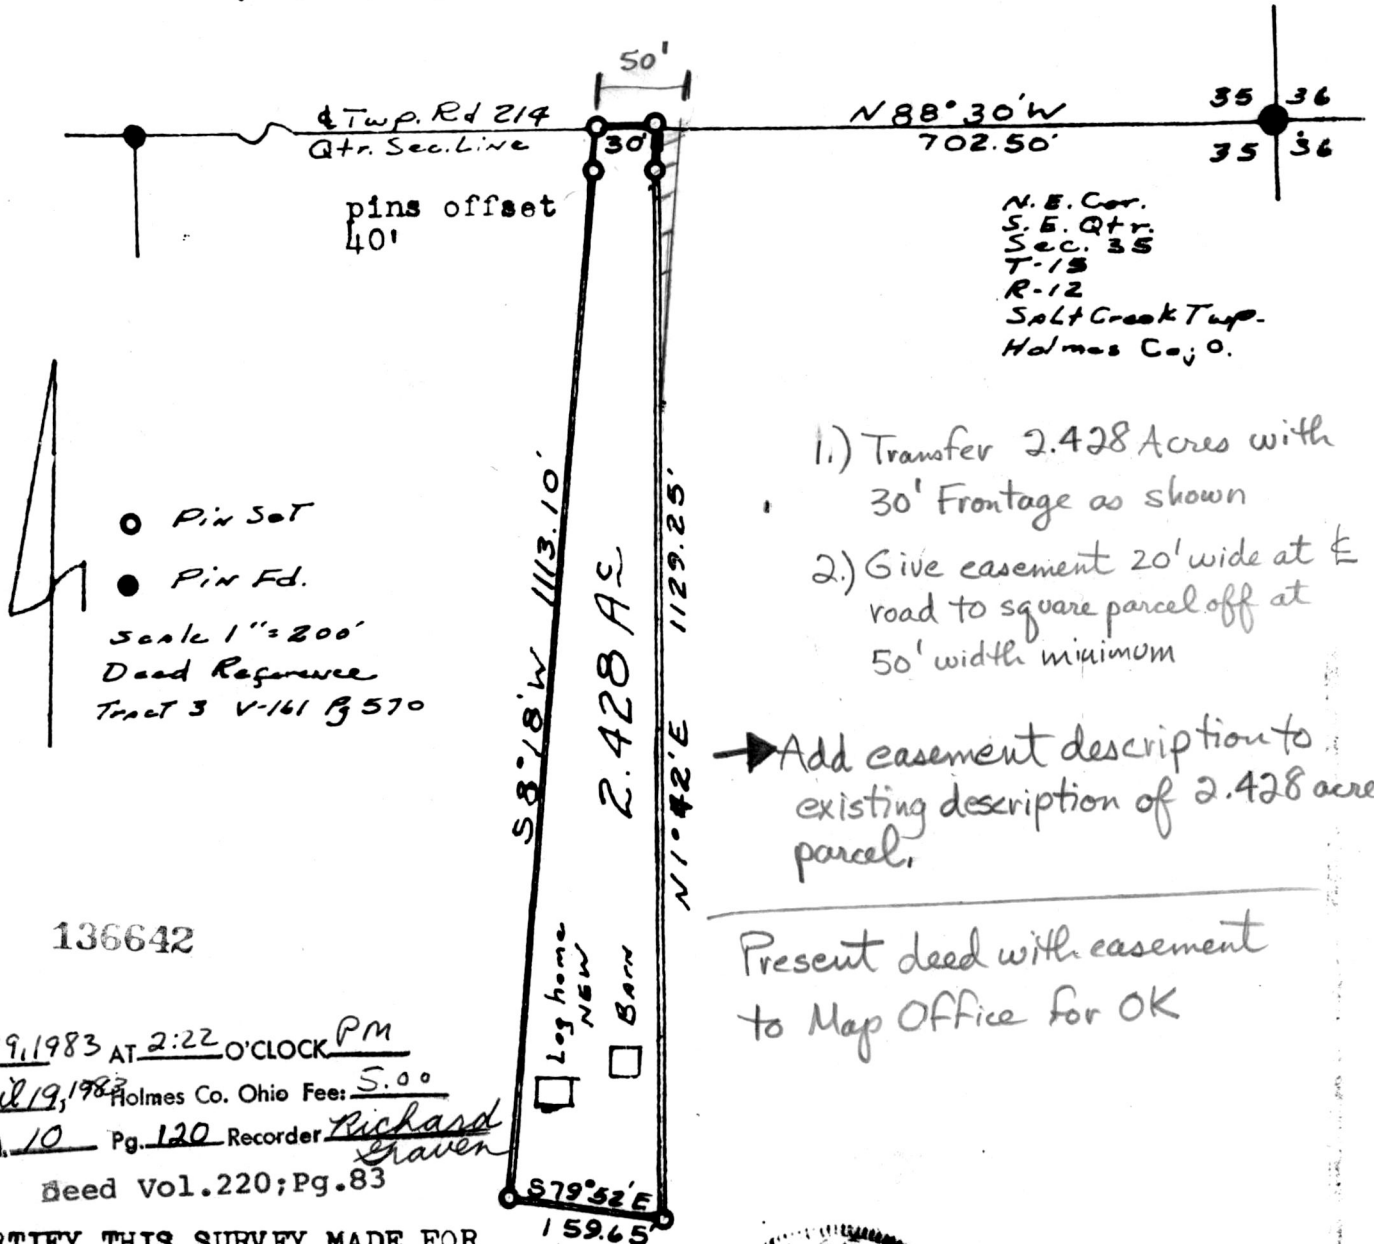

136642

Rec'd. April 19, 1983 AT 2:22 O'CLOCK PM
Recorded April 19, 1983 Holmes Co. Ohio Fee: 5.00
Plat Vol. 10 Pg. 120 Recorder Richard Craven
Deed Vol. 220; Pg. 83

I CERTIFY THIS SURVEY MADE FOR
DAVID AND DAN MILLER TO BE
CORRECT TO THE BEST OF MY
KNOWLEDGE AND BELIEF.

SIGNED

William T. Burkey

WILLIAM T. BURKEY
REGISTERED SURVEYOR #5107
STATE OF OHIO

MAP OFFICE COPY