
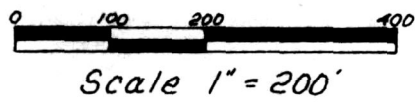


140915

Knox Township
Holmes County, Ohio
N.W. Qtr., Sec. 19, T-17, R-14

Survey For Dennis W. & Mary K. Harris
Deed Vol. 134 Page 516

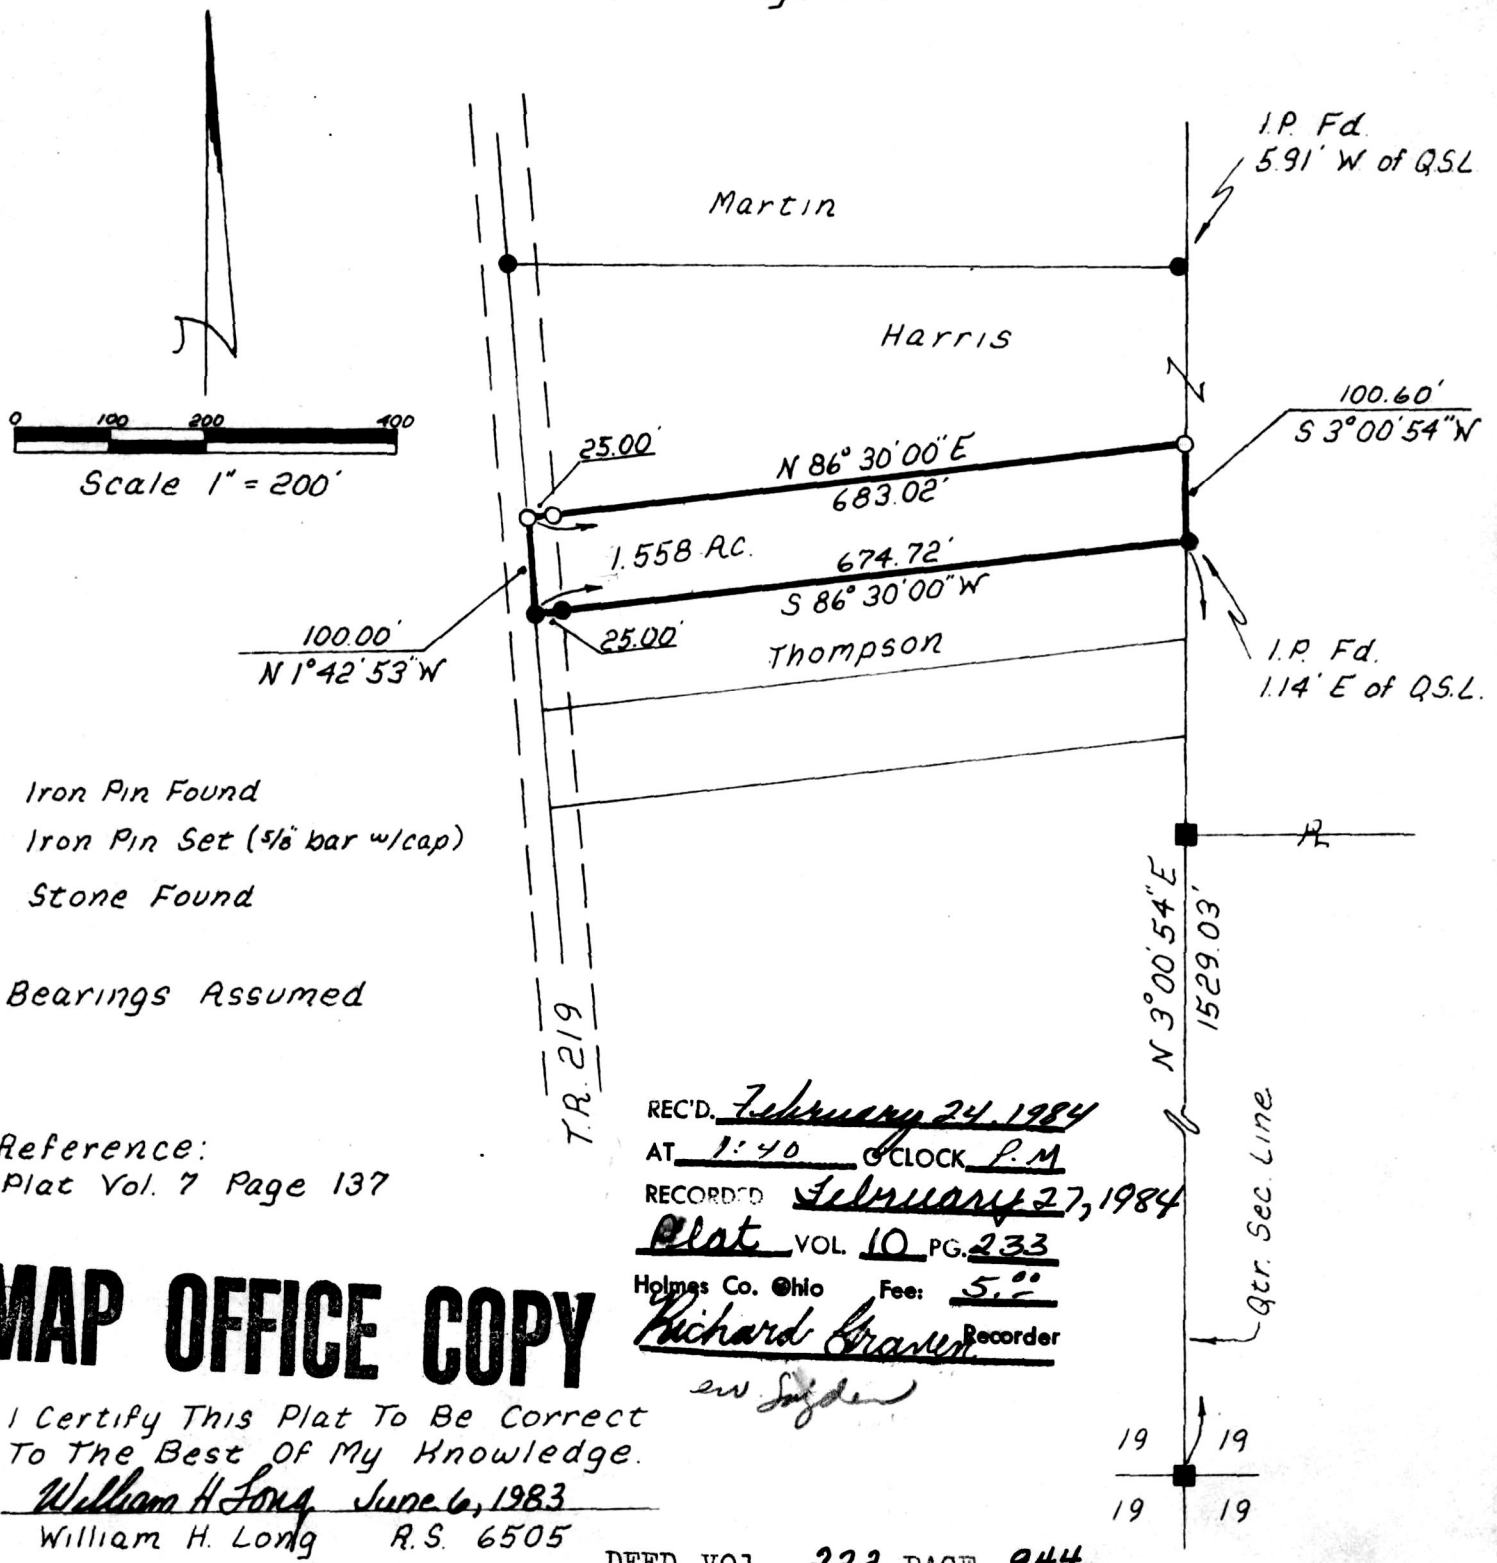

- Iron Pin Found
- Iron Pin Set (5/8 bar w/cap)
- Stone Found

Bearings Assumed

Reference:
Plat Vol. 7 Page 137

MAP OFFICE COPY

I Certify This Plat To Be Correct
To The Best Of My Knowledge.
William H. Long June 6, 1983
William H. Long R.S. 6505

REC'D. February 24, 1984
 AT 1:40 O'CLOCK P.M.
 RECORDED February 27, 1984
Plat VOL. 10 PG. 233
 Holmes Co. Ohio Fee: 5.00
Richard Craner Recorder
sw Jones

DEED VOL. 222 PAGE 944