
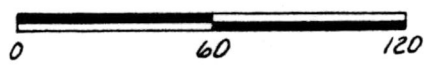


VILLAGE OF KILLBUCK  
HOLMES COUNTY, OHIO  
NW Qtr. Sec. 15, T-8N, R-7W

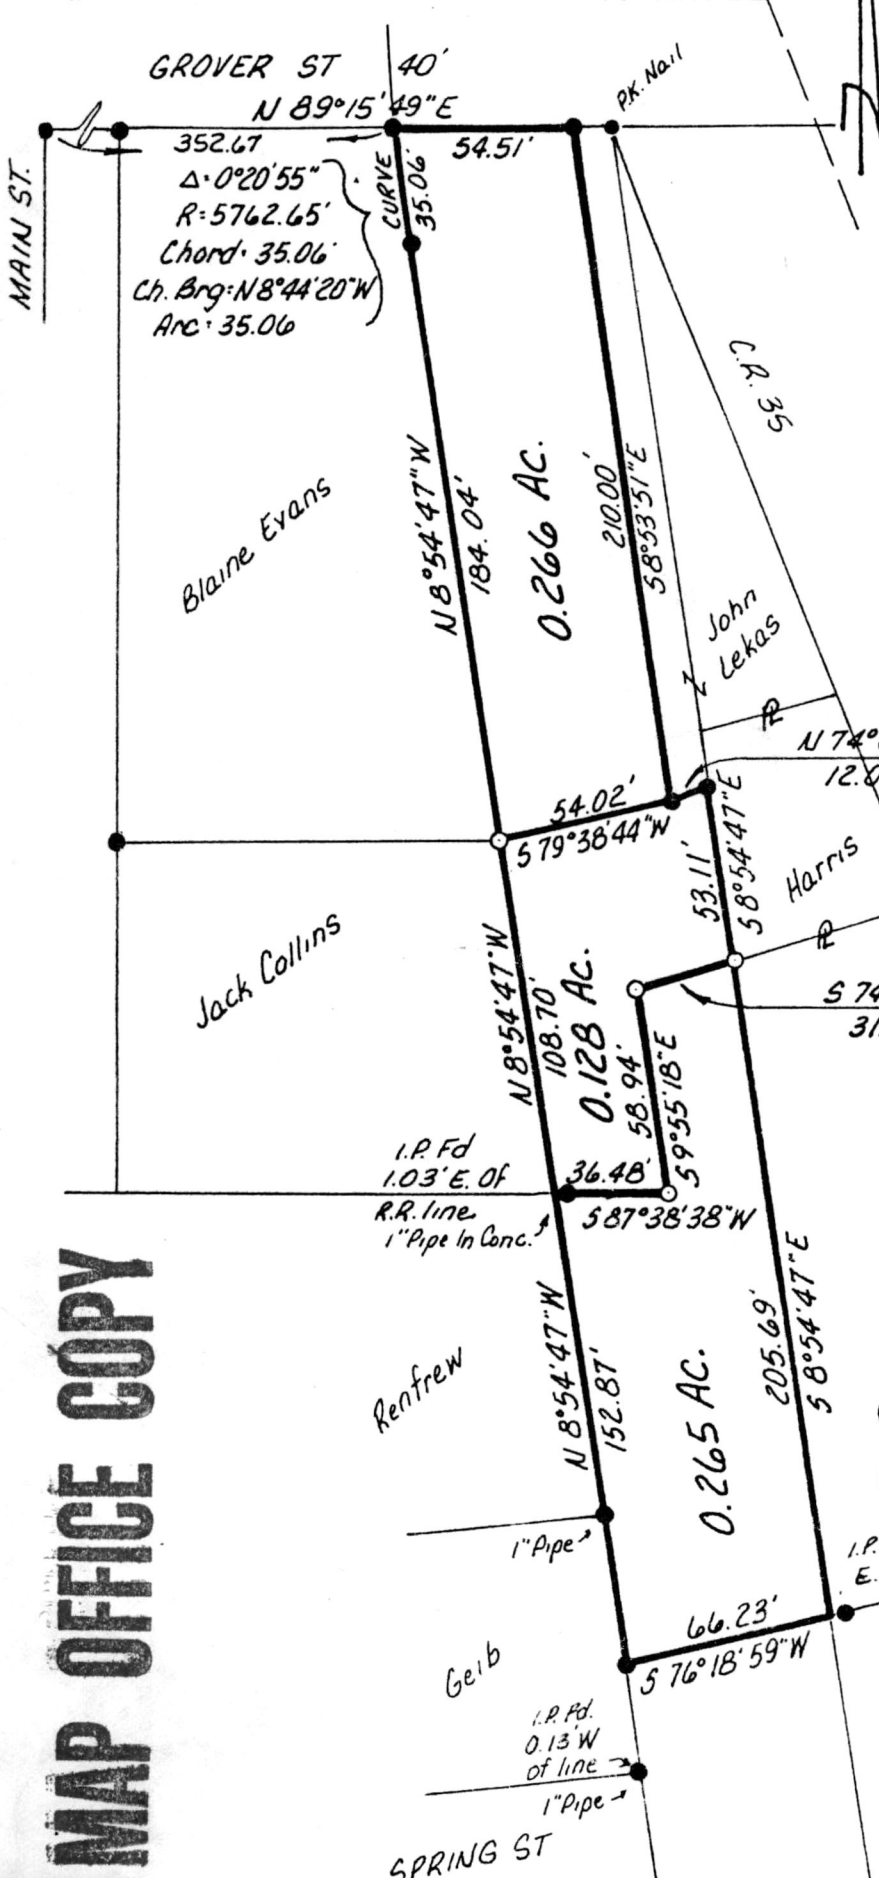

Scale In Feet 1"=60'

- Iron Pin Found
- Iron Pin Set - 5/8" Bar With Yellow Cap Marked "LONG-6505"

Bearings From Plat Vol 10, Pg 314  
References: Plat Vol 10, Pg 314  
Plat Vol 9, Pg 36  
Plat Vol 8, Pg 668  
Plat Vol 7, Pg 197  
Deed Vol 187, Pg 359  
Deed Vol. 187, Pg 29

Surveyed for Wm. Hill, Grantor  
Deed Vol. 224, Pg 985

0.266 Ac. To Evans  
0.128 Ac. To Collins  
0.265 Ac. To Gamertsfelder

145198

REC'D. NOV 30 1984  
AT 10:55 O'CLOCK AM  
RECORDED November 30, 1984  
Plat VOL 10 PG. 338  
Holmes Co. Ohio Fee: 5.00  
Recorder  
Richard [Signature]  
Deed Vol. 225-pg. 601

MAP OFFICE COPY

I Certify This Survey To Be Correct To  
The Best Of My Knowledge  
William H. Long Oct 8, 1984  
William H Long R.S. 6505  
13301 T.R. 503  
Big Prairie, Ohio 44611