


145387

Stone Mon. fd.

N

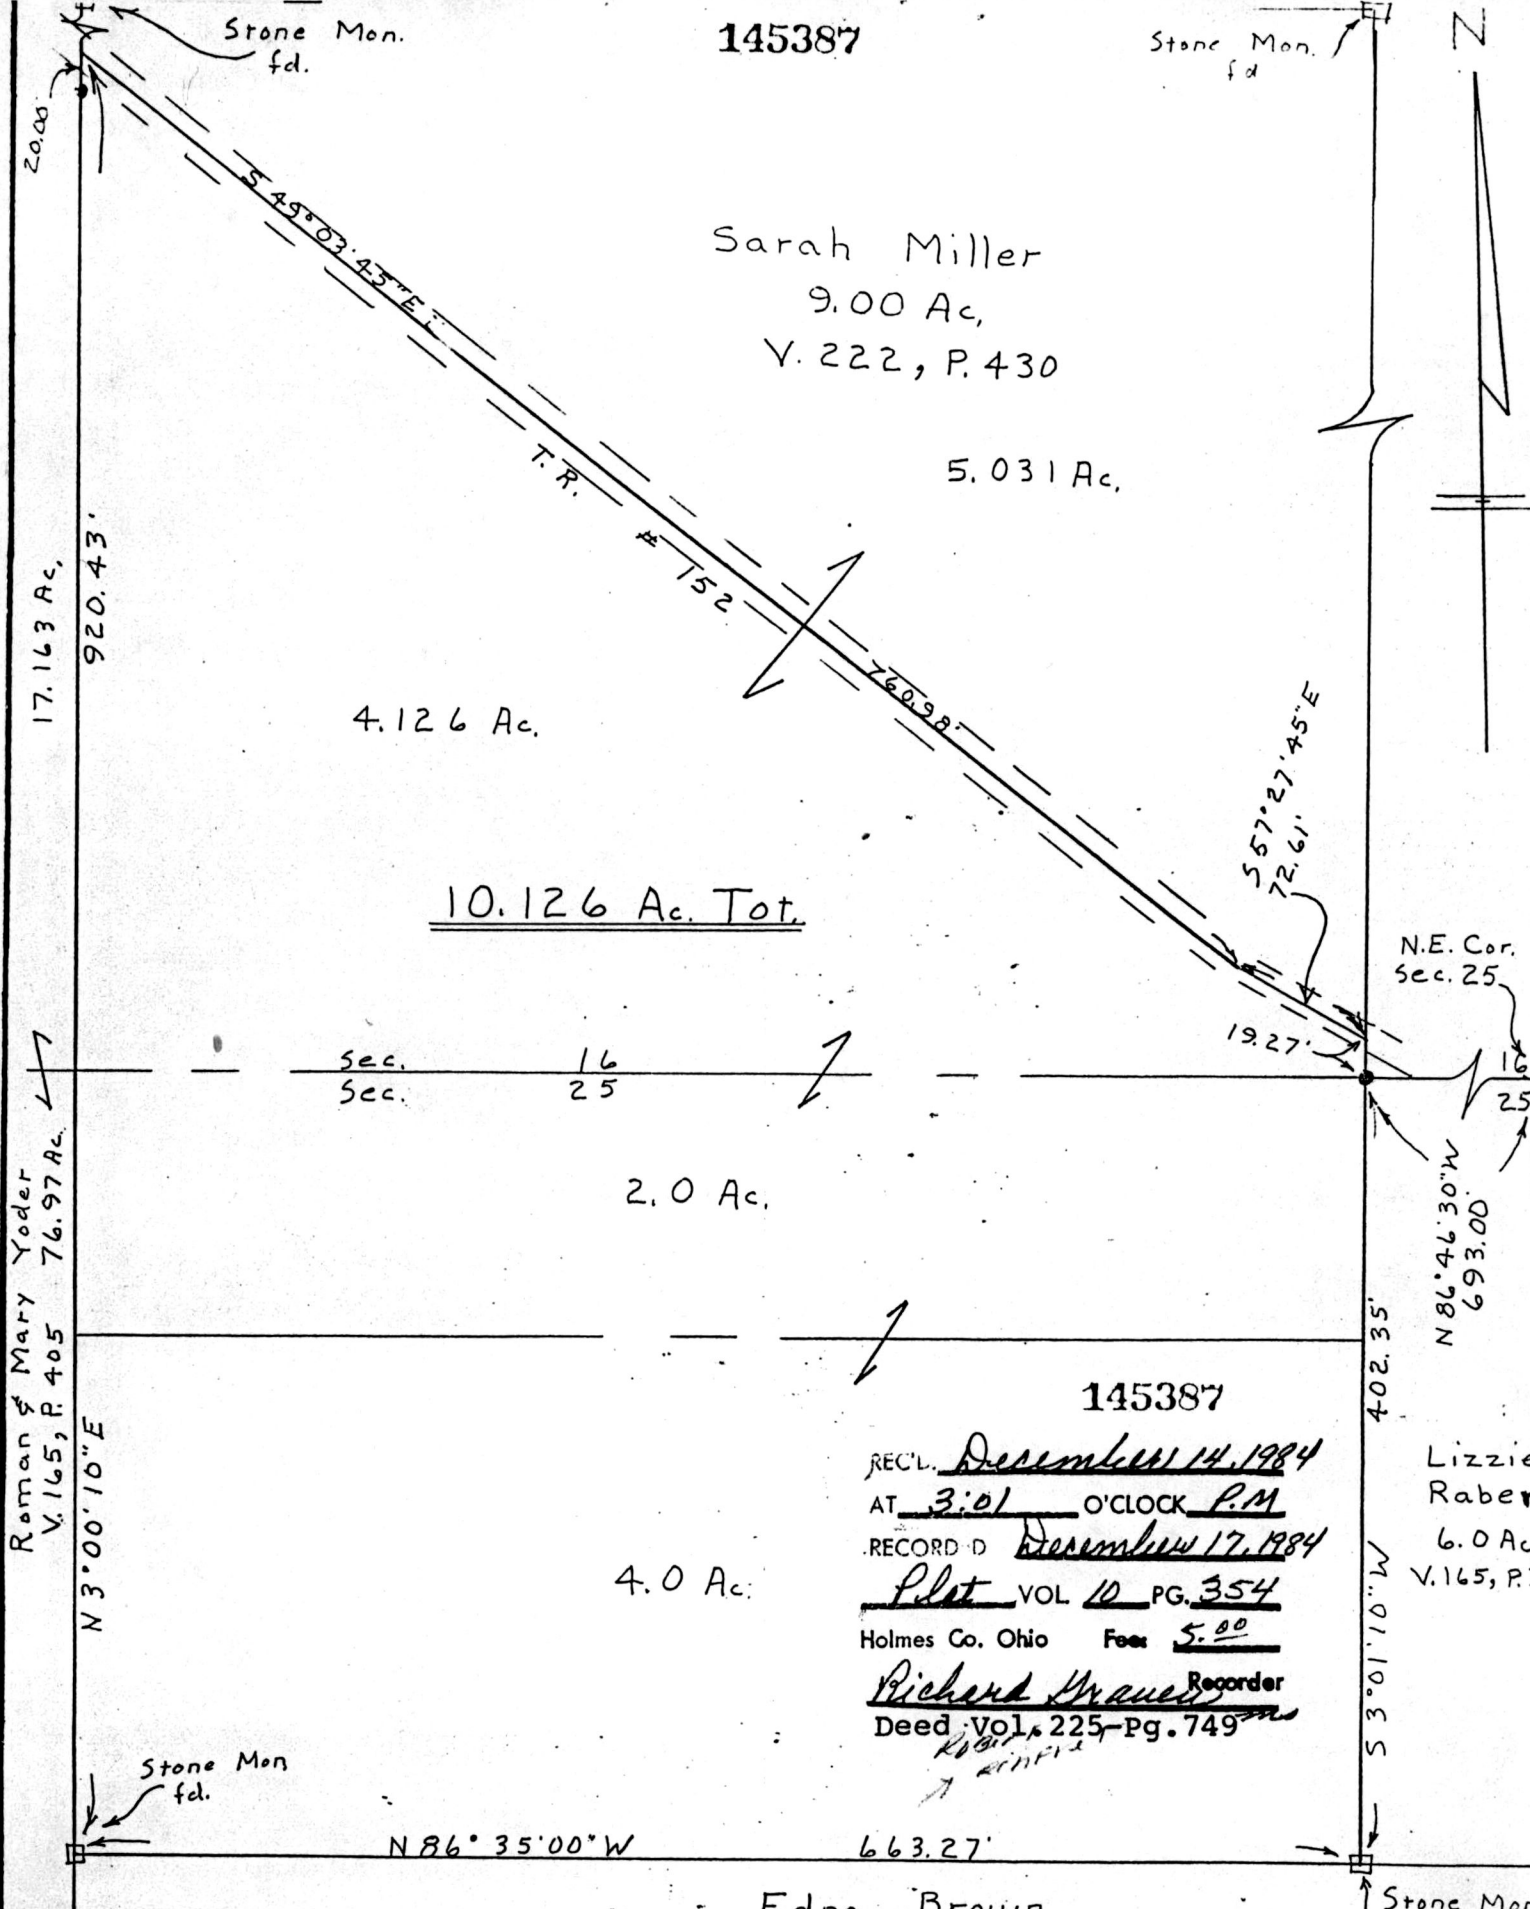

Denotes 5/8" Iron Pin Set • w. Cap.
 Denotes Iron Pin Fund ○
 Bearings are Oriented To W. Line 9.00 Ac Tract
 Documents used were deeds, Vol. & Pgs. as shown

MAP OFFICE COPY

PYLE SURVEYING
 PROFESSIONAL LAND SURVEYORS OF OHIO

116 S. Broadway
 P.O. Box 149
 NEW PHILADELPHIA, OHIO 44663
 Phone: 216/364-2277

Plat of Survey for

Sarah Miller

Located in N.E. 1/4 Sec. 25 T-8, R-5
 Clark Twp. Holmes Co. Ohio

Scale 1" = 100' Date Nov. 1984

CERTIFICATE OF SURVEYOR

I, the undersigned, hereby certify that this map is true and correct to the best of my knowledge and belief.

John P. Pyle

Registered Surveyor No. 6533