

R.W.G.



WALNUT CREEK TOWNSHIP
NW QTR. SECTION 22
T-9N R-5W
HOLMES COUNTY, OHIO

S-34-85

N



- - IRON CORN FD
- - 5/8" X 30" CAPPED REBARS SET
- ⚡ - RR SPIKE SET
- △ ANGLE POINT - REF: VOL. 6 PG. 32 RECORDERS OFFICE
- PRIOR SUR. REF: VOL. 8 PG. 516 " "

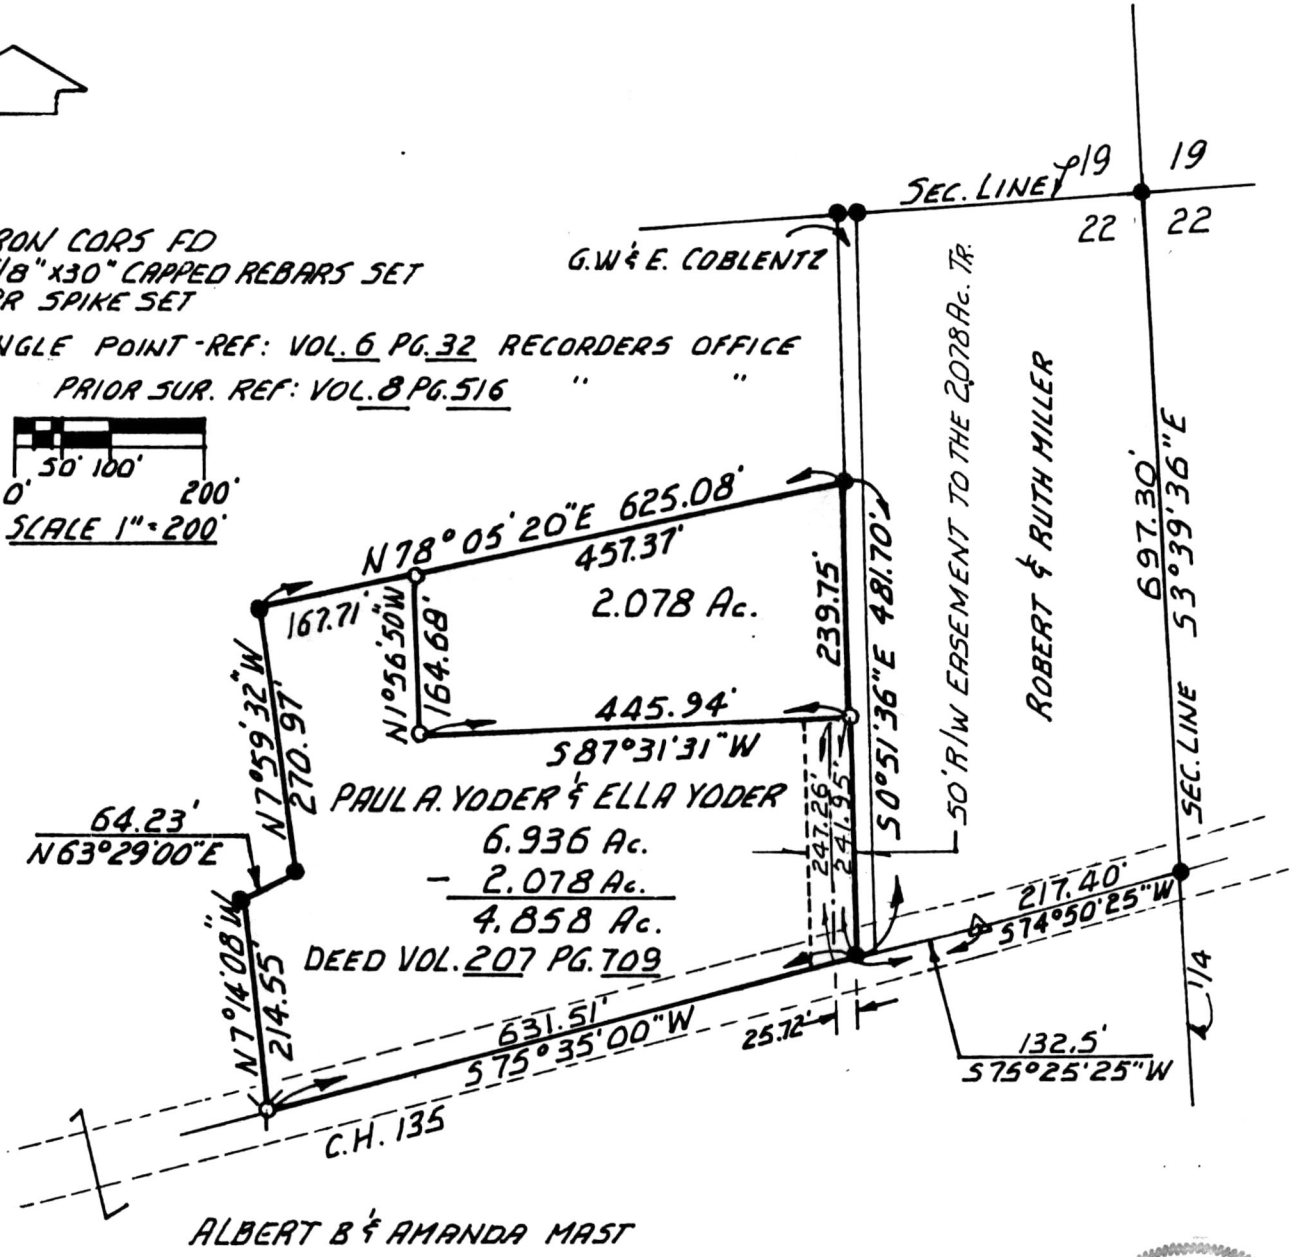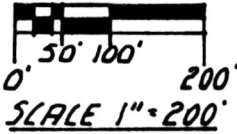

MAP OFFICE COPY

146889

I CERTIFY THIS SURVEY TO BE CORRECT TO THE BEST OF MY KNOWLEDGE.

COMPLETED 4-22-85

Ray W. Gasbarre
 RAY W. GASBARRE P.S. 4153
 R.W. GASBARRE & ASSOC. INC.
 401 S. MARKET ST P.O. BX. 44
 WOOSTER, OHIO 44691



rec'd. MAY 6 1985 AT 3:33 O'CLOCK P.M.
 recorded May 7, 1985 Holmes Co. Ohio Fee: 5.00
 Plat Vol. 10 Pg. 402 Recorder Richard Drannen
 Deed Vol. 227-Pg. 90