

147208

N.E. Cor. Lot 4
Corner Post
with Fences

KNOX
TWP.
MONROE
TWP.

Scale 1"=100'

- Iron Pin Found
- Iron Pin Set

KNOX Township
Fourth Quarter Township
Pt. Lot N^o 4
T-9N, R-9W
Holmes County, Ohio


made for: Jimmy A. Dixon Jr.

I hereby certify this survey
and plat to be correct to the
best of my knowledge

BY: Virgil D. Landis 5-16-85
VIRGIL D. LANDIS, P.S. #6551

SHAFER, JOHNSTON, LICHTENWALTER
& ASSOCIATES, INC.
CONSULTING ENGINEERS - SURVEYORS
MANSFIELD OHIO

VIRGIL D. LANDIS
#6551
SURVEYOR

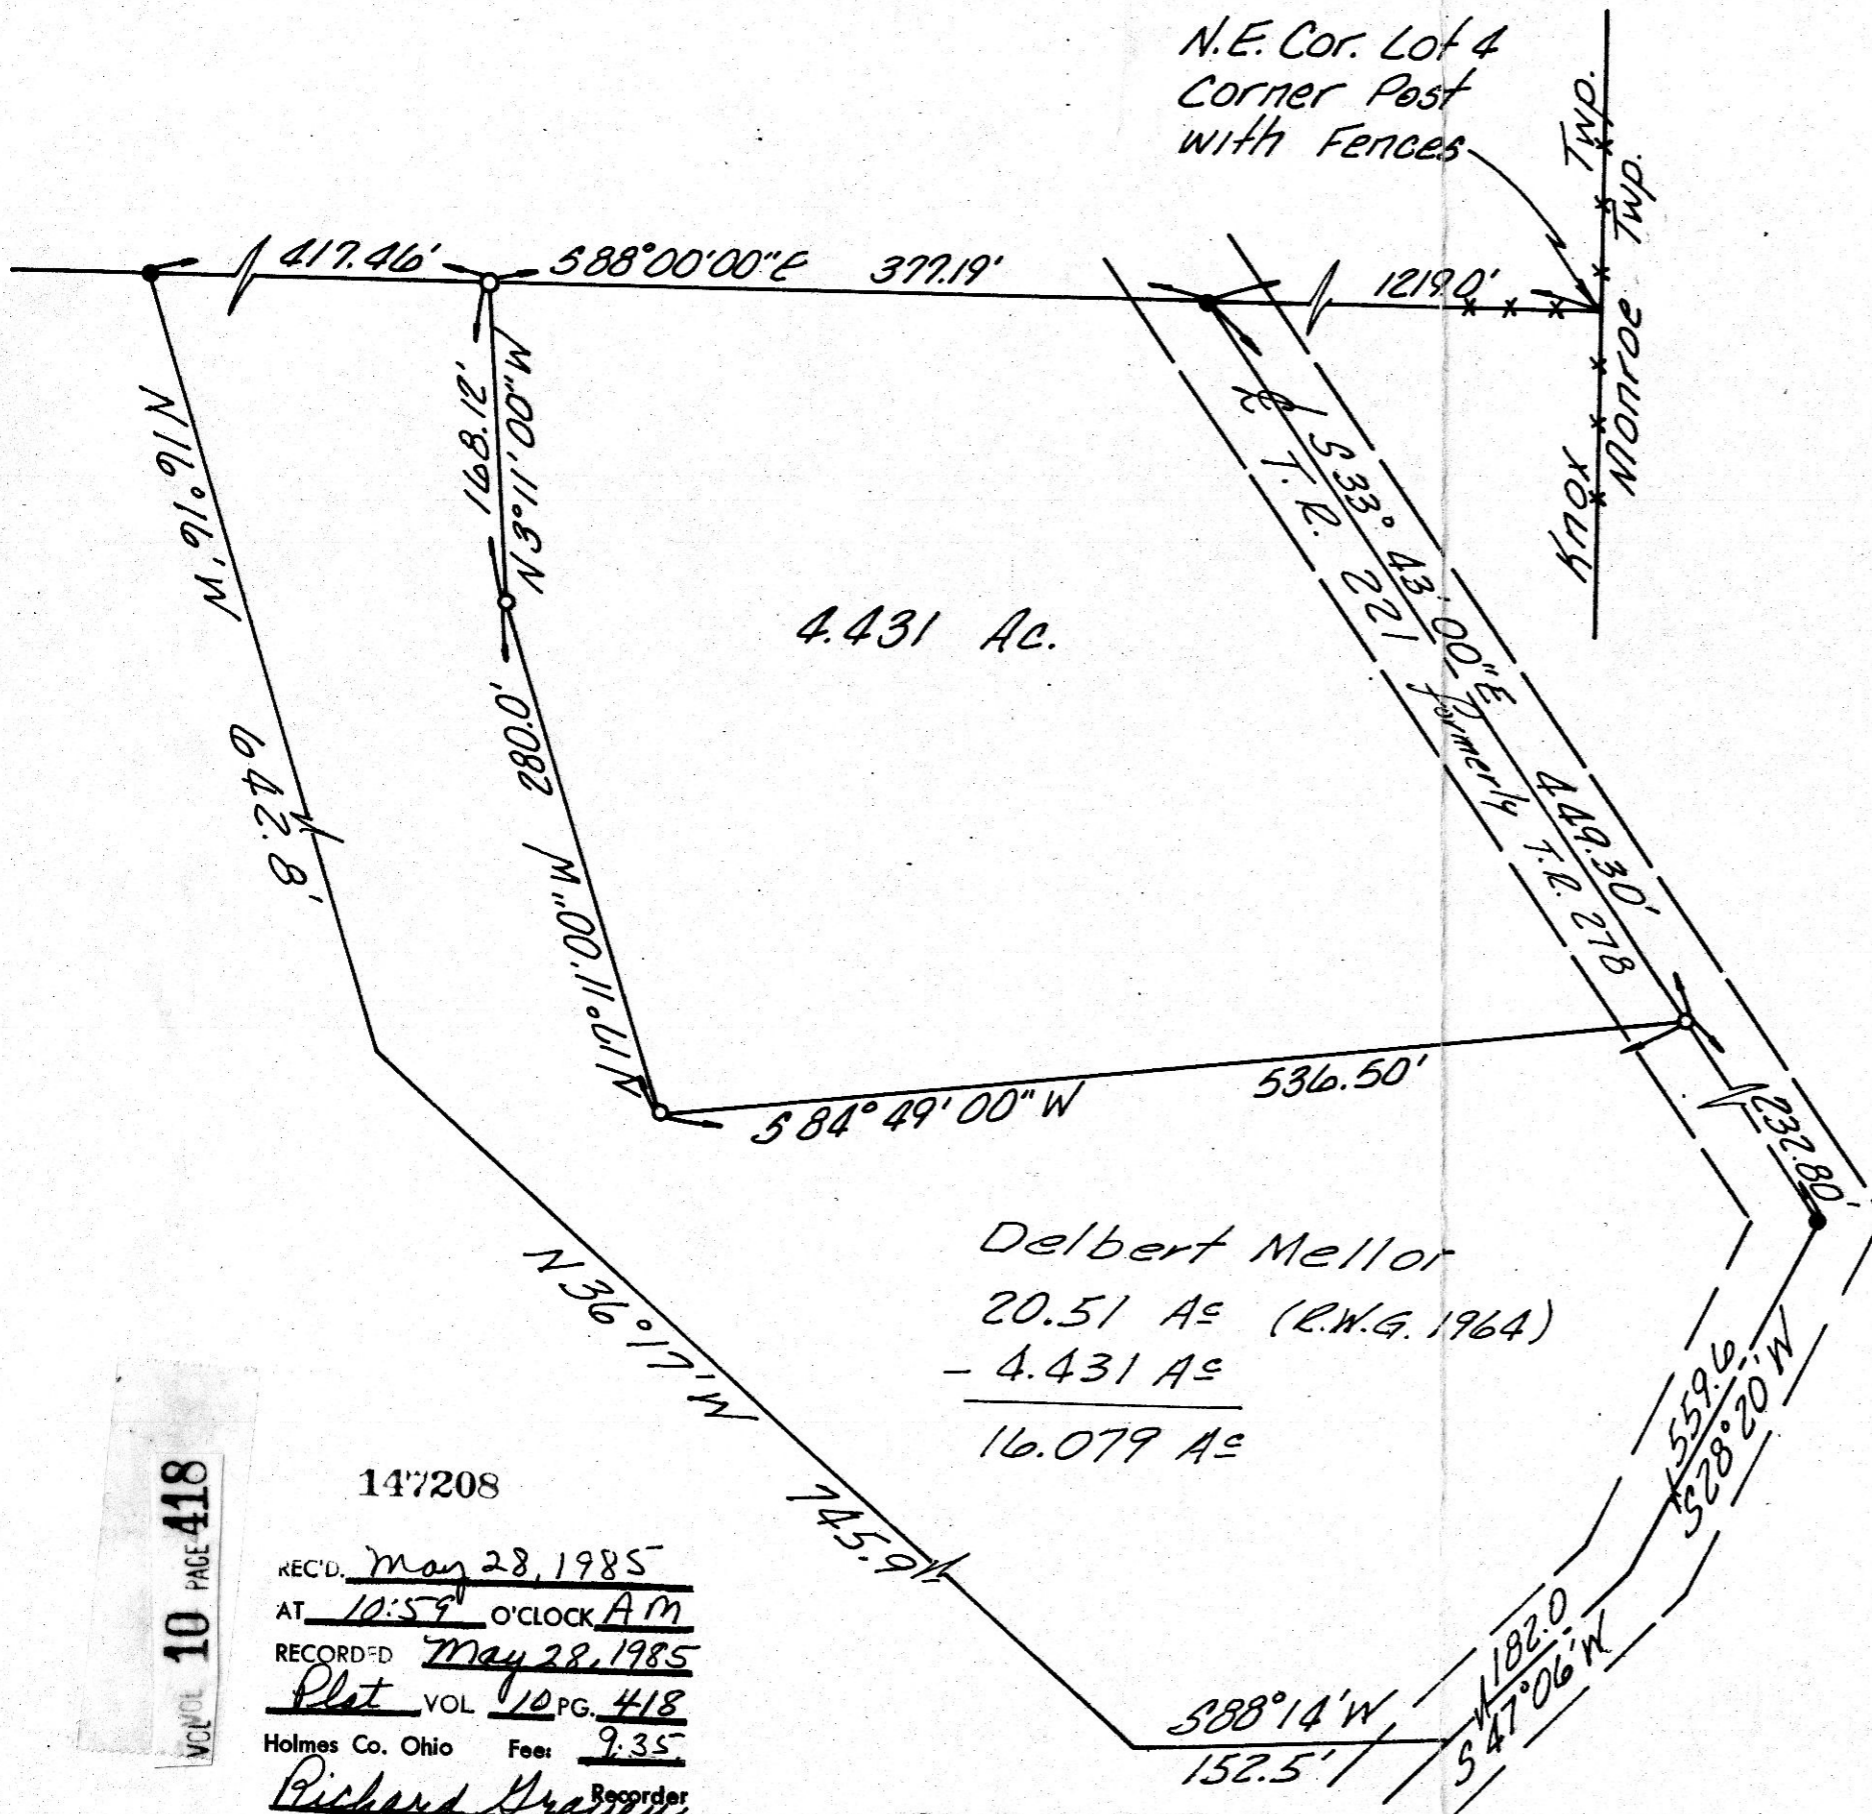

4.431 Ac.

Delbert Mellor
20.51 Ac (R.W.G. 1964)
- 4.431 Ac

16.079 Ac

147208

REC'D. May 28, 1985
AT 10:59 O'CLOCK AM
RECORDED May 28, 1985
Plot VOL 10 PG. 418
Holmes Co. Ohio Fee: 9.35

Richard [Signature] Recorder

VOL 10 PAGE 418