

THE COSHOCTON LAND SURVEYING SERVICE

233 S. FOURTH ST.



COSHOCTON, OHIO 43812

BEING PART OF: LOT 17
SEC. -
QUAR. 1ST
T9N, R8W
TOWNSHIP MONROE
COUNTY HOLMES

SURVEY FOR: MRS. NAZEL ASHER

DATE: MARCH, 1975

SCALE: 1" = 100'

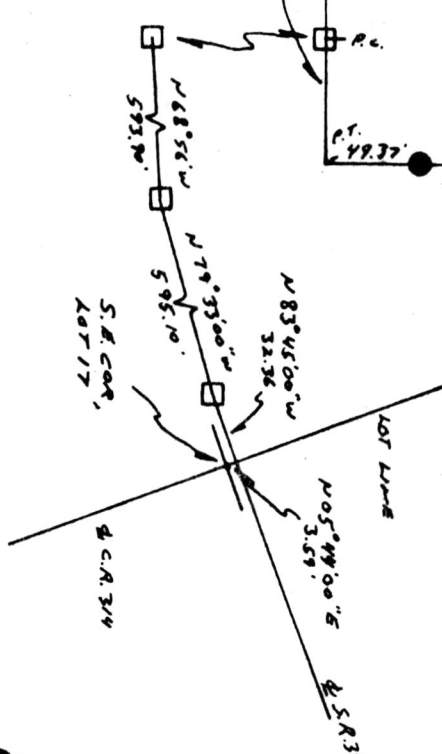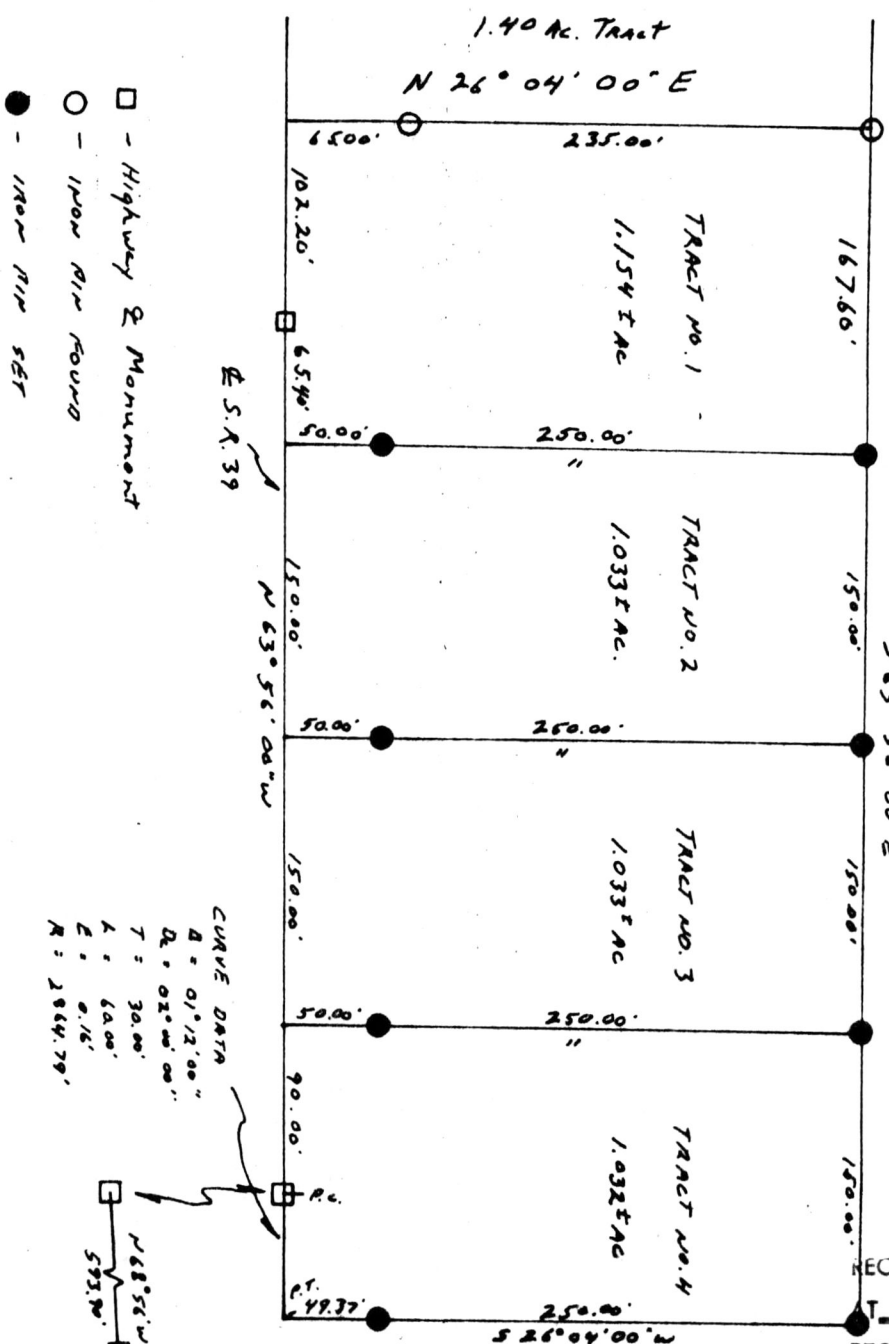

151414

REC'D. MAY 14 1986
10:54 O'CLOCK A.M.
RECORDED May 14, 1986
Plot VOL. 10 PG. 562
Holmes Co. Ohio Fee: 5.00

Richard Brown
Deed Vol. 231-Pg. 144



I hereby certify the above plat to be correct to the best of my knowledge and belief.

THE COSHOCTON LAND SURVEYING SERVICE

James V. Gute
REGISTERED SURVEYOR 5935

MAP OFFICE COPY