


MAP OFFICE COPY VOL 10 PAGE 671

154274
SURVEY PLAT of a 5.061 ACRE PARCEL

PART OF LOT 31
FOURTH QUARTER TOWNSHIP
T-10-N, R-5-W
Paint Township
HOLMES COUNTY, OHIO

Surveyed For: Junior & Fannie Swartzentruber
Deed Vol. 169, Pg. 34

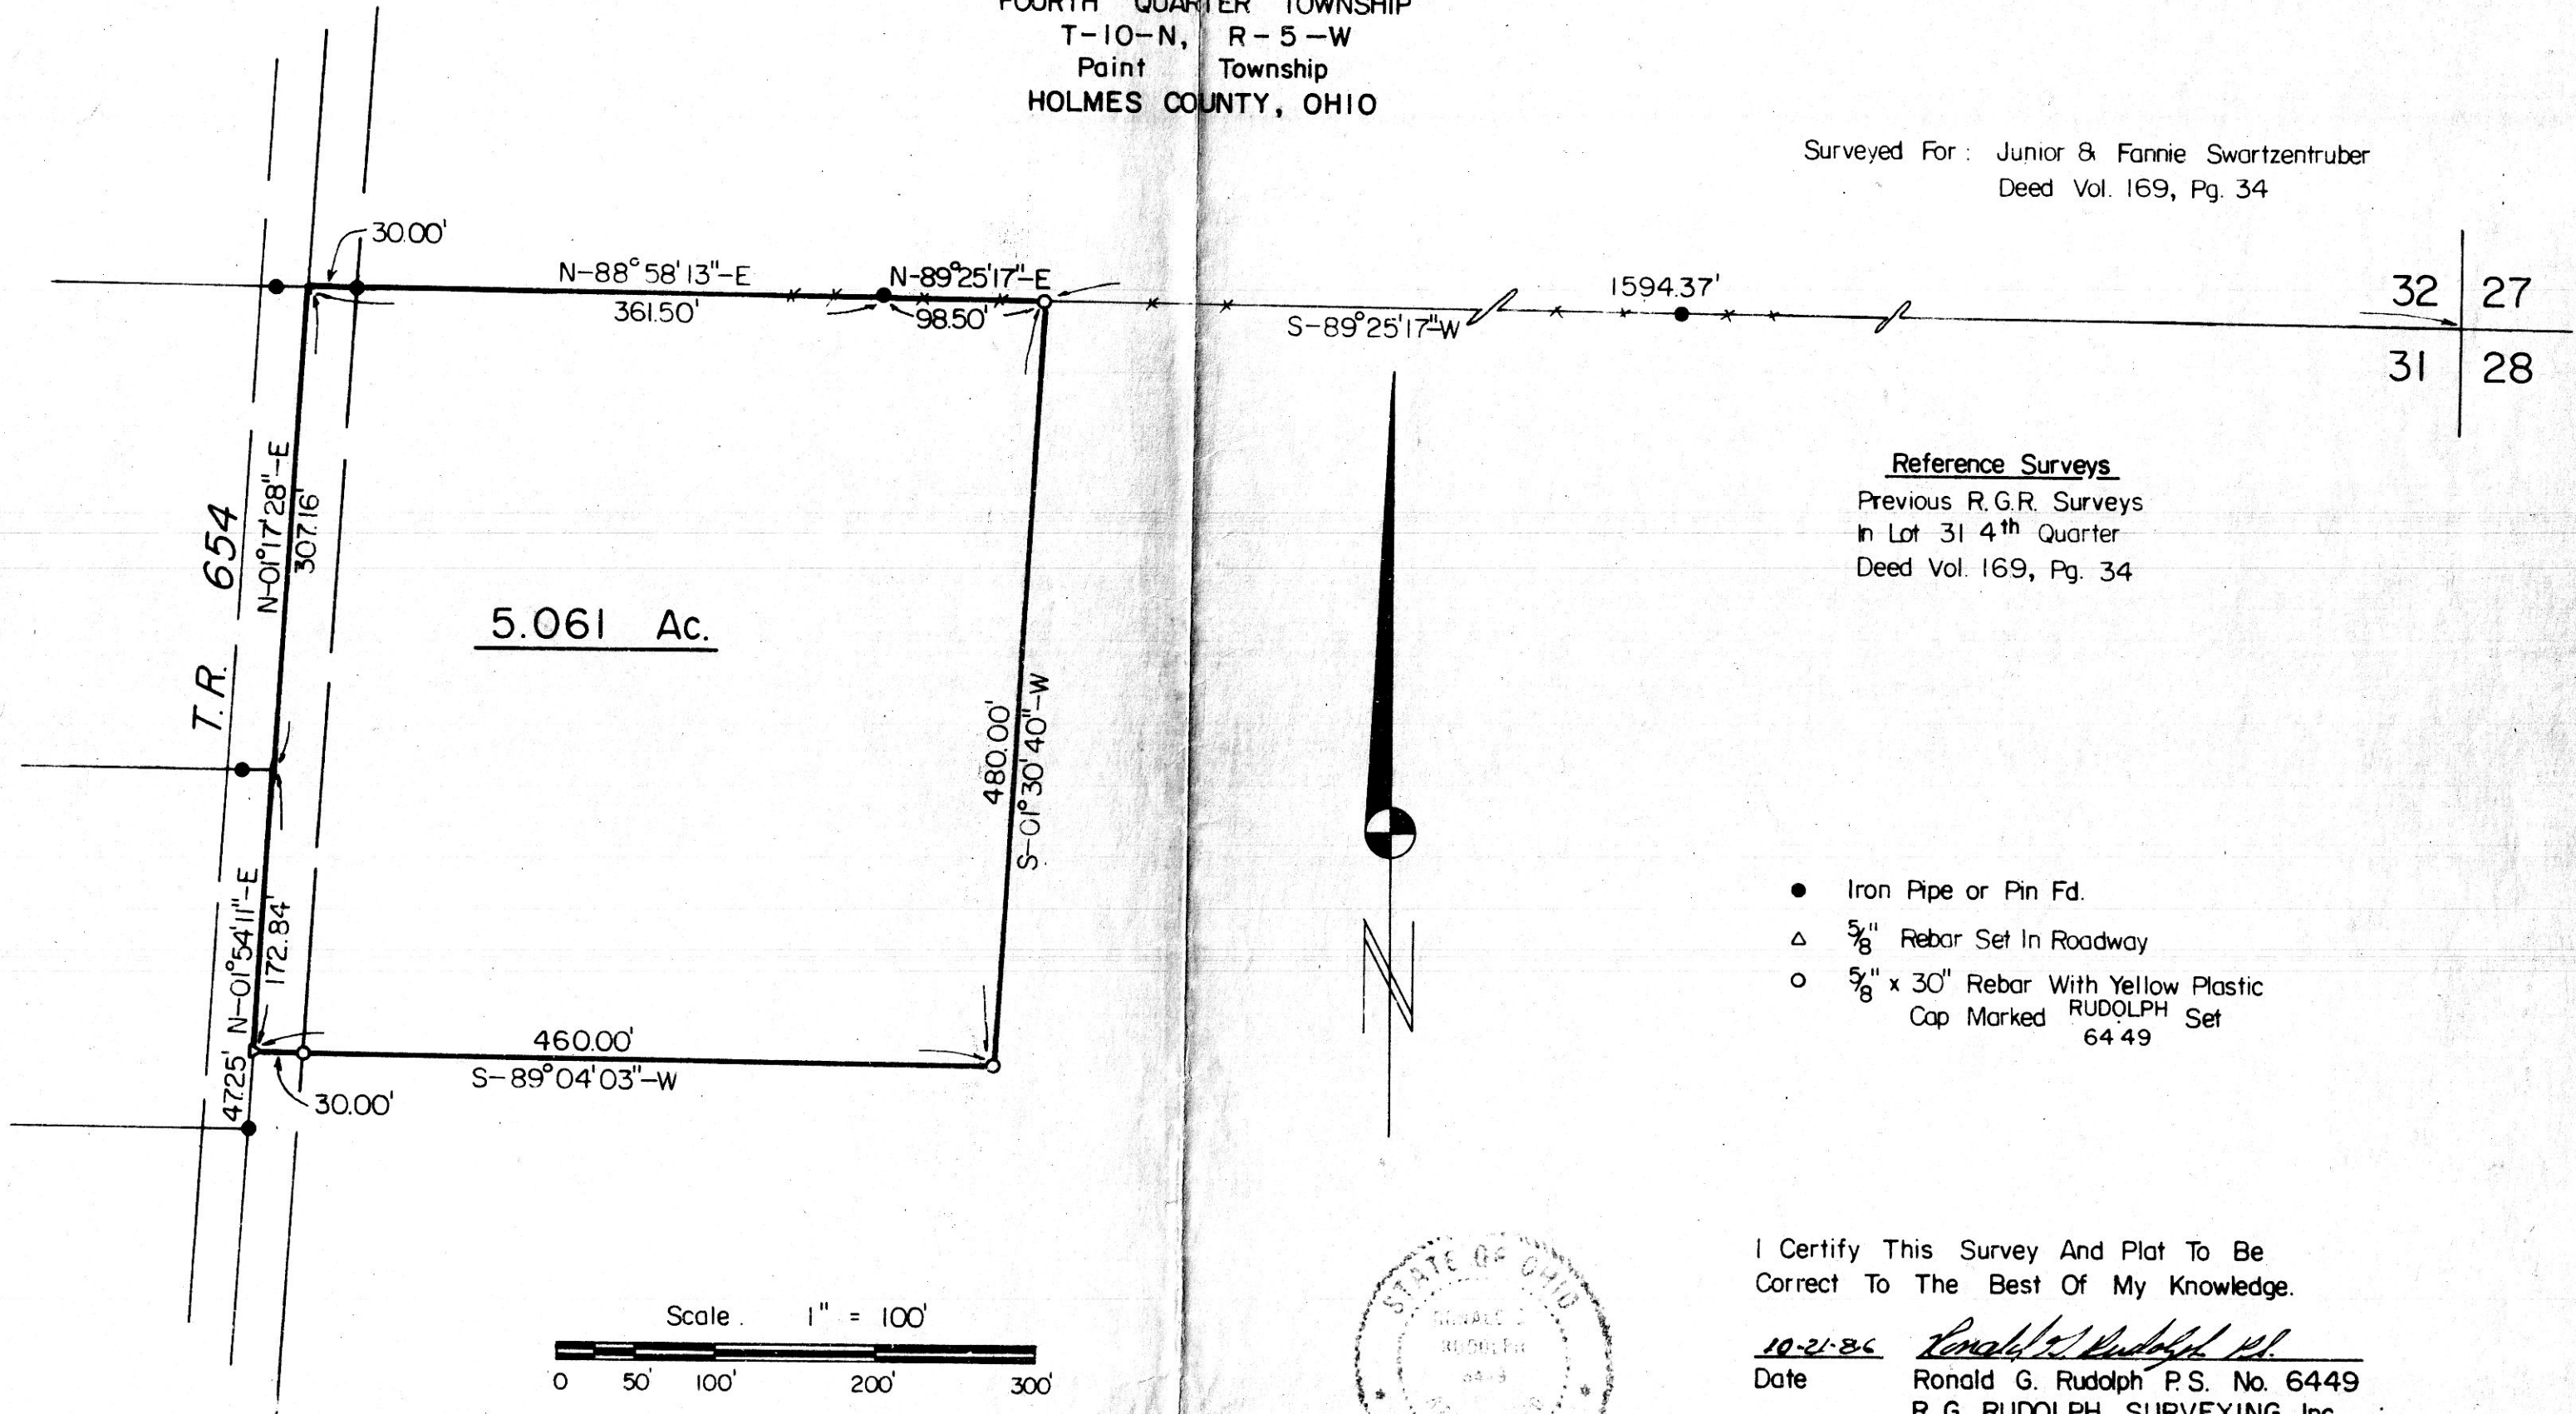


32	27
31	28

Reference Surveys
Previous R.G.R. Surveys
In Lot 31 4th Quarter
Deed Vol. 169, Pg. 34



- Iron Pipe or Pin Fd.
- △ 5/8" Rebar Set In Roadway
- 5/8" x 30" Rebar With Yellow Plastic Cap Marked RUDOLPH Set 6449

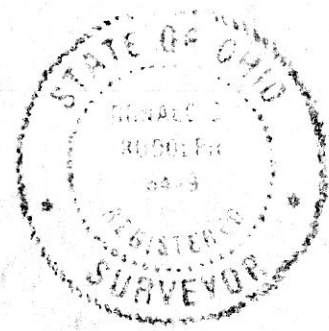

I Certify This Survey And Plat To Be Correct To The Best Of My Knowledge.

10-21-86 Ronald G. Rudolph, P.S.
Date Ronald G. Rudolph P.S. No. 6449
R. G. RUDOLPH SURVEYING, Inc.
405 W. Liberty St.
Wooster, Ohio 44691

Job No. 2476 154274

Deed Vol. 233 Pg. 757 Rec'd. DEC 23, 1986 AT 9:37 O'CLOCK AM
Recorded Dec 23, 1986 Holmes Co. Ohio Fee: 10.80
Plat Vol. 10 Pg. 671 Recorder: Richard Daven
Daw