

155409

I. Pin Fd

MAP OFFICE COPY

NORTH

This 1.000 Ac. plat is approved for residential wastewater.

met mill
Sanitarian

4-1-87
Date

SPLIT APPROVED # 870036

Roy A. & Martha Schlabach
Vol. 217 Pg. 941

I. Pin set 586° 12' 00" E 365.30'

N3°47'58"E
123.23'

1.000 AC.
Part of Vol. 217 Pg. 941

432.00'

114.06'

180.00'


465.00'

I. Pin Fd) 587° 37' 57" E 369.24
P.B. 8 Pg. 867

Paul A. & Ella Coblentz

I. Pin set N 1°53'02" E 546.06'
Lowell & Nancy Kandel


I. Pin Fd Elmer D. & Amanda Mast
SEC. 6, T. 9 N., R. 5 W.

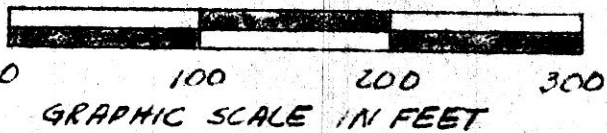

PLAT OF A SURVEY FOR ABE J. SCHLABACH

KNOWN as part of Lot 16, 1st Qtr., T. 9 N., R. 6 W., of Berlin Twp., Hol. Co., Ohio

Robert L. Kasner P.S. 5193
P.E. 28820
2/17/87

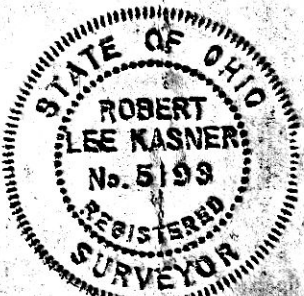

S.E. CORNER Lot 16,
1st Qtr., T. 9 N.,
R. 6 W., of
Berlin Twp.
Hol. Co., Ohio

Stone Fd 1984, D. Author
P.B. 7 Pg. 787, 149 N3°47'58"E 645.00'
P.B. 8 Pg. 867
Albert & Esta Rober

155409

Deed Vol. 234 pg. 702

APR 2 1987
Rec'd. APR 2 1987 AT 11:12 o'clock AM

Recorded Holmes Co. Ohio Fee: 5.00

Plat Vol. 10 Pg. 715 Recorder Richard Brown