

155095

L.L. & M.M. MOORE

N.W. COR. OF S.W. QTR. OF N.E. QTR. SECTION 23

8.3920 AC.

5.0426 AC.

41.8269 AC.

FREEMAN & EFFIE MAST

L.M. & L.A. TONER

R.E. & R. MILLER

SNOW

T.R. 72 WIDTH UNKNOWN


DEED OF DIANE MARTIN DEED VOL 234, PG 95

1.001 AC \* NO BLDG'S

\* ANNEX TO 5.0426 AC PARCEL TO THE NORTH

I HEREBY CERTIFY THAT I HAVE FOUND OR SET THE MONUMENTATION AS SHOWN HEREON, AND THAT THE SAME MEETS THE STANDARDS FOR THE STATE OF OHIO.

JOHN M. JOHANYAK, P.S. 6183

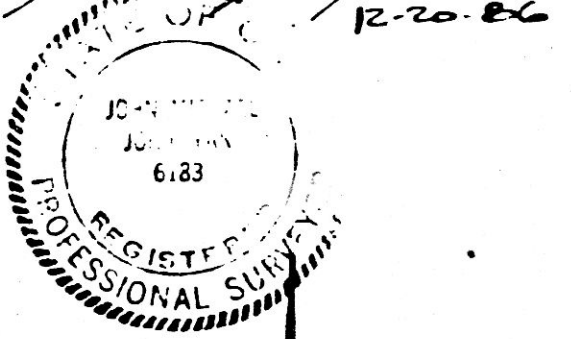

- - DENOTES IRON PIN FD. & USED
- - DENOTES SOLID # 5 BAR SET

PROPERTY LOCATION:

Address 1603 T.R. 72  
 City of \_\_\_\_\_  
 Village of \_\_\_\_\_  
 Township of KILLBUCK  
 County of HOLMES  
 State of Ohio \_\_\_\_\_  
 Allotment \_\_\_\_\_  
 P.B. \_\_\_\_\_ Pg. \_\_\_\_\_  
 Township Lot \_\_\_\_\_ Section 23 NE 1/4  
 Township No. 8 Range \_\_\_\_\_  
 New Owner N/A  
 Present Owner FREEMAN & EFFIE MAST

Scale 1" = 200' Date 12-23-87  
 Rev 3-23-87  
 Rev 4-12-87

Deed Vol. 234 Pg. 955

Rec'd. APR 24 1987 AT 1:32 O'CLOCK Pm  
 Recorded APR 27 1987 Holmes Co. Ohio Fee: 8.00  
 Plat Vol. 10 Pg. 428 Recorder: Richard Weaver



John Johanyak & Associates  
 P.O. Box 103  
 Doylstown, Ohio 44230  
 (216) 658-3131