

PRAIRIE TOWNSHIP  
S.E. QTR. SECTION 9  
TWP. 13 N RANGE 13 W  
HOLMES COUNTY, OHIO


156250



I.P. FD. OVER STONE

BANDS, CO. 211-678

MAP OFFICE COPY

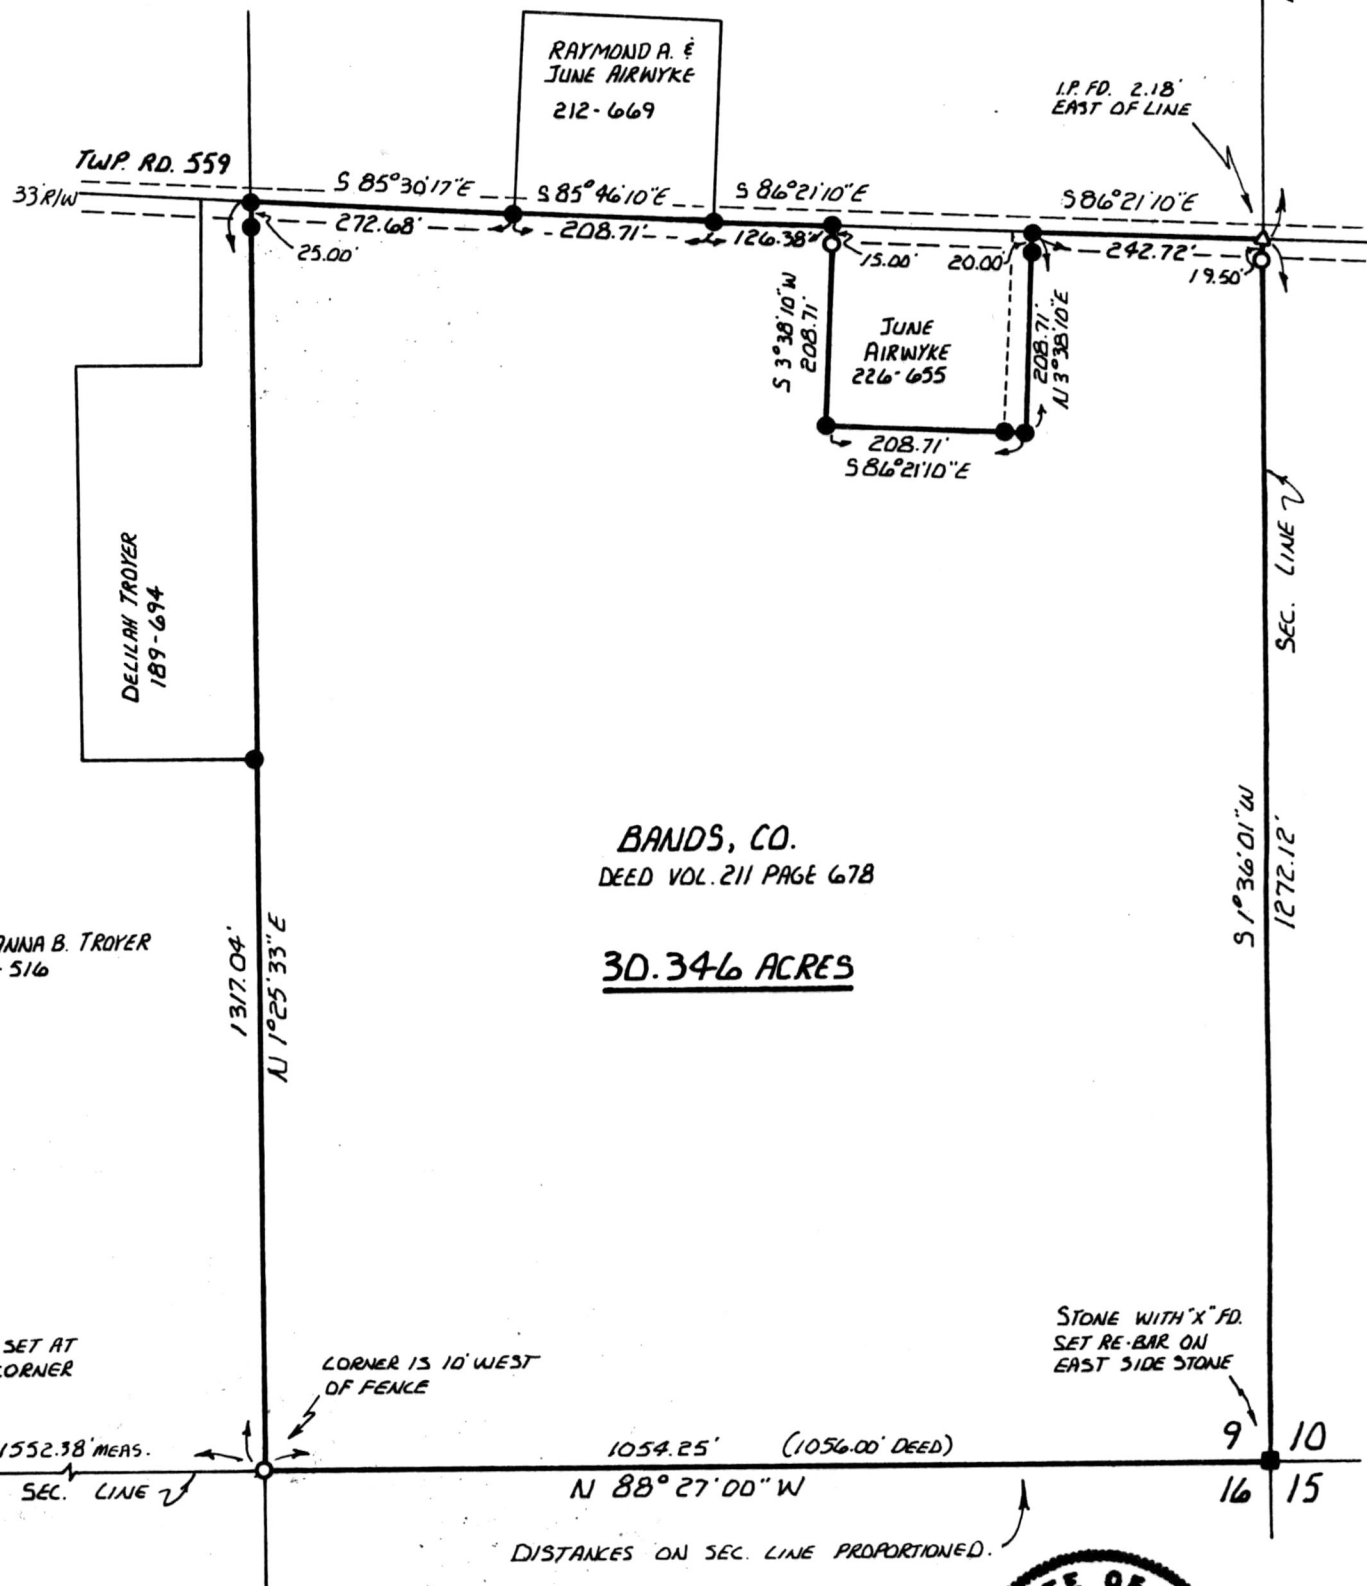

BANDS, CO.  
DEED VOL. 211 PAGE 678

30.346 ACRES

DAN R. & ANNA B. TROYER  
169-516

STONE WITH "X" FD.  
SET RE-BAR ON  
EAST SIDE STONE


RE-BAR SET AT  
FENCE CORNER

CORNER IS 10' WEST  
OF FENCE

1552.38' MEAS.  
SEC. LINE

1054.25' (1056.00' DEED)  
N 88° 27' 00" W

DISTANCES ON SEC. LINE PROPORTIONED.

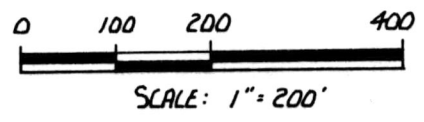

- STONE FOUND
- IRON PIN FOUND
- 5/8" RE-BAR WITH I.D. CAP SET
- △ R.R. SPIKE SET

REFERENCES:  
VARIOUS DEEDS AS SHOWN  
PLAT VOL. 7 PAGE 390  
PLAT VOL. 8 PAGE 694  
BEARINGS FROM SAME

156250  
Deed Vol. 235 Pg 494  
REC'D. JUN 8 1987  
AT 7:14 o'clock AM  
RECORDED JUN 8 1987  
Plat VOL 10 PG. 755  
Holmes Co. Ohio Fee: 5.00  
Richard Harmon Recorder  
RR

I CERTIFY THIS SURVEY TO BE CORRECT  
TO THE BEST OF MY KNOWLEDGE.  
Donald C. Baker  
DONALD C. BAKER P.S. 6938  
4321 T.R. 252  
GLENMONT, OH.  
MAY 26, 1987