

158176


VILLAGE OF BERLIN
PART OF OUTLOT 6
N.W. QTR. SEC. 15 T-9N; R-5W
BERLIN TWP. HOLMES CO. OHIO



- IRON PIN FOUND
- 5/8" REBAR WITH I.D. CAP SET
- HWY. MON.


REFERENCES:

PLAT VOL. 8 PAGE 343
BEARINGS FROM PLAT VOL. 4
PAGE 173

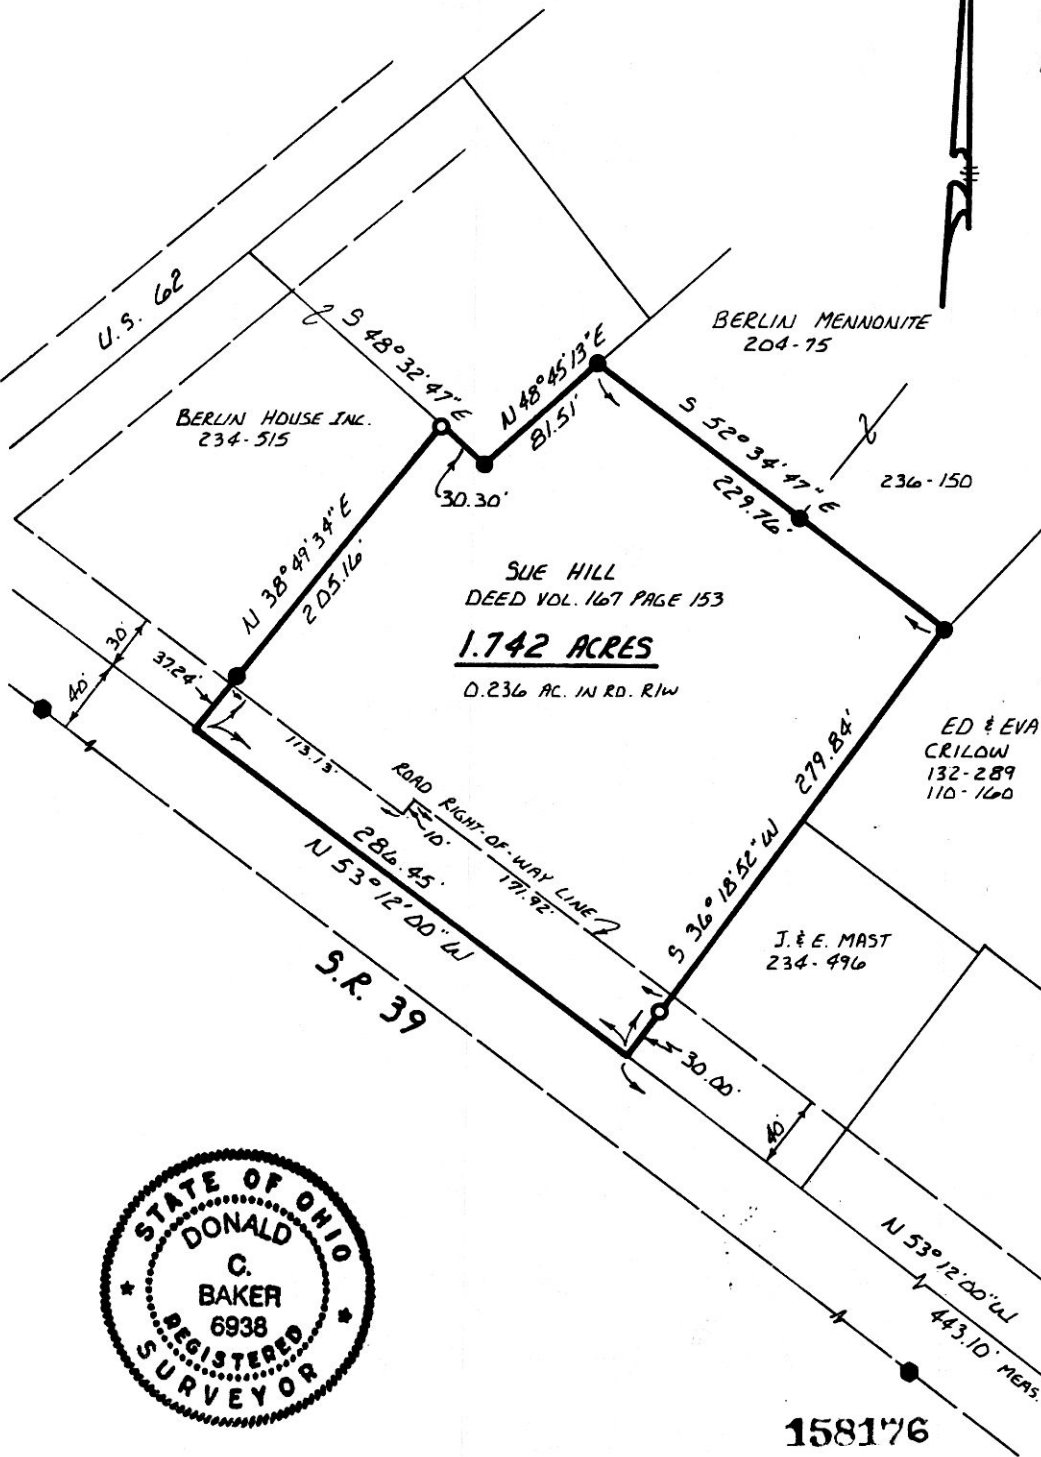

1.742 ACRES

D. 236 AC. IN RD. R/W

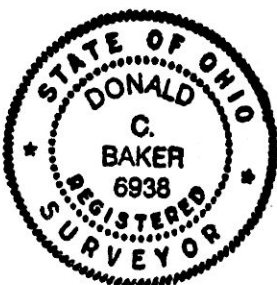

I CERTIFY THIS SURVEY TO BE CORRECT
TO THE BEST OF MY KNOWLEDGE.


Donald C Baker
DONALD C. BAKER P.S. 6938
4321 T.R. 252
GLENMONT, OH.

DEC. 1, 1987

Deed Vol. 237 Page 391

Rec'd. DEC 14 1987
Recorded DEC 15 1987
Plat Vol. 10

AT 11:49 O'CLOCK AM.
Holmes Co. Ohio Fee: 5.00
Pg. 274 Recorder: *Richard ...*
Parlamis

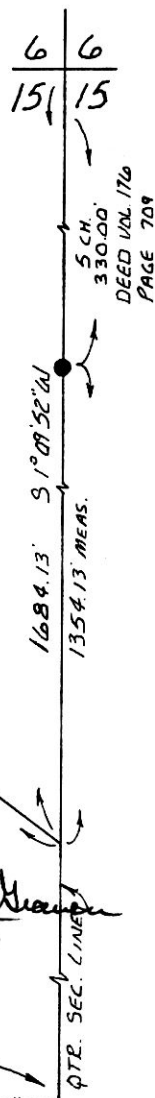

MAP OFFICE COPY

S.E. COR.
N.W. QTR.
SEC. 15