


MONRDE TWP. 2<sup>ND</sup> QTR.  
PART OF LOT 24  
U.S.M.L. T-9N; R-8W  
HOLMES COUNTY, OHIO



SCALE: 1" = 200'

- I.P. FOUND
- 5/8" RE-BAR SET WITH I.D. CAP

REFERENCE:  
SURV. PLAT VOL. 9 PAGES 96 & 108  
DEED VOL. 208 PAGE 511  
BEARINGS FROM SAME

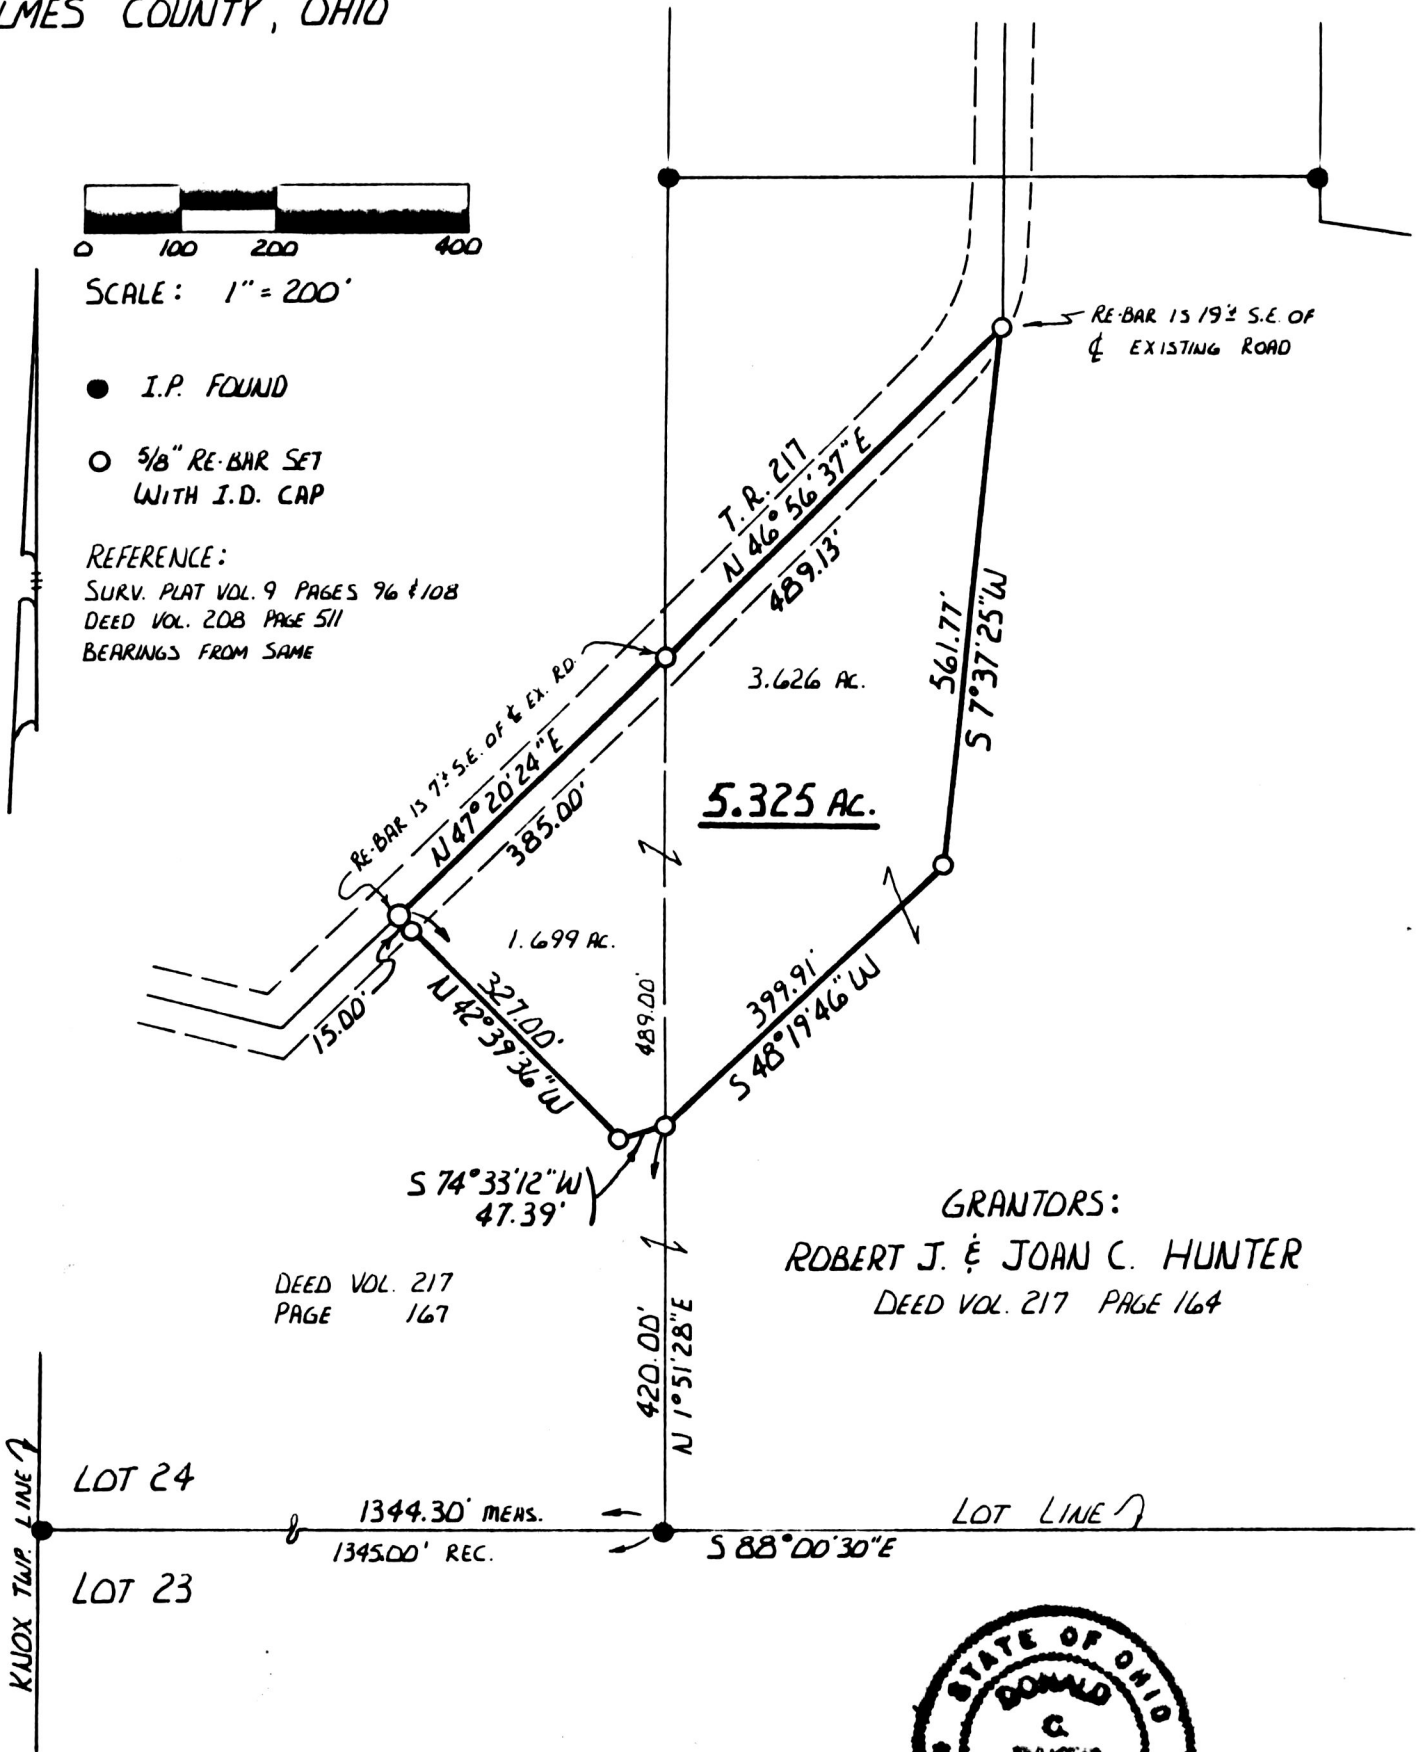

GRANTORS:  
ROBERT J. & JOAN C. HUNTER  
DEED VOL. 217 PAGE 164

DEED VOL. 217  
PAGE 167

MAP OFFICE COPY

158286



I CERTIFY THIS SURVEY TO BE  
CORRECT TO THE BEST OF MY KNOWLEDGE.

Donald C. Baker

DONALD C. BAKER

P.S. 6938

APRIL 3, 1986

Rec'd. DEC 22 1987

AT 2:17 O'CLOCK PM

Recorded DEC 23 1987

Holmes Co. Ohio Fee: \$ 5.00

Plat Vol. 10

No. 881

Richard Green

R. Post

Deed Vol. 237 Page 519