


PAIN TOWNSHIP
HOLMES COUNTY
SW QTR. SECTION 4, T-14N, R-11W

160043



Bearings Assumed

- Iron Pipe Found
- Iron Pin Set - 5/8" Rebar With Yellow Cap Marked "LONG-6505"

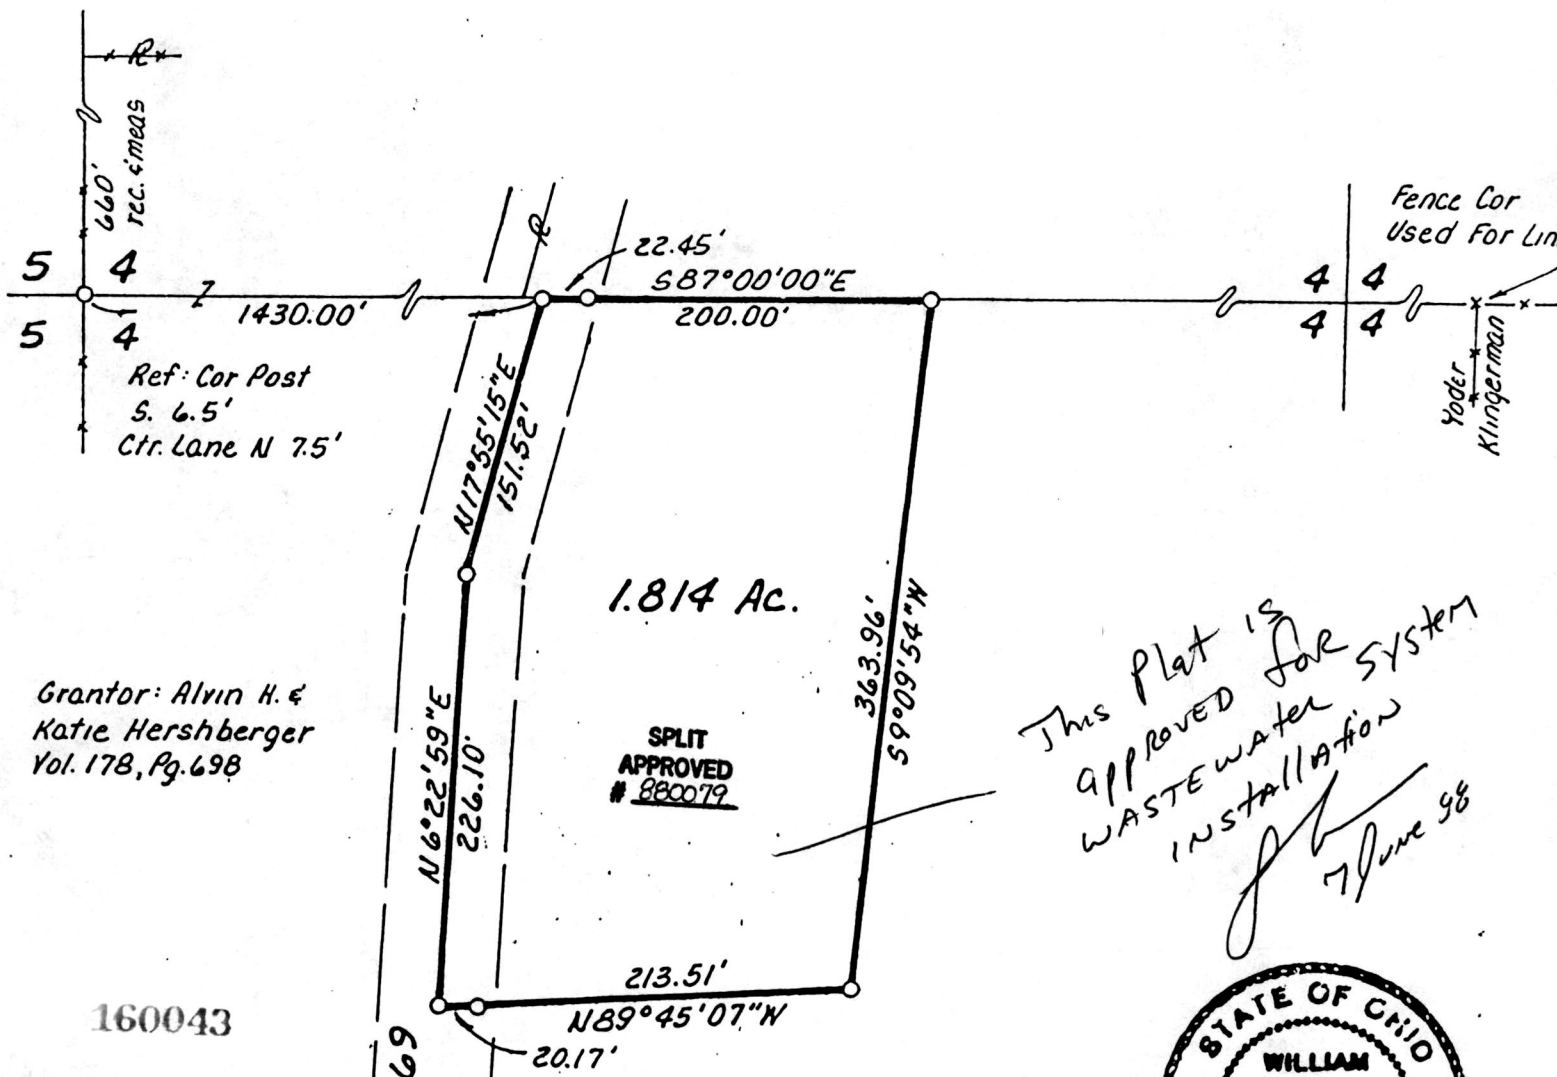

Grantor: Alvin H. &
Katie Hershberger
Vol. 178, Pg. 698

This Plat is
APPROVED for
WASTEWATER
SYSTEM
INSTALLATION
7 June 98



160043

Deed Vol. 239 Pg. 318

REC'D. JUN 8 1988
AT 11:22 O'CLOCK PM
RECORDED JUN 9 1988
Plat VOL 12 PG. 9
Holmes Co. Ohio Fee: 5.00
Richard Haver Recorder

T.R. 669
1435'

Wengerd

I Certify This Survey To Be Correct
To The Best Of My Knowledge
William H Long Feb 12, 1988
William H. Long R.S. 6505
LONG SURVEYING, INC.
13301 T.R. 503
Big Prairie, Ohio 44611

MAP OFFICE COPY