


WALNUT CREEK TOWNSHIP 1ST QTR.  
LOT 25 T-9N ; R-5 W  
HOLMES COUNTY, OHIO


161387

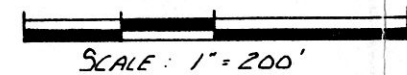

- IRON PIN FOUND
- CORNER POST
- 5/8" REBAR WITH I.D. CAP SET I.D. CAP MARKED "BAKER 6938"

REFERENCES:  
 SURVEY RECORD 2 PAGE 372  
 PLAT VOL. 10 PAGE 250  
 PLAT VOL. 11 PAGE 97  
 BEARINGS FROM PLAT VOL. 10 PAGE 315  
 VARIOUS DEEDS AS SHOWN

I CERTIFY THIS SURVEY TO BE CORRECT TO THE BEST OF MY KNOWLEDGE.  
 Donald C. Baker  
 DONALD C. BAKER P.S. 6938  
 4321 T.R. 252  
 GLENMONT, OH.  
 AUG. 1, 1988

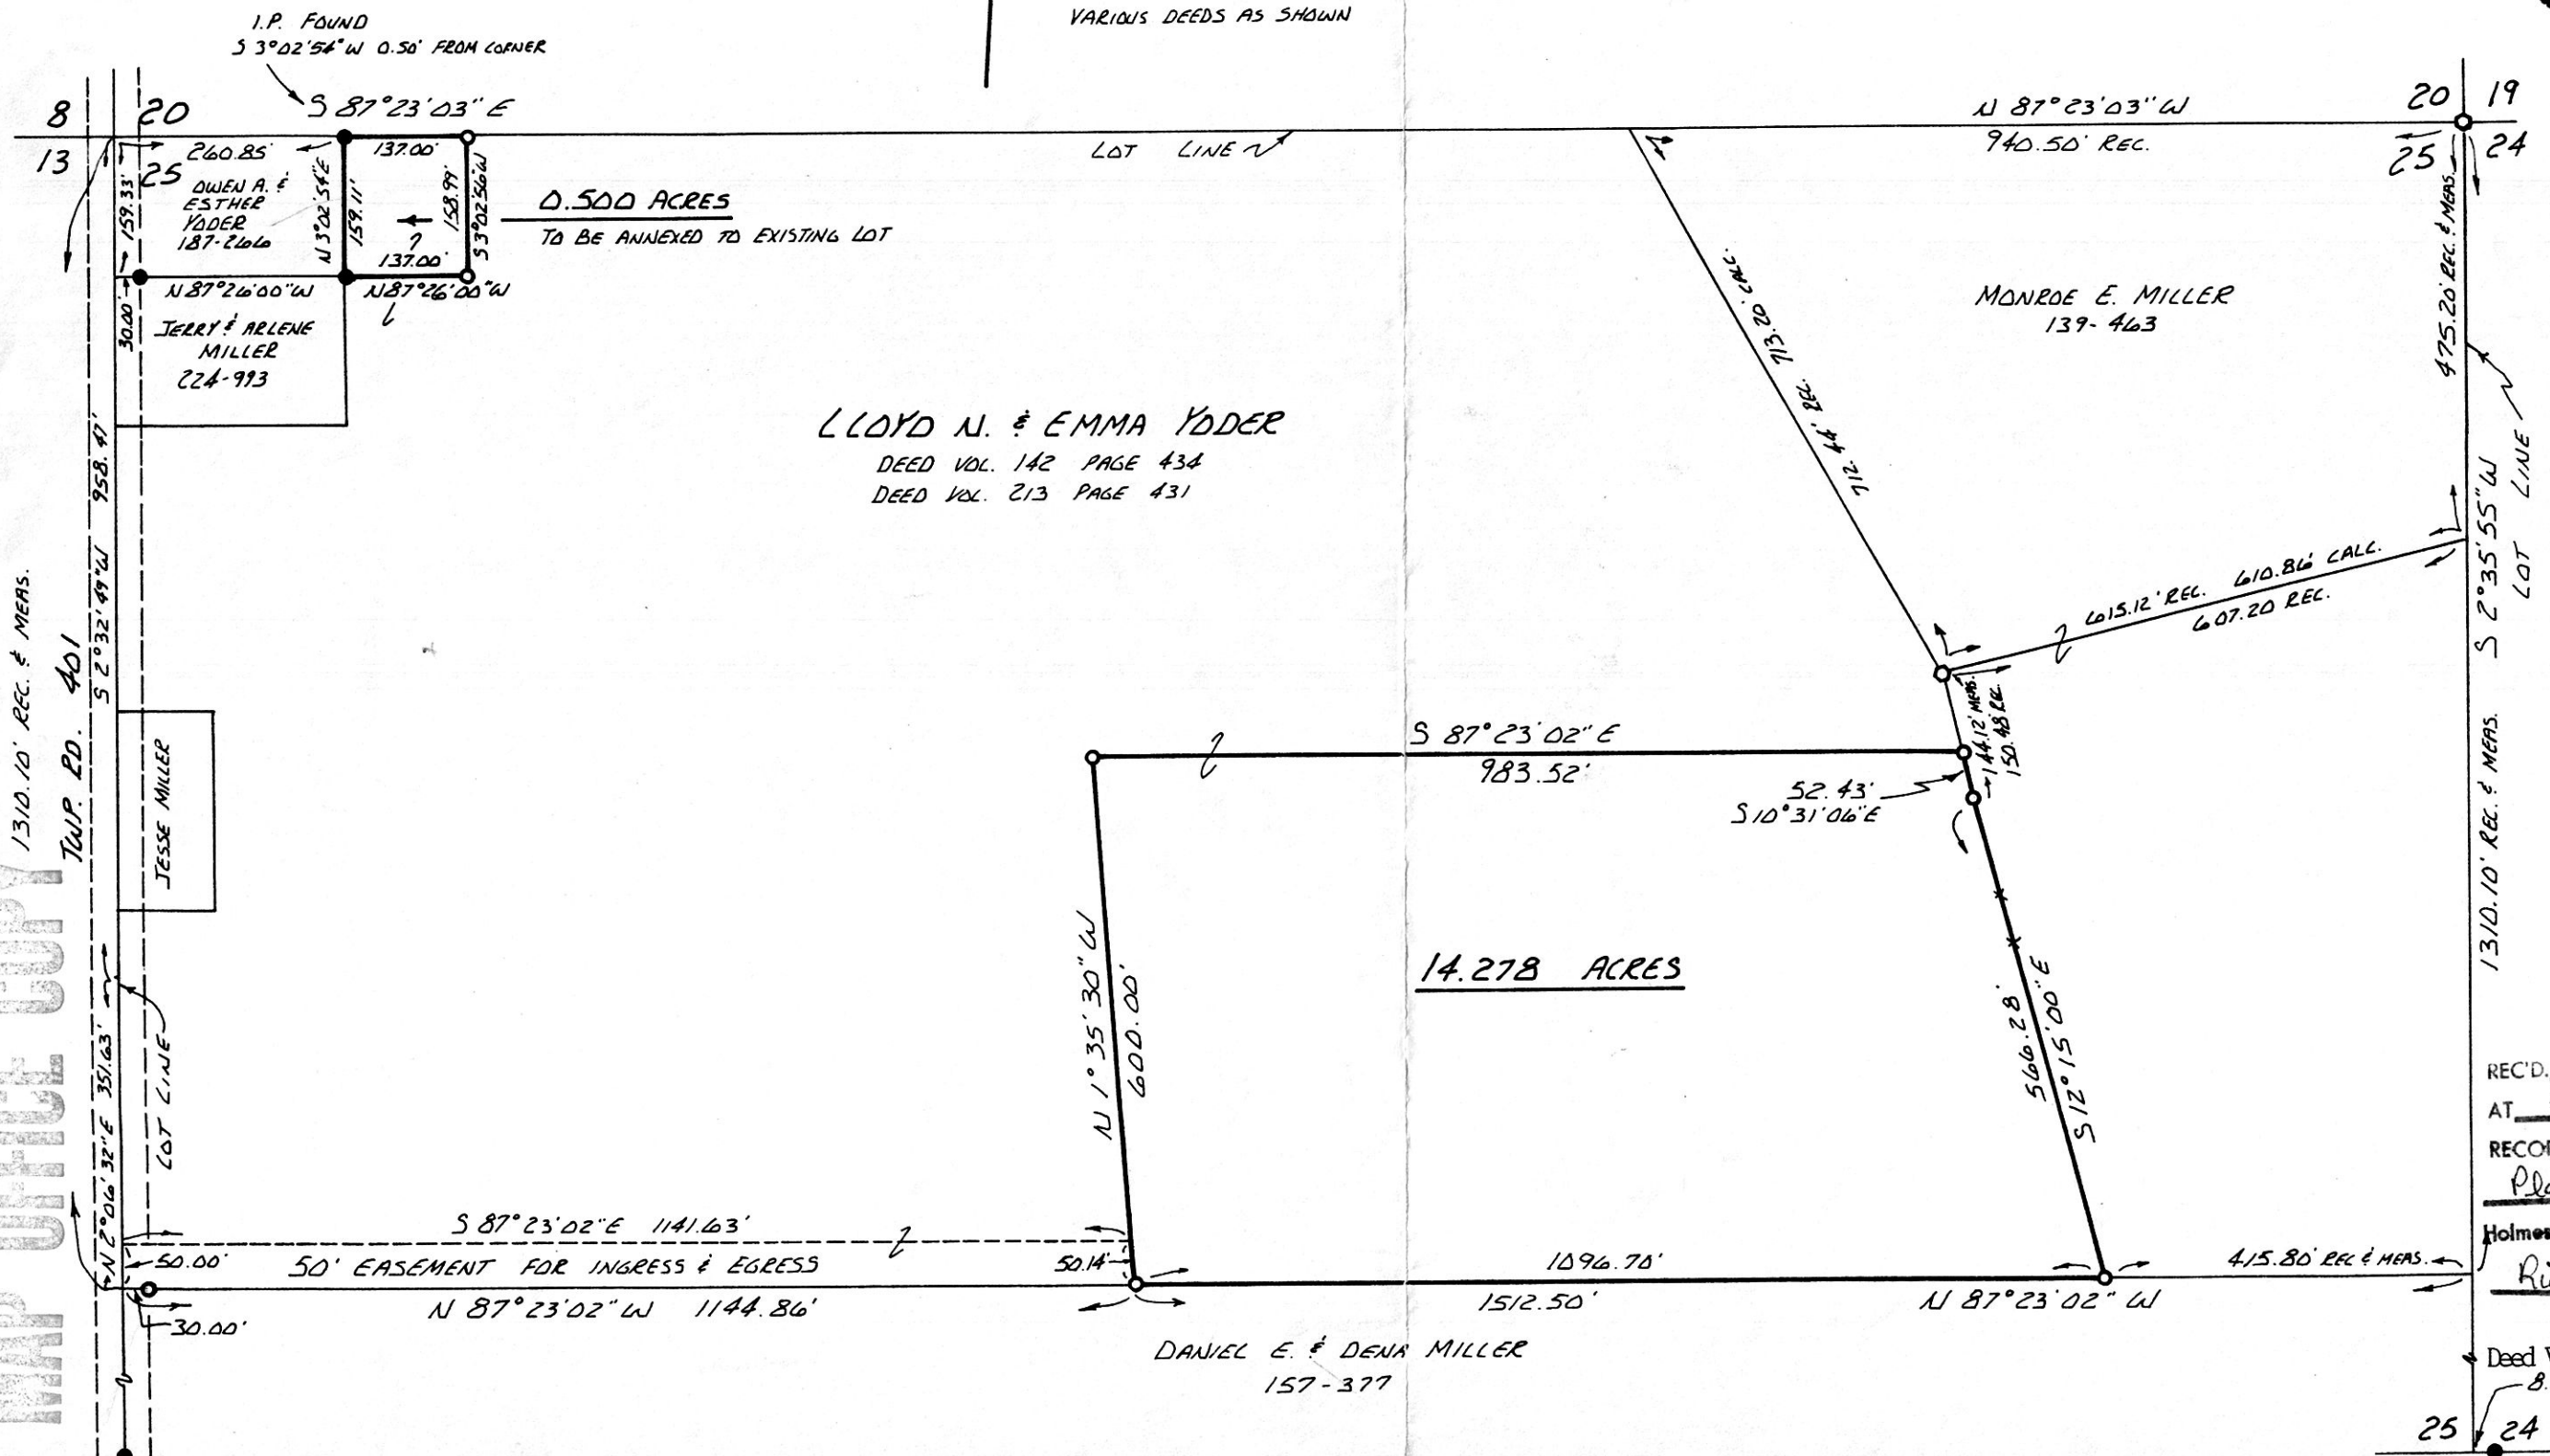

MAP OFFICE COPY  
1310.10' REC. & MEAS.  
TWP. RD. 401

161387

OCT 11 1988

REC'D. AT 4:01 O'CLOCK PM  
 RECORDED OCT 12 1988  
 Plat VOL 12 PG 87  
 Holmes Co. Ohio Fee: 9.35  
 Richard Yawen Recorder  
 Paul Miller  
 Deed Vol. 240 Pg. 789  
 8.00'