
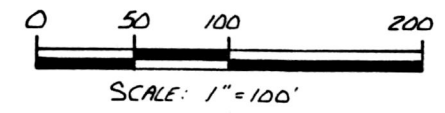


KILLBUCK TOWNSHIP
N.W. QTR. SECTION 7
N.E. QTR. SECTION 7
T-8N R-7W
HOLMES COUNTY, OHIO

REPLAT
OF PLAT VOL. 10 PAGE 827
FOR CORRECTION

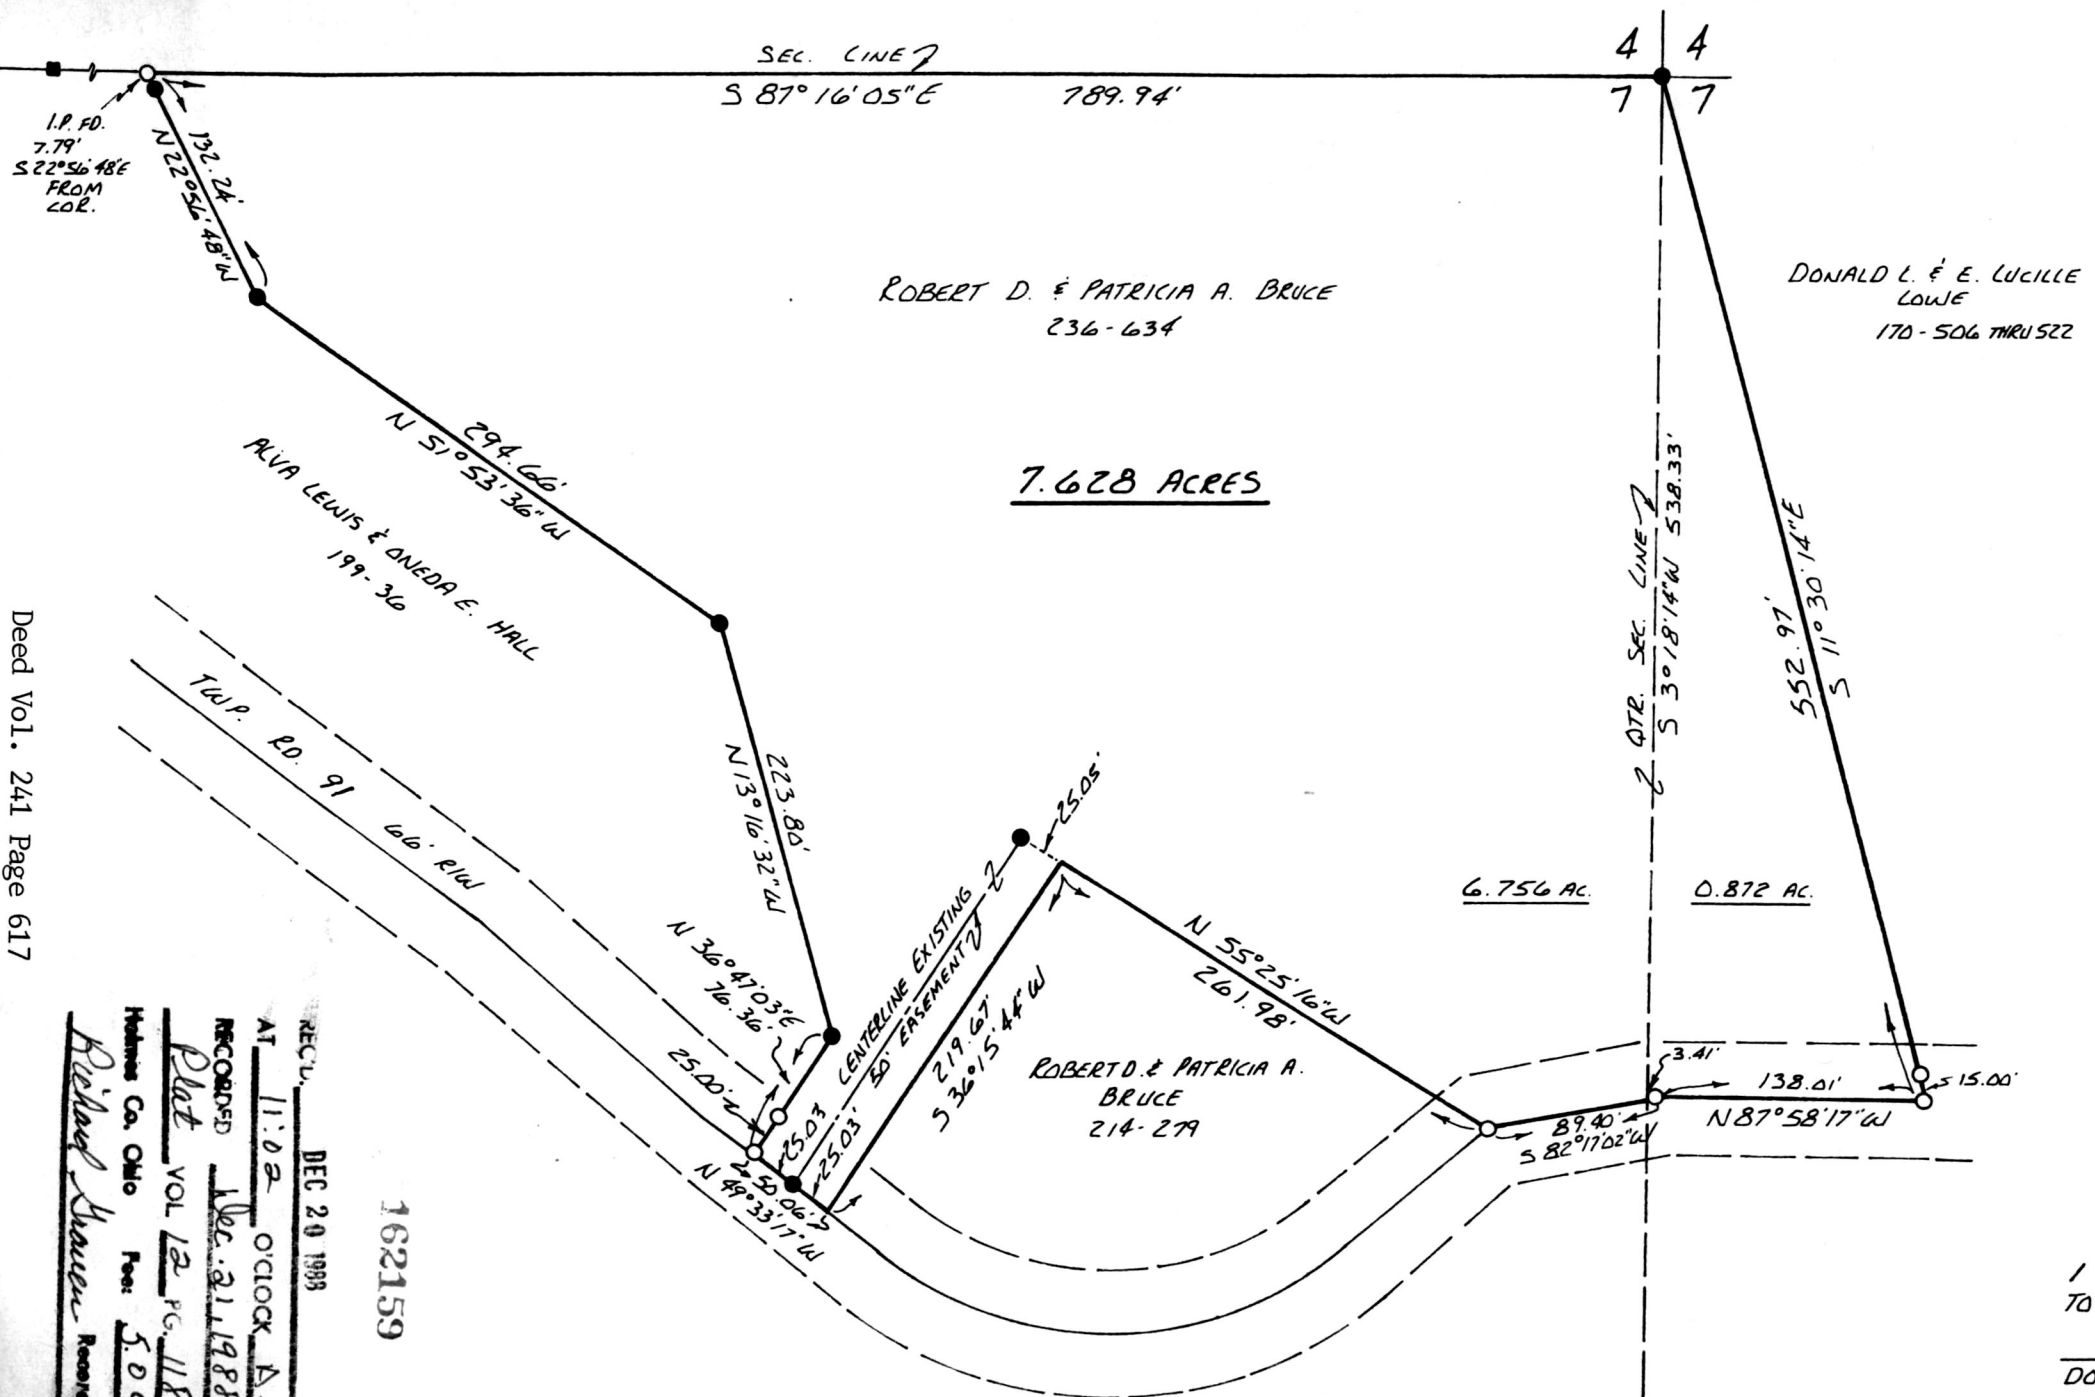

- IRON PIN FOUND
- STONE FOUND
- 5/8" REBAR WITH I.D. CAP SET
I.D. CAP MARKED "BAKER 6938"

REFERENCES:
 PLAT 6 PAGE 48
 PLAT 10 PAGE 827
 BEARINGS FROM PLAT 13
 23



I CERTIFY THIS SURVEY TO BE CORRECT
 TO THE BEST OF MY KNOWLEDGE.

Donald C. Baker
 DONALD C. BAKER P.S. 6938
 4321 TR 252
 GLEN MONT, OH
 DEC. 6, 1988

MAP OFFICE COPY

Deed Vol. 241 Page 617

162159

REC'D DEC 20 1988
 AT 11:02 O'CLOCK A.M.
 RECORDED Dec. 21, 1988
 Plat VOL 12 PG. 118
 Holmes Co. Ohio Fee: 5.00
 Richard Hansen Recorder