



BERLIN TOWNSHIP  
S.W. QTR. SECTION 7  
T-9N R-5W  
HOLMES COUNTY, OHIO

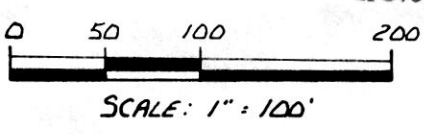

- IRON PIN FOUND
- ▲ R.R. SPIKE FOUND
- △ R.R. SPIKE SET
- 5/8" REBAR WITH I.D. CAP SET  
I.D. CAP MARKED "BAKER 6938"

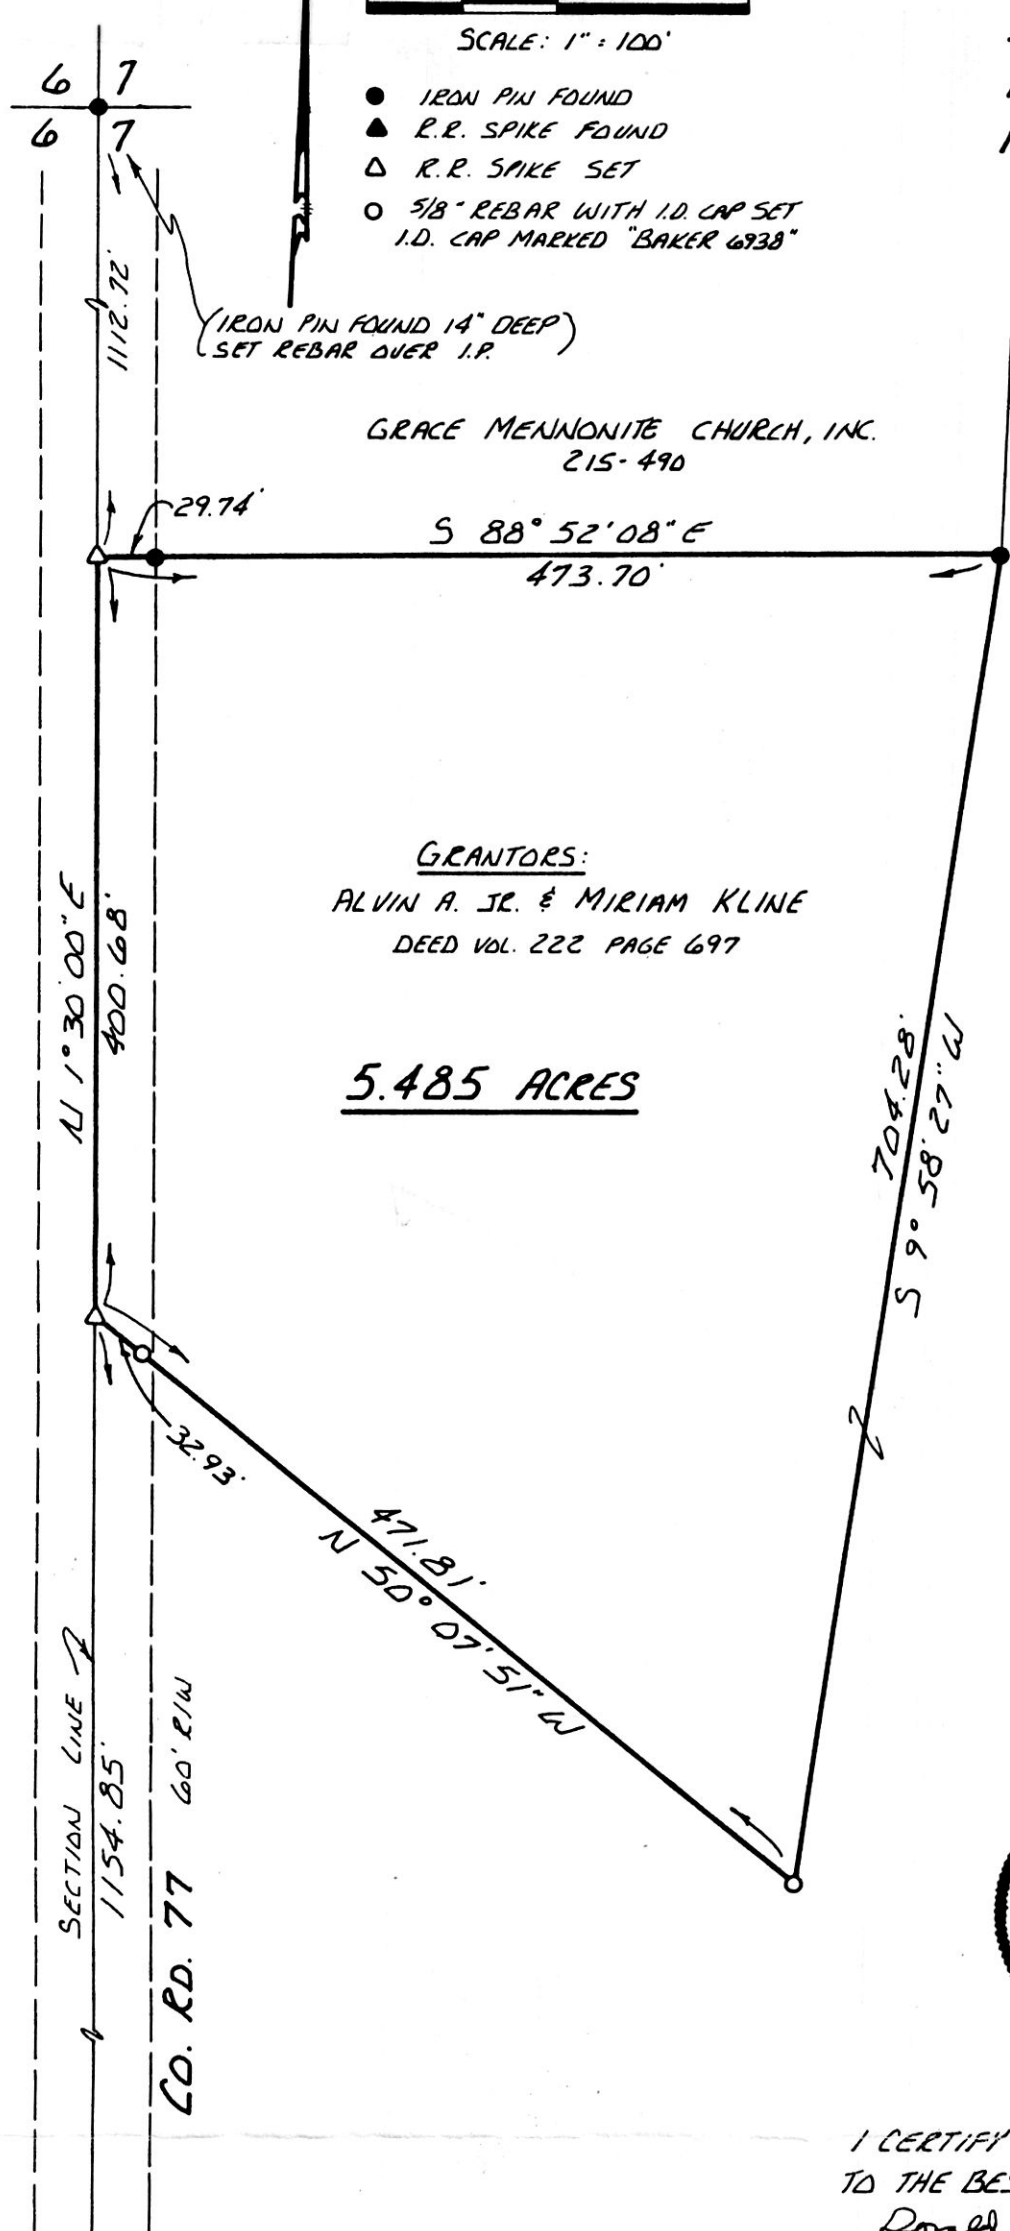

REFERENCES:

PLAT VOL. 8 PAGE 830  
BEARINGS FROM DEED  
VOL. 222 PAGE 697



I CERTIFY THIS SURVEY TO BE CORRECT  
TO THE BEST OF MY KNOWLEDGE.

Donald C. Baker  
DONALD C. BAKER P.S. 6938  
4321 TR 252  
GLENMONT, OH.

162599

6 7  
15 14

Rec'd. JAN 26 1989 AT 11:22 O'CLOCK A.M SEPT. 15, 1988  
 Recorded JAN 27 1989 Holmes Co. Ohio Fee: 5.00 Deed Vol. 242 Page 104 & 102  
 Plat Vol. 12 Pg. 140 Recorder Richard Shanen  
 Tom Lee