

- 1 Rm PIN FOUND
- 1 1/2" PIPE FOUND
- 5/8" REBAR WITH I.D. CAP SET I.D. CAP MARKED "BAKER 6938"

REFERENCES:

PLAT VOL. 4 PAGE 137
 BEARINGS FROM DEED VOL. 120
 PAGE 37B
 VARIOUS DEEDS AS SHOWN

(0.091 Ac.)

This plat not approved for any use
 that generates wastewater.


M. Kroup 3/29/89
 Sanitarian Date

SPLIT
 APPROVED
 # 890044

163355

BERLIN TOWNSHIP
 S. E. QTR. SECTION 6
 T-9N R-5W
 HOLMES COUNTY, OHIO

SURVEYED FOR DUANE MILLER

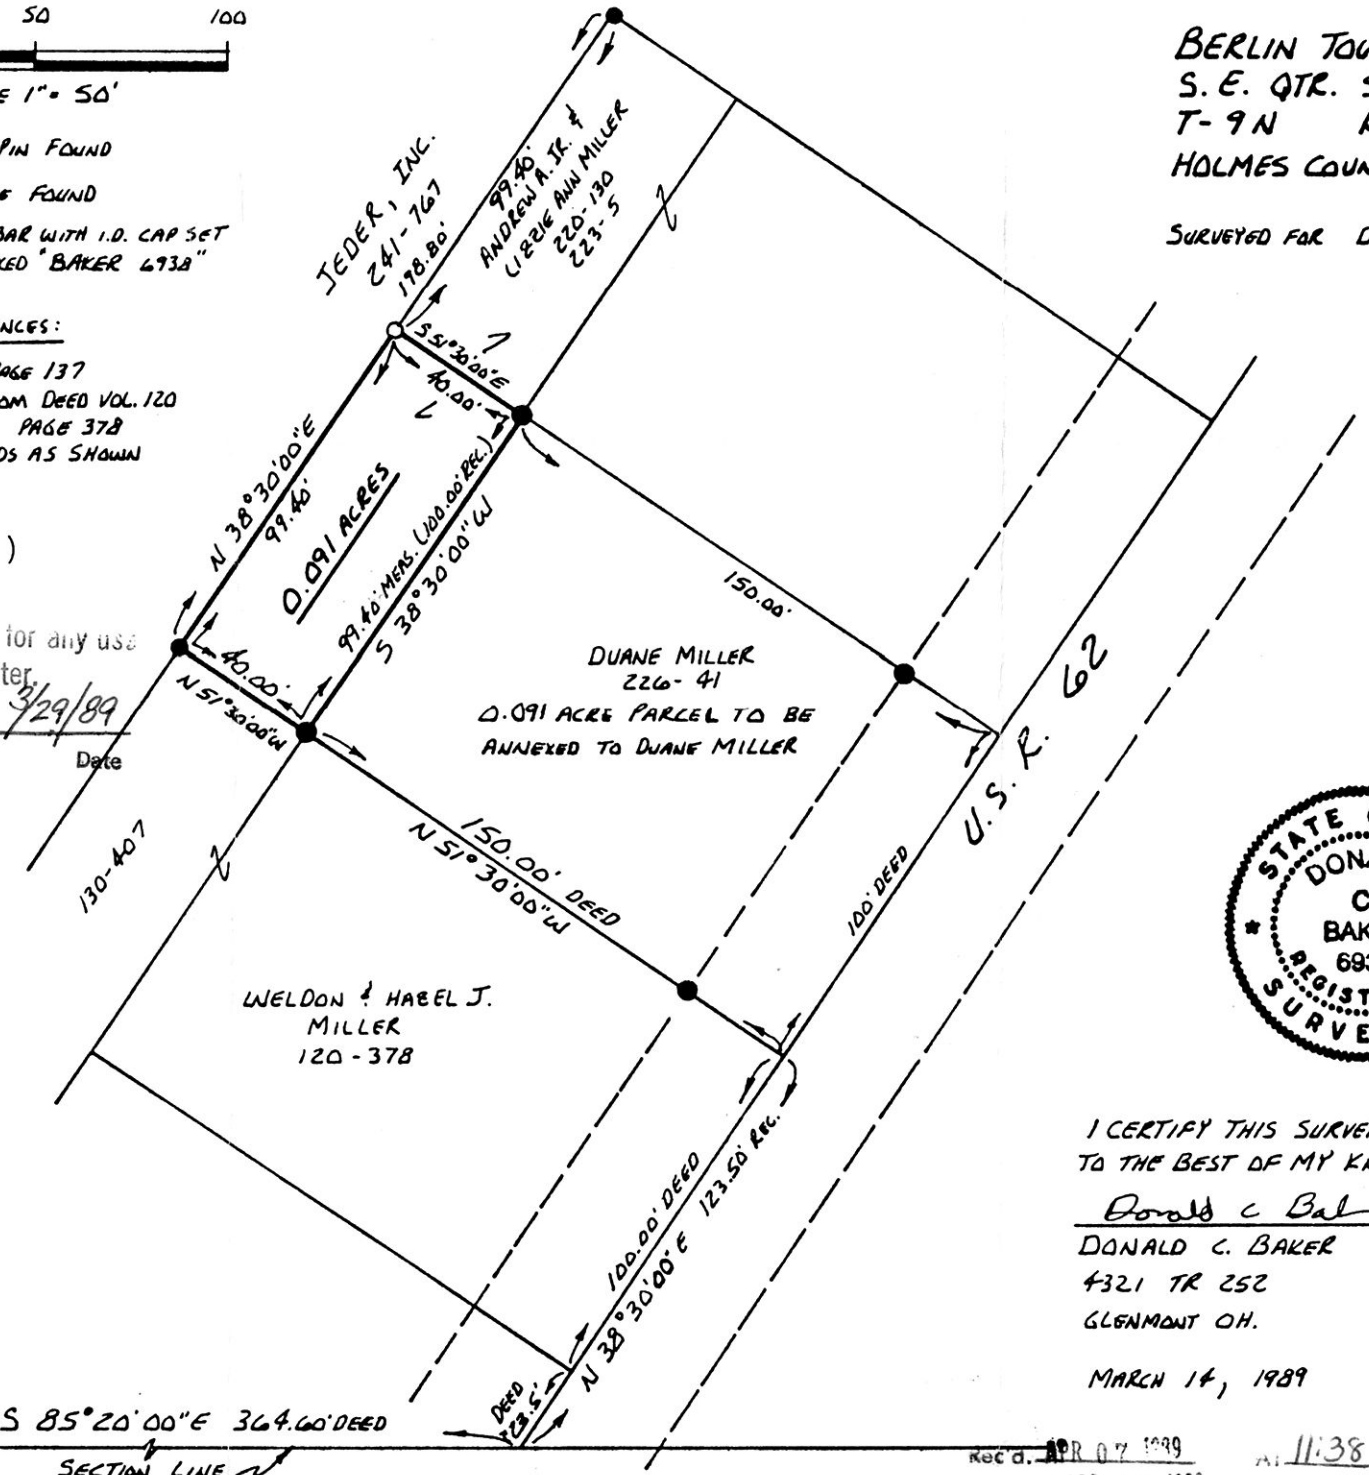

I CERTIFY THIS SURVEY TO BE CORRECT
 TO THE BEST OF MY KNOWLEDGE.

Donald C. Baker
 DONALD C. BAKER P.S. 6938
 4321 TR 252
 GLENMONT OH. 163355

MARCH 14, 1989

6 6
 15 15

S 85° 20' 00" E 364.60' DEED
 SECTION LINE

rec'd. APR 07 1989
 Recorded APR 10 1989
 Plat Vol. 12

At 11:38 O'CLOCK AM
 Holmes Co. Ohio Fee \$5.00
 Recorder *Richard Graven*